53-20

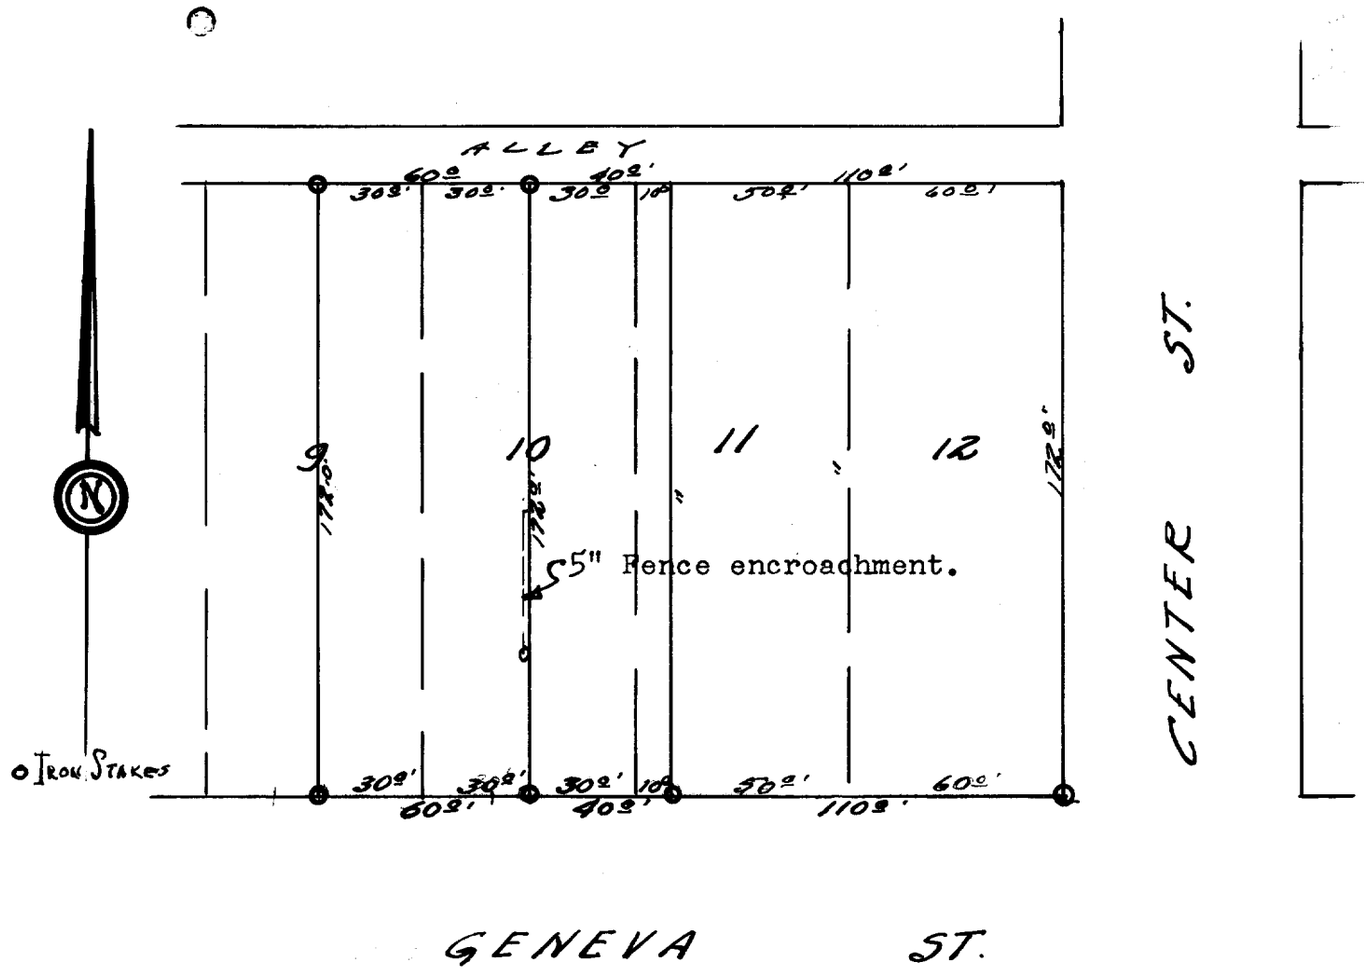

DESCRIPTION:

The East one half of Lot 9, Block 16 and the West one half of Lot 10, Block 16, Original Plat of the City of Lake Geneva Walworth County Wisconsin.

CERTIFICATE:

I, hereby certify that I have on this the 2nd day of April 1953 surveyed the above described property according tothe official records and find that an encroachment exists as shown on the above plat in the way of fence, which encroaches upon the west one half of said lot 10, by five inches.
SIGNED AND SEALED THIS 4TH DAY OF APRIL 1953

Joseph M. Biagi. Consulting Eng.
Elkhorn Wisconsin.

OP-159

7-165B