# PLAT OF SURVEY
OF

LOT 17, BLOCK 2, OF WARHURST SUBDIVISION TO LAKE GENEVA, LOCATED IN THE CITY OF LAKE GENEVA, WALWORTH COUNTY, WI.

FOR: ADOLPH GEIGER  ST. ADDRESS: 1194 CENTER ST.  SCALE 1" = 20'

⌀ = IRON PIPE FOUND.
⌘ = MASONRY NAIL SET.
△ = POWER POLE

I have surveyed the above-described property, and the map hereon is a true representation thereof and shows the size and location of the property, its exterior boundaries, the location and dimensions of all visible structures thereon, fences, apparent easements and roadways and visible encroachments, if any.


This survey is made for the exclusive use of the present owners of the property, and also those who purchase, mortgage, or guarantee the title thereto, within one year from date hereof.

Dated at Burlington, this 3RD. day, of SEPT., 1996

John F. Dogen

John F. Dogen, Land Surveyor S-242
589 N. Pine St. Burlington, WI 53105

RECEIVED
SEP 27 1996

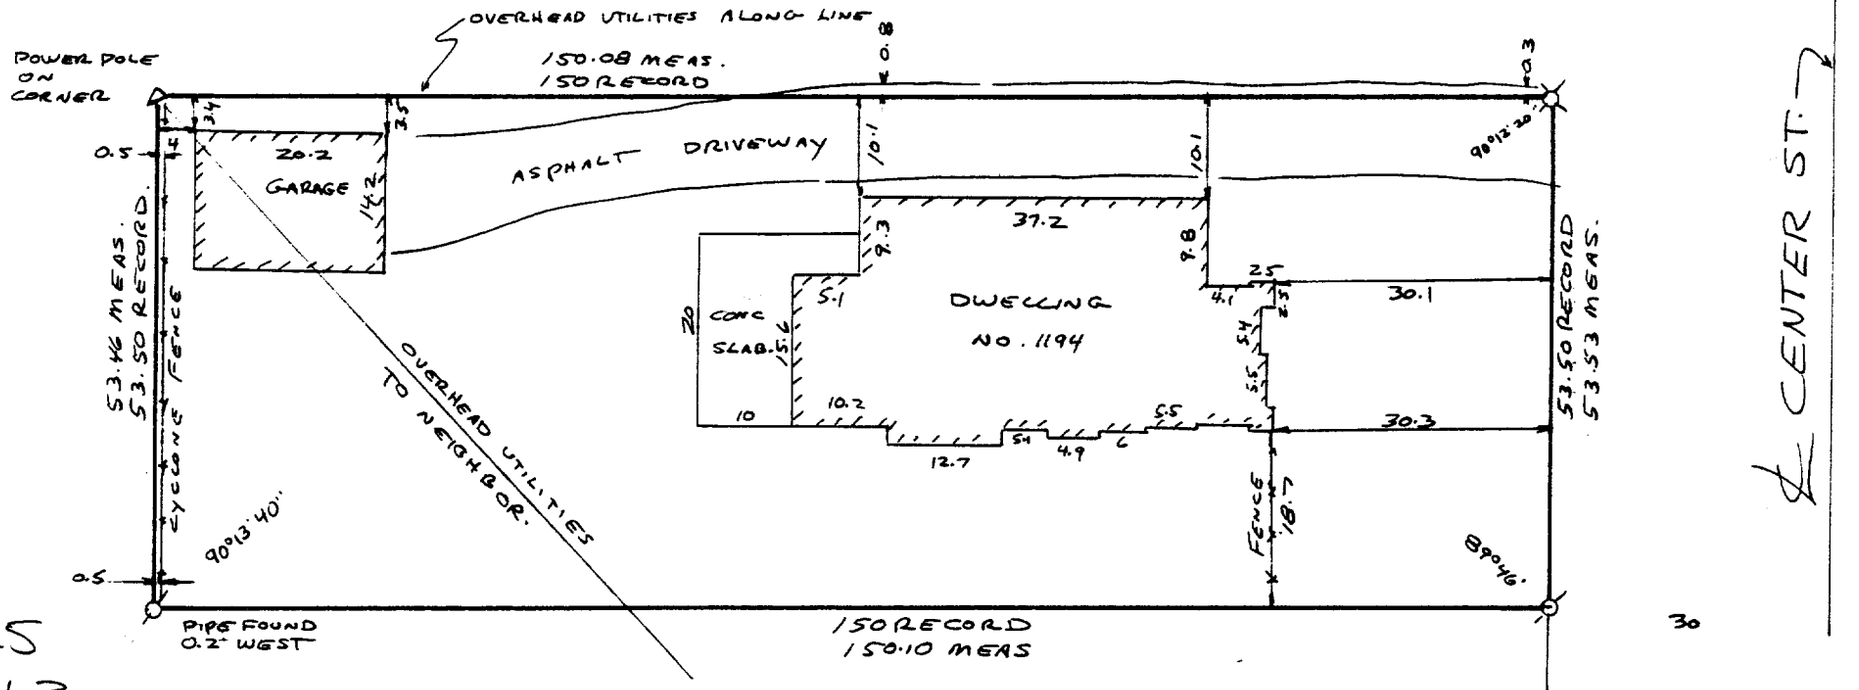


ZW-15
7-1663

30