
54-21

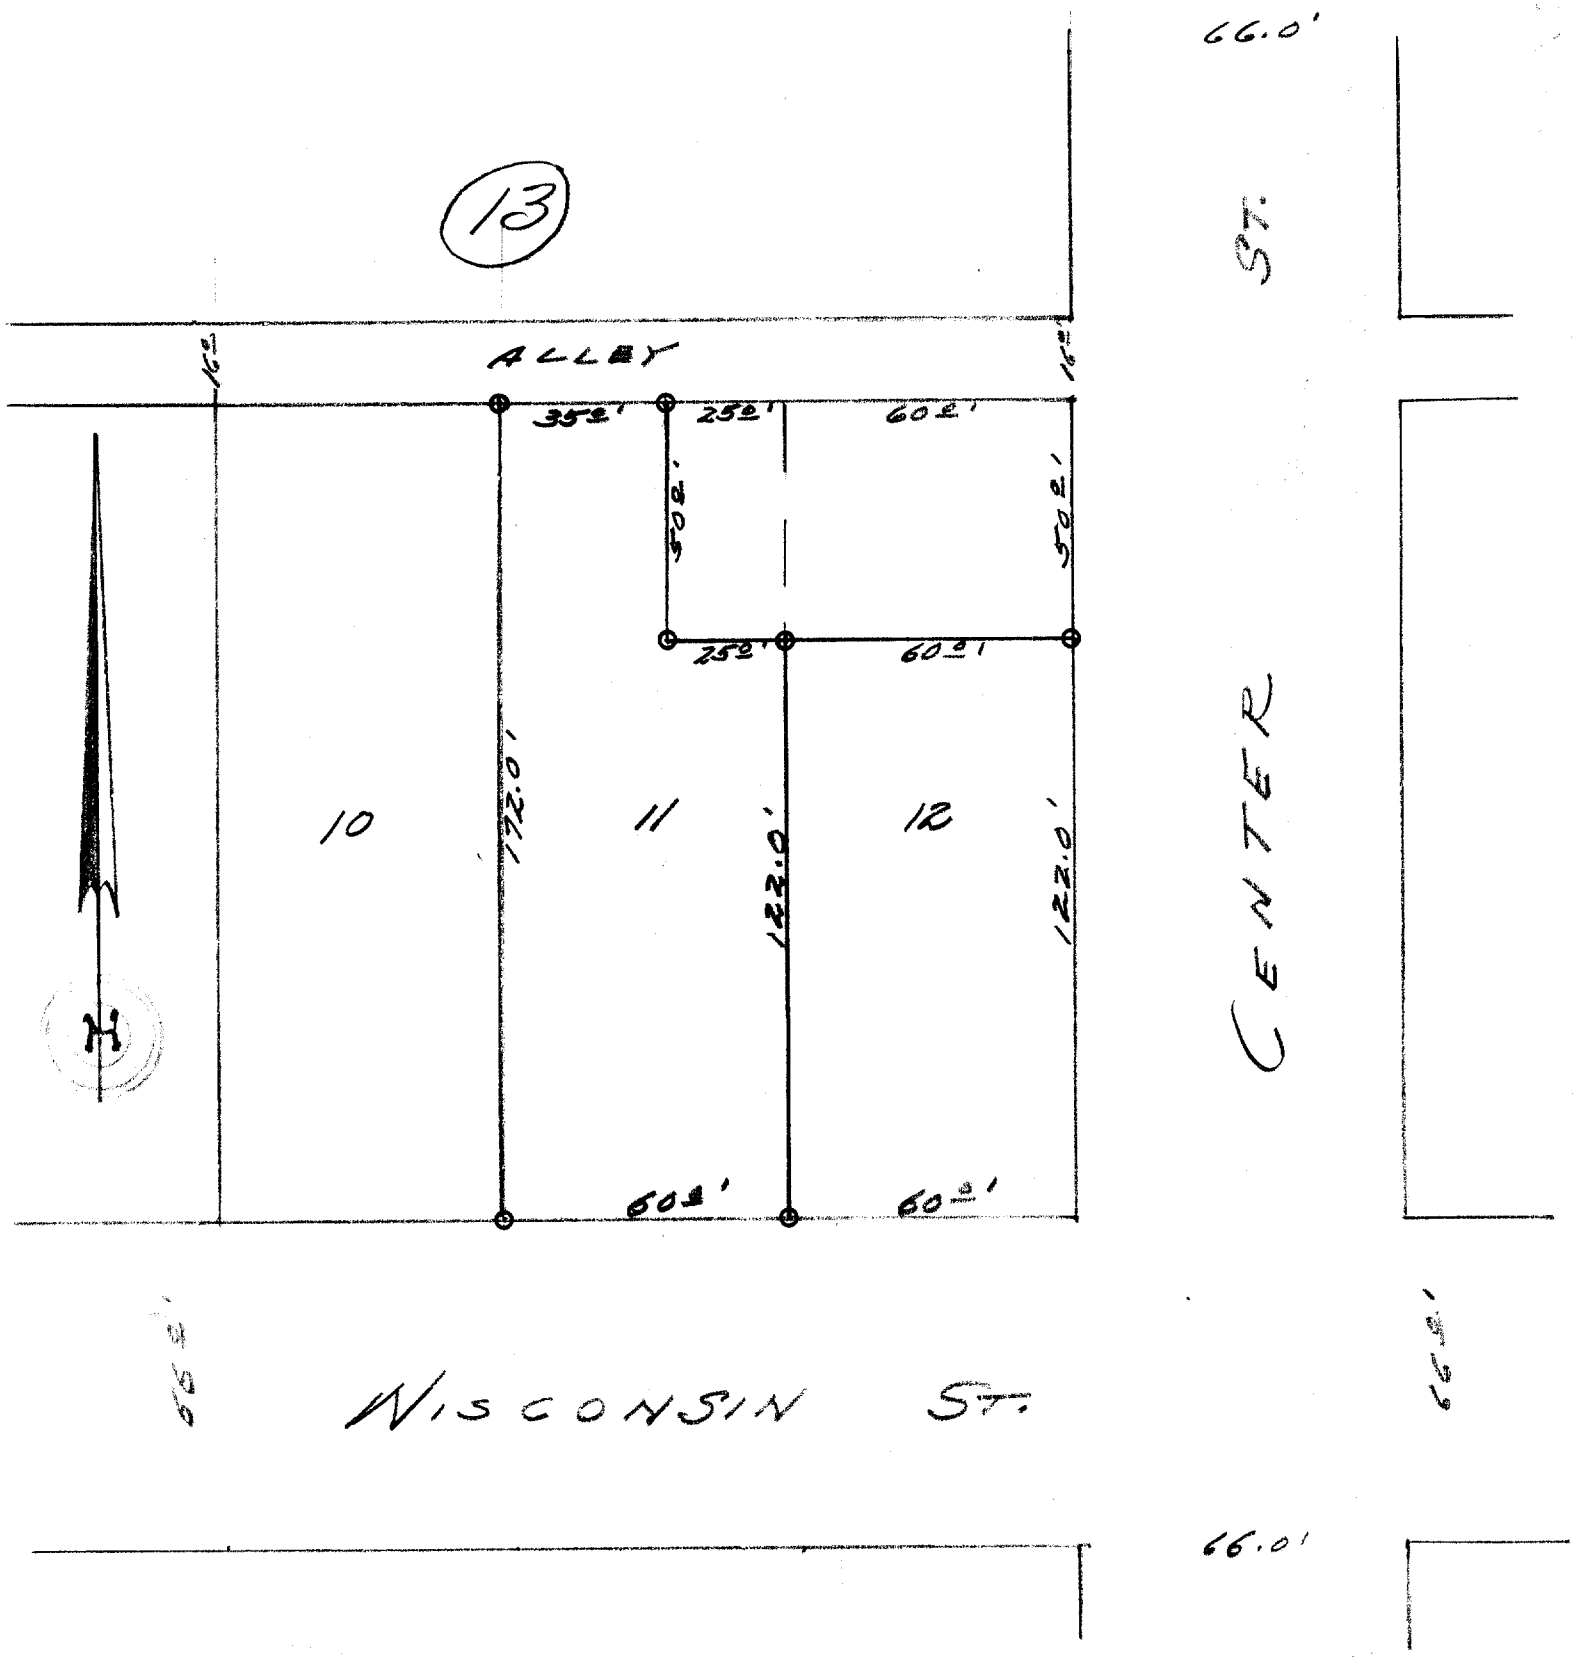

DESCRIPTION:

The South 122.0 feet of Lot 11 Block 13, Original Plat of the City of Lake Geneva, Walworth County, Wisconsin, and the West 35.0 feet of the North 50.0 feet of said Lot 11, Block 13.

CERTIFICATE:

I, Joseph M. Biagi, hereby certify that I have on this the 4th day of June 1954, surveyed the above described property according to the official records on file in the office of the Recorder of Deeds, and find that the measurements and bearings of the boundary lines of said property are substantially in agreement with those in said official record and tha no encroachments exist.
SIGNED AND SEALED ON THIS THE 7TH DAY OF 1954.

Joseph M. Biagi

Joseph M. Biagi. Professional Engineer.
Elkhorn Wisconsin

OP-119

7-167B