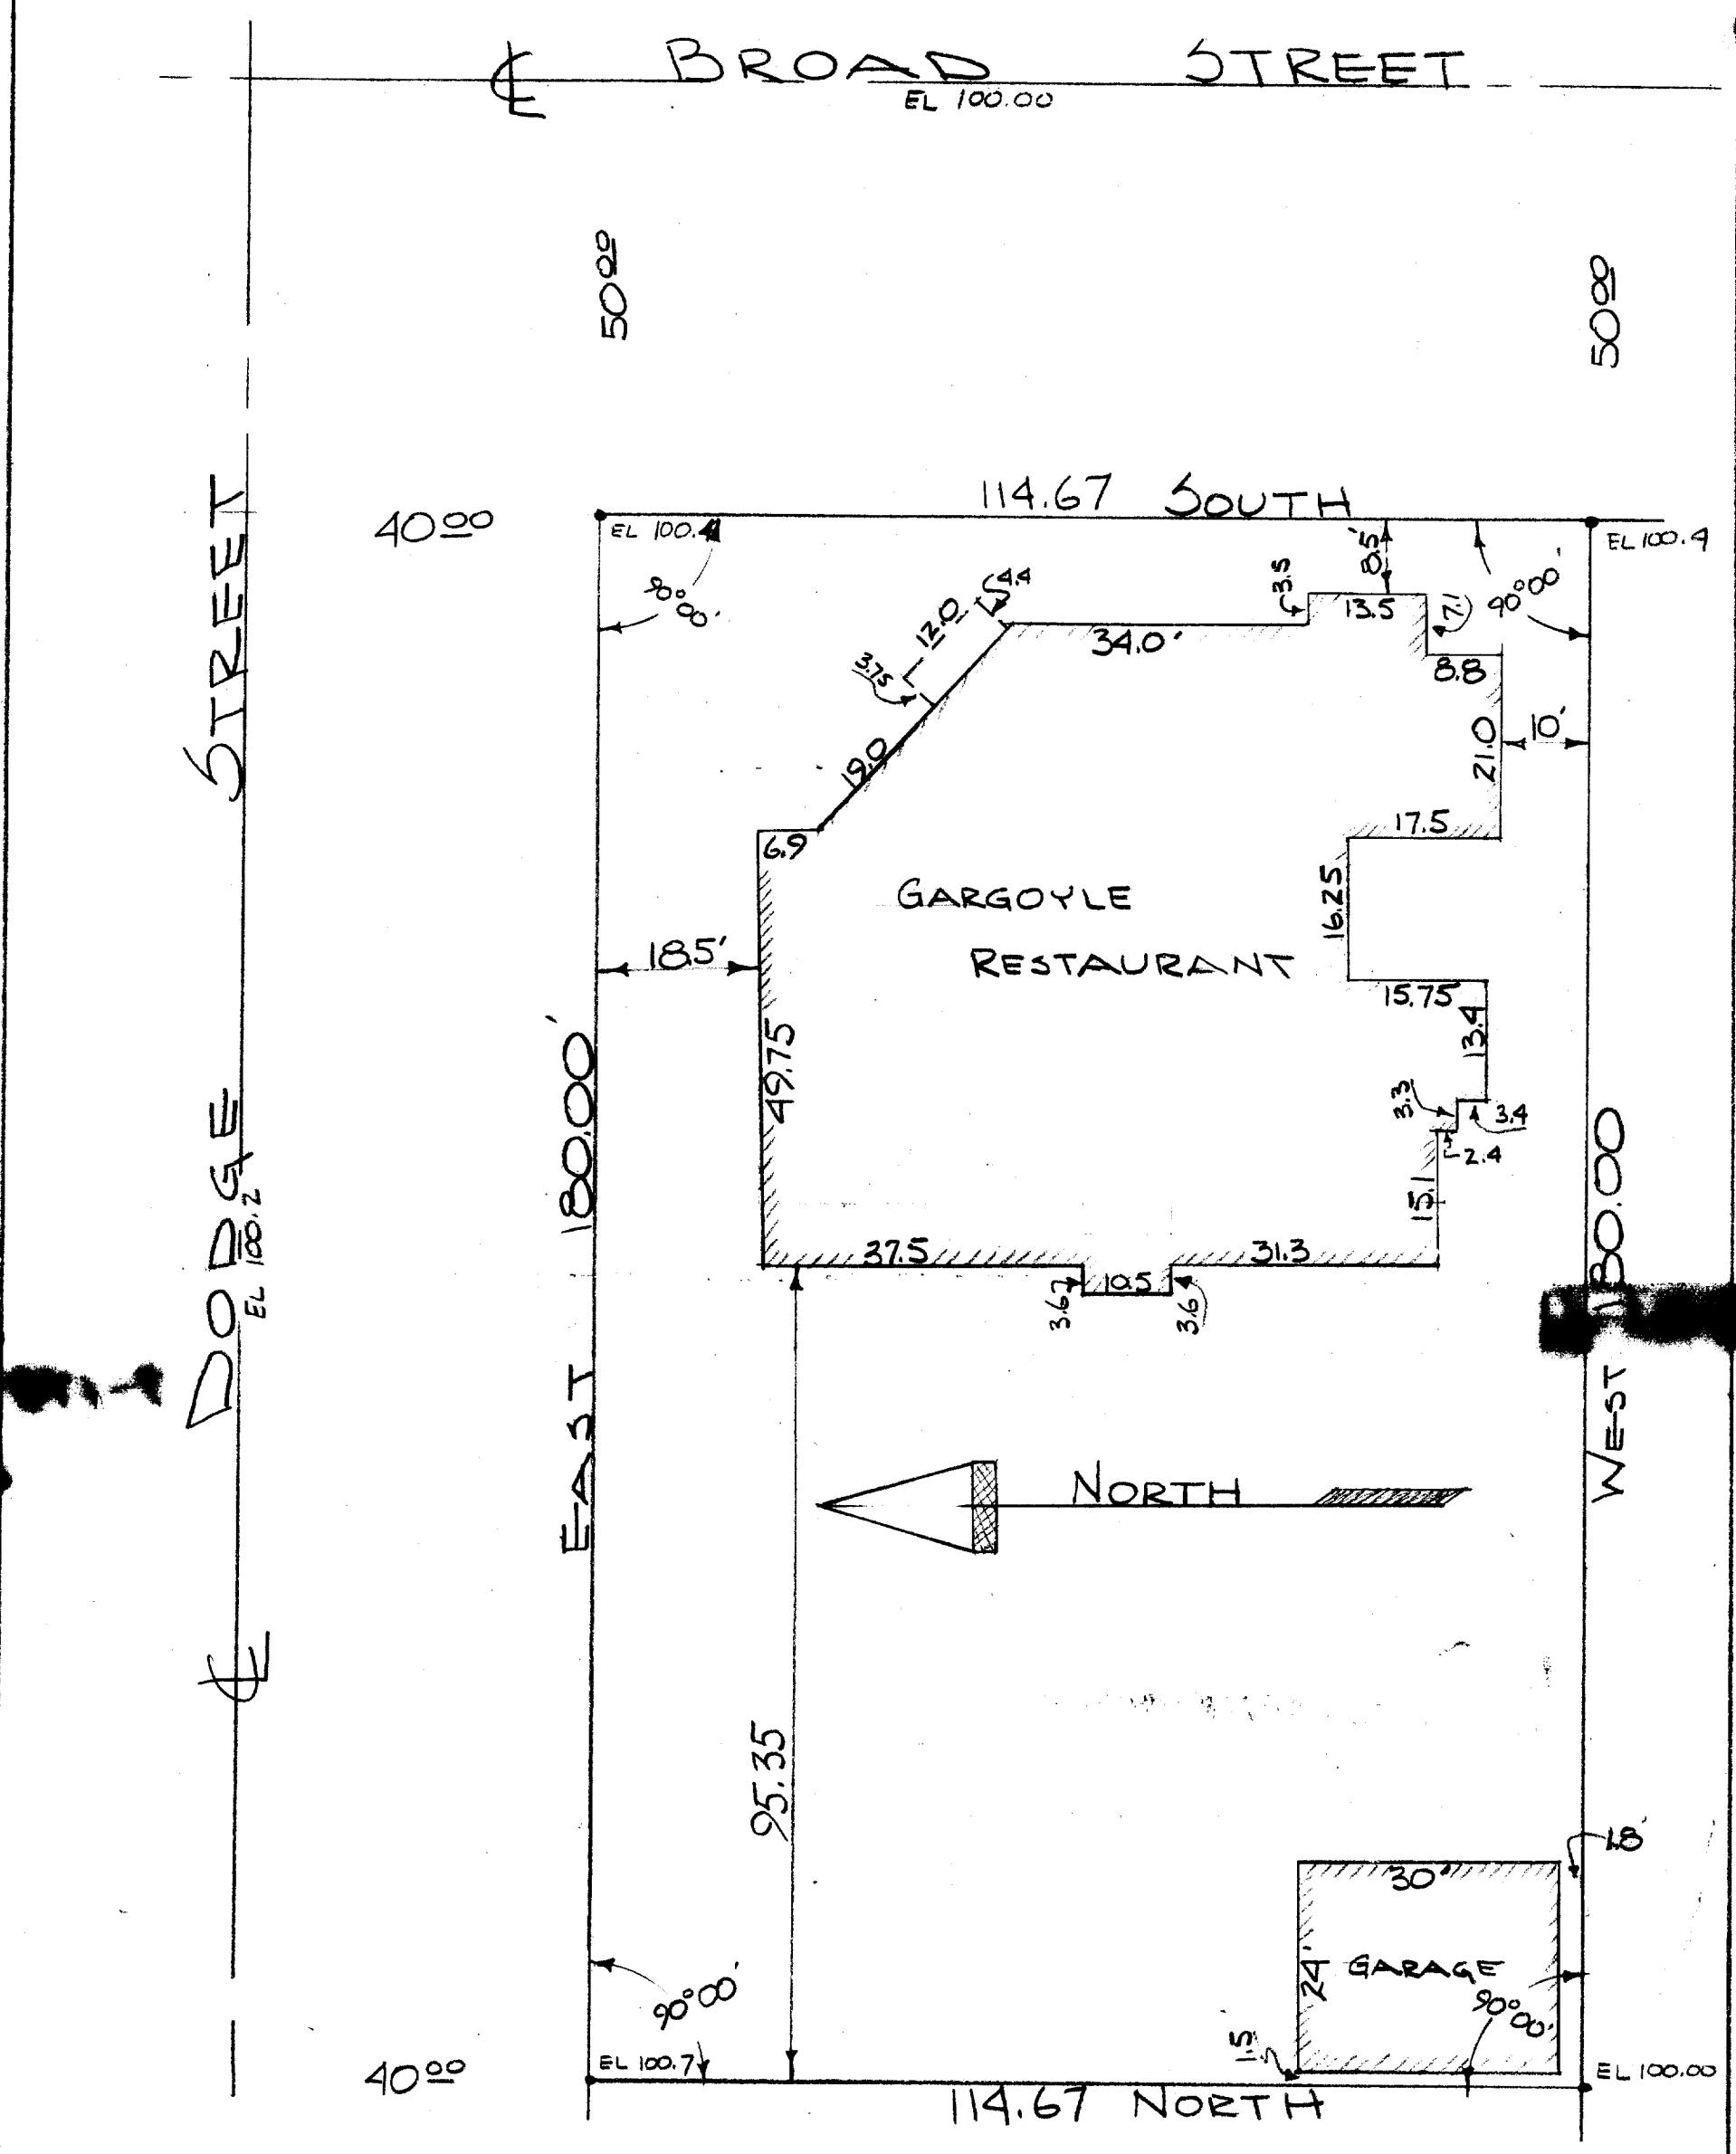


[redacted] Lots 1 & 2 (Blk 22) of Lots 1 & 2 & 3 in Block 12 of the Original Plat of the City of Lake [redacted], [redacted] County, [redacted].

CERTIFICATE: I, James F. [redacted] certify that I have surveyed the property known as [redacted] and that the plat hereon drawn is a correct representation of the same.

July 11, 1961

WISCONSIN
JAMES F. BIAGI
MILWAUKEE, WIS.
LAND SURVEYOR

James F. Biagi