#73-63

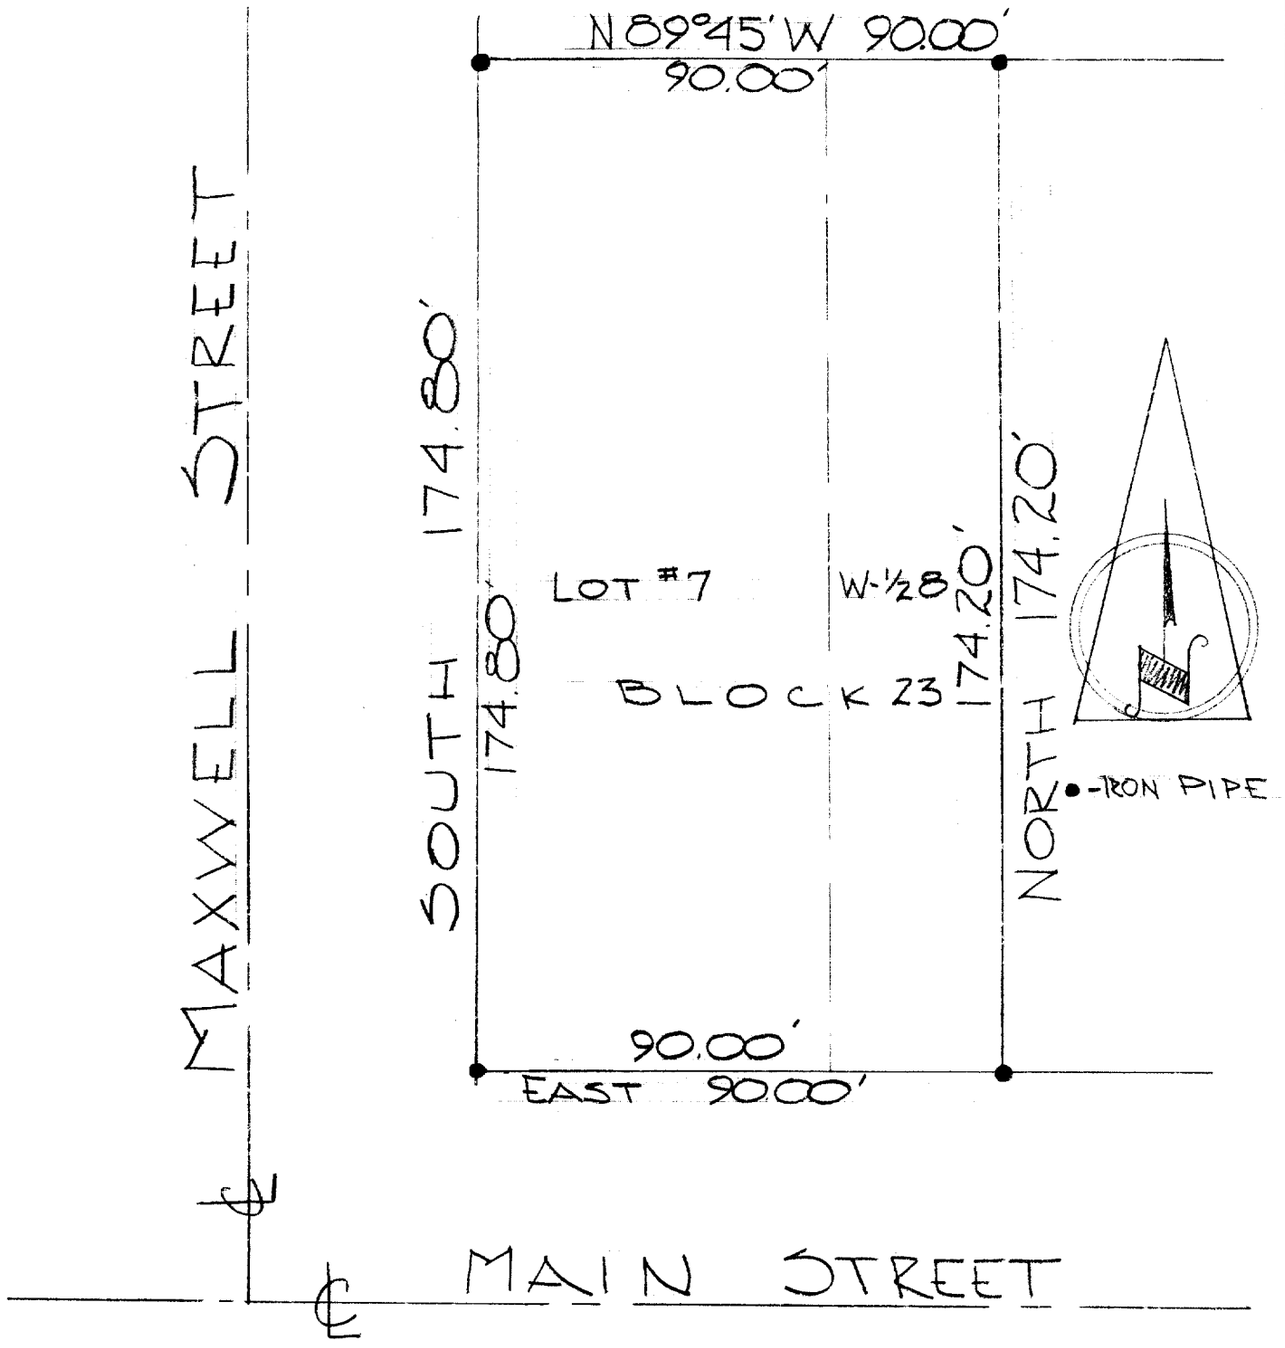

DESCRIPTION: Lot 7 and the West ½ of Lot 8 of Block 23 in the Original Plat of the City of Lake Geneva, Walworth County, Wisconsin.

CERTIFICATE: I, James F. Biagi, surveyor, do hereby certify that I have surveyed the property hereon described.

July 18, 1963.

WISCONSIN ☆ LAND SURVEYOR ☆ JAMES F. BIAGI MILWAUKEE, WIS.

James F. Biagi RLS 272

Zop-219

7-181 B