#113-65

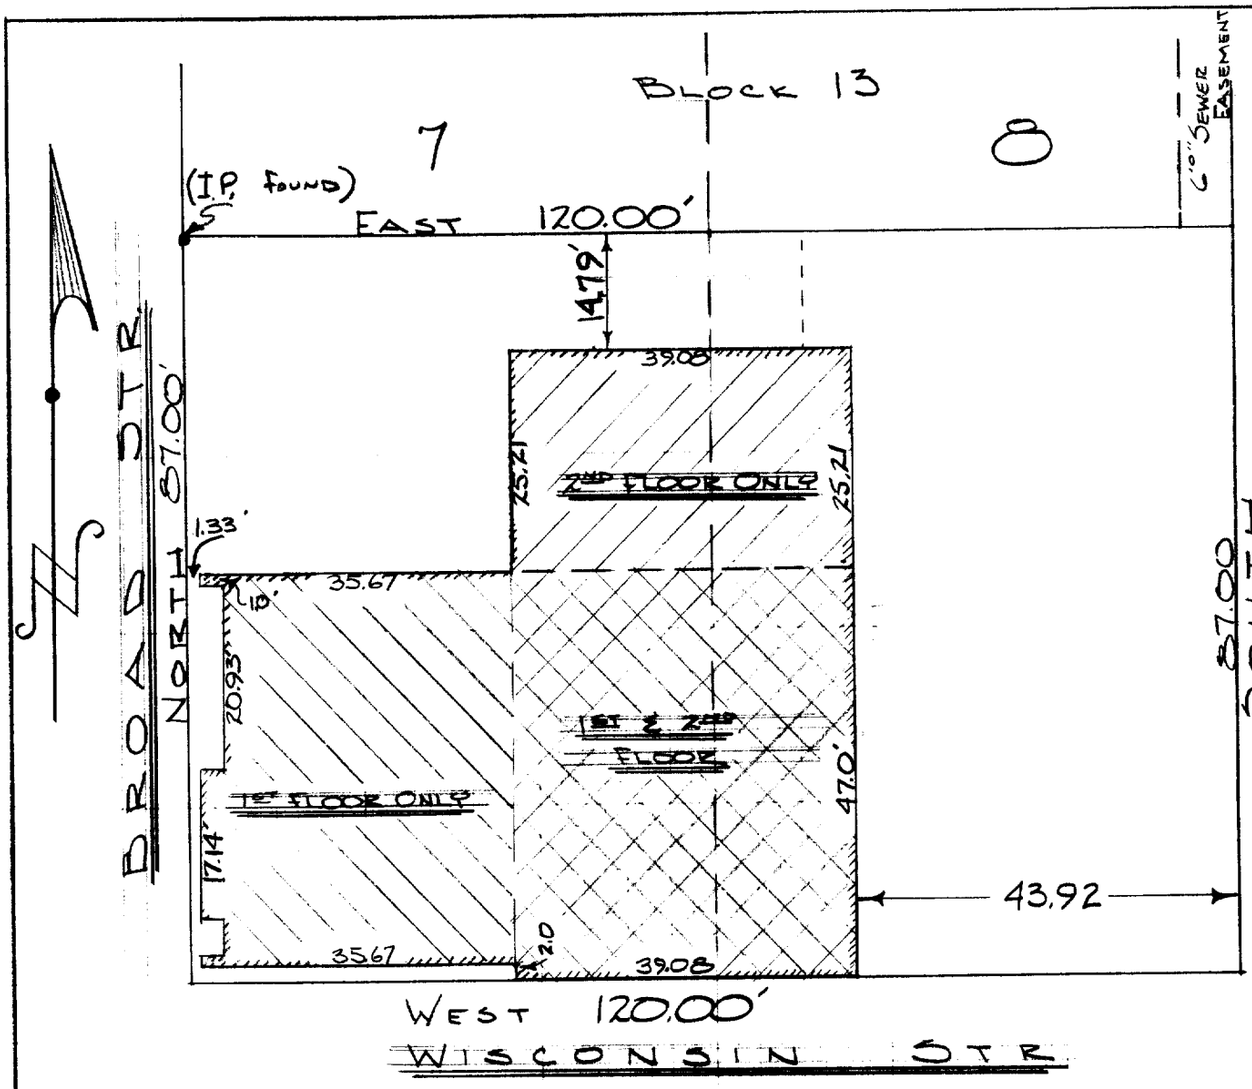

DESCRIPTION: The South $\frac{1}{2}$ (as staked) of Lots 7 and 8 of Block 13 of the Original Plat of the City of Lake Geneva, Walworth County, Wisconsin.

CERTIFICATE: I, James F. Biagi, surveyor, do hereby certify that I have surveyed the property hereon described and that the location of the improvements are as shown.

Feb. 12, 1965.

James F. Biagi RLS 272

WISCONSIN
JAMES F.
BIAGI
MILWAUKEE,
WIS.
LAND SURVEYOR

OP-117

7-182B