
#133-66

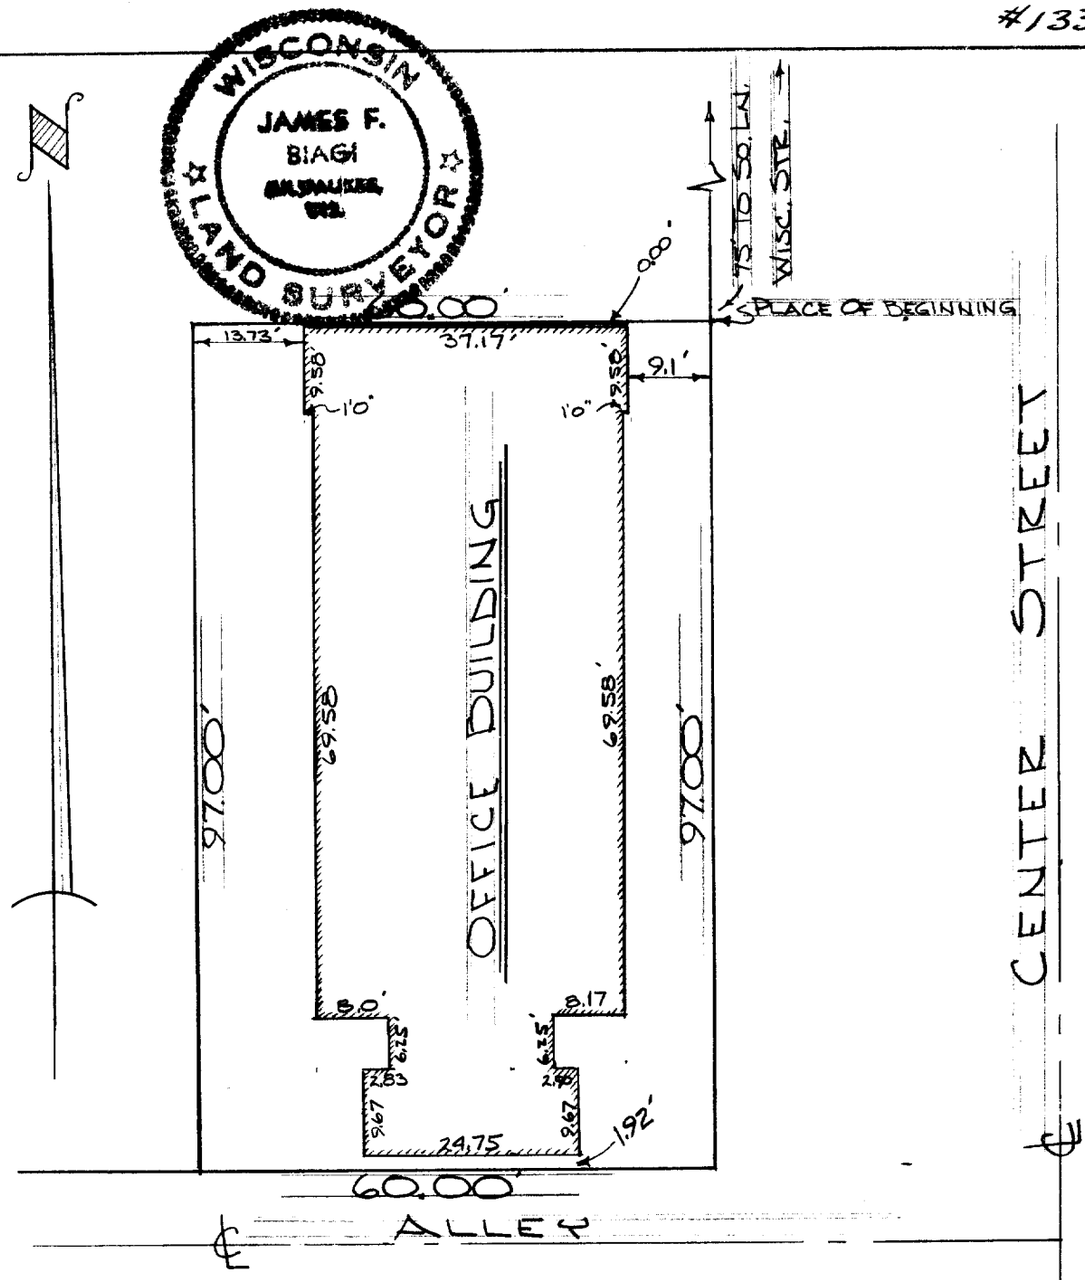


DESCRIPTION: Commencing at a point in the East line of Block 16 that is 75.00 feet South of the NE corner of said Block 16 of the Original Plat of the City of Lake Geneva, Walworth County, Wisconsin; thence continue south along the East line of said Block 97.00 feet, thence West parallel to the North line of said Block 60.00 feet, thence North parallel to the East line of said Block 97.00 feet, thence East parallel to the North line of said Block 60.00 feet to the place of beginning.

CERTIFICATE: I, James F. Biagi, surveyor do hereby certify that I have surveyed the property hereon described and that the location of the improvements are as shown.

August 23, 1966.

James F. Biagi

James F. Biagi RLS 272

OP-150

7-183B