
#80-67

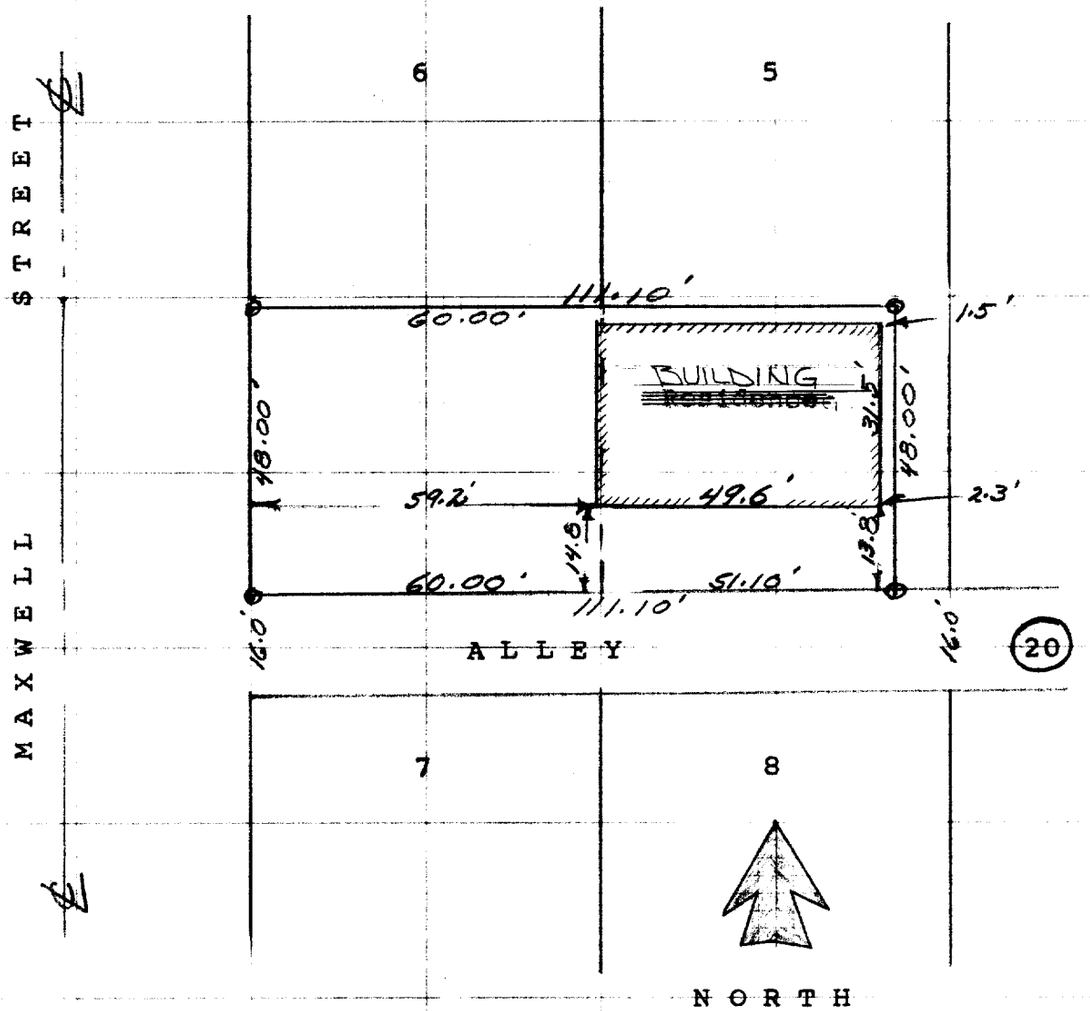

● Iron Pipe

DESCRIPTION: The South 48 feet of Lot 6 and the South 48 feet ~~of the West 51.1 feet of Lot 5 of Block 20 of the~~ Original Plat of the City of Lake Geneva, Walworth County, Wisconsin.

CERTIFICATE: I, James F. Biagi, surveyor do hereby certify that I have surveyed the ~~property~~ hereon described, on ~~this the 26th day of May, 1967.~~

James F. Biagi

James F. Biagi. RLS 272
Elkhorn, Wisconsin.

Date: May 27th 1967

WISCONSIN
JAMES F.
BIAGI
LAND SURVEYOR

CP-190A

7-187B