
WALWORTH COUNTY
SURVEYING & MAPPING
P. O. BOX 1115
LAKE GENEVA, WISCONSIN 53147
414-248-0505

RECEIVED
2001

# PLAT OF SURVEY OF

LOTS 8 AND 9, BLOCK 21, IN MAP OF LAKE GENEVA MANOR TRACT NO. 17, BEING A SUBDIVISION IN THE EAST ONE-HALF OF SECTION 35, IN TOWNSHIP 2 NORTH, RANGE 17 EAST, IN THE CITY OF LAKE GENEVA, WALWORTH COUNTY, WISCONSIN.

ORDERED BY: KEEFE REAL ESTATE
751 GENEVA PARKWAY
LAKE GENEVA, WISCONSIN
53147

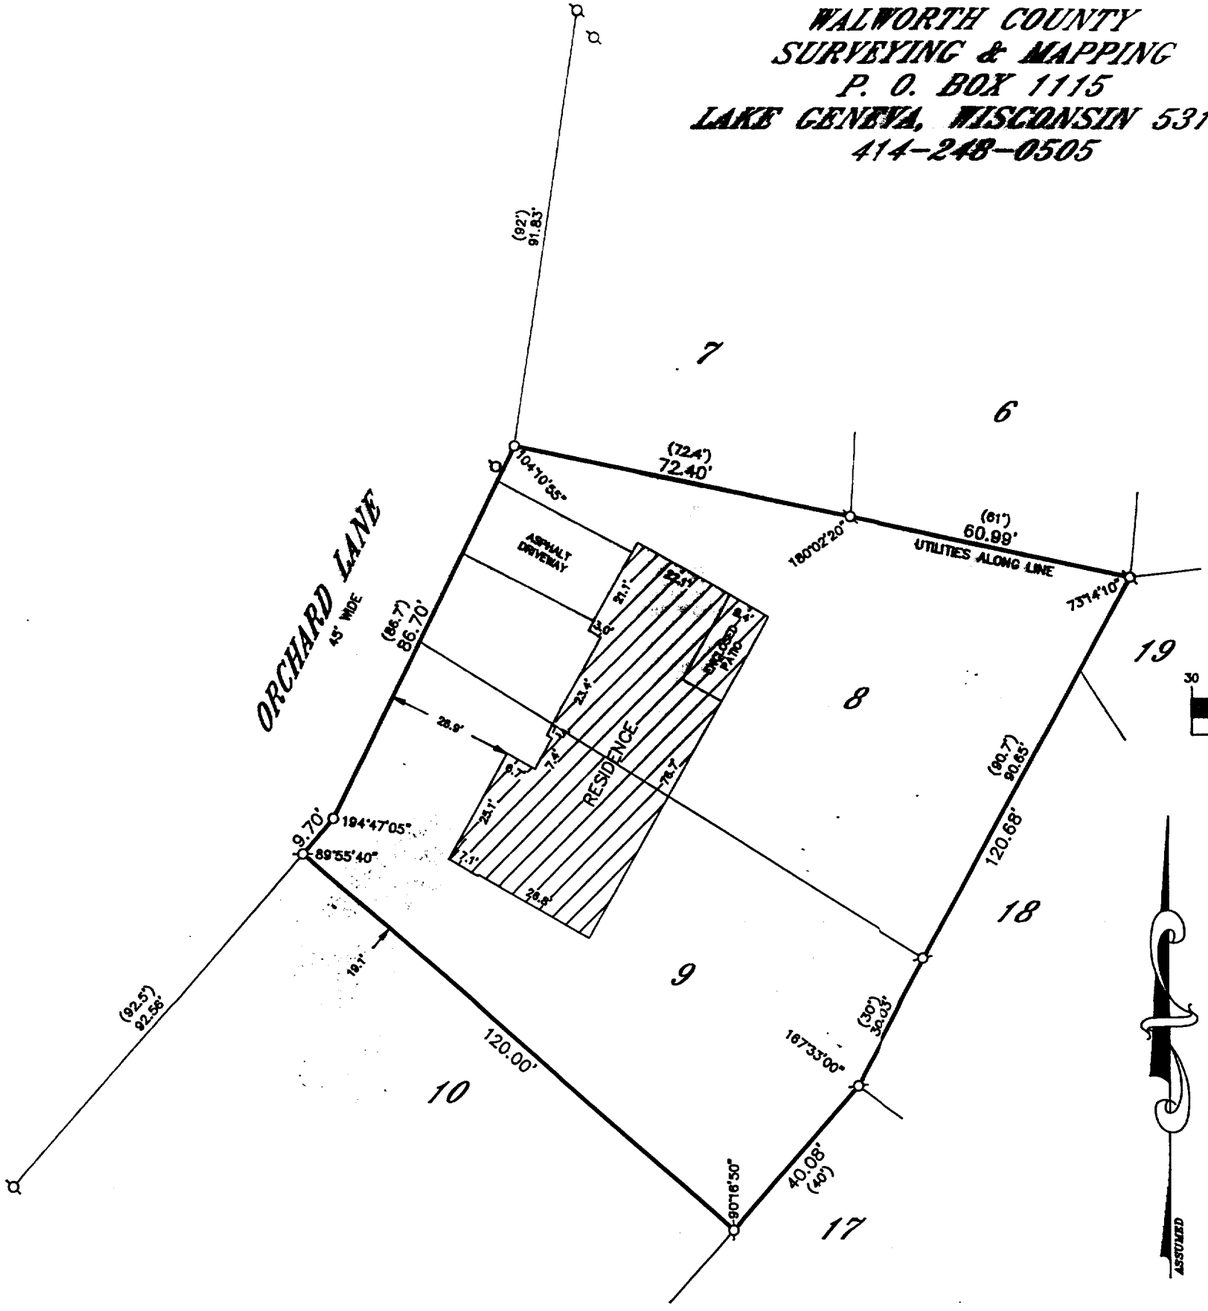


## GRAPHIC SCALE

30 0 15 30 60 120

( IN FEET )
1 inch = 30 ft.

ø—IRON PIPE FOUND
ø—IRON ROD FOUND
■—CONCRETE MONUMENT FOUND
o—IRON PIPE PLACED
()—RECORDED AS

I HEREBY CERTIFY THAT I HAVE SURVEYED THE ABOVE DESCRIBED PROPERTY AND THAT THE ABOVE MAP IS A TRUE REPRESENTATION THEREOF AND SHOWS THE SIZE AND LOCATION OF THE PROPERTY, ITS EXTERIOR BOUNDARIES, THE LOCATION OF ALL VISIBLE STRUCTURES AND DIMENSIONS OF ALL PRINCIPAL BUILDINGS THEREON, BOUNDARY FENCES, APPARENT EASEMENTS, ROADWAYS AND VISIBLE ENCROACHMENTS, IF ANY, TO THE BEST OF MY KNOWLEDGE AND BELIEF.

THIS SURVEY IS MADE FOR THE USE OF THE PRESENT OWNERS OF THE PROPERTY AND ALSO THOSE WHO PURCHASE, MORTGAGE OR GUARANTEE THE TITLE THERETO WITHIN ONE (1) YEAR FROM DATE HEREOF.

Robert M. Baerenwald

ROBERT M. BAERENWALD
WISCONSIN REGISTERED LAND SURVEYOR, S-1508

March 10, 1998
DATE

JOB NO. 5737

NOTE: THIS IS NOT A CERTIFIED COPY UNLESS SEALED.

ZLM-58 007-1947