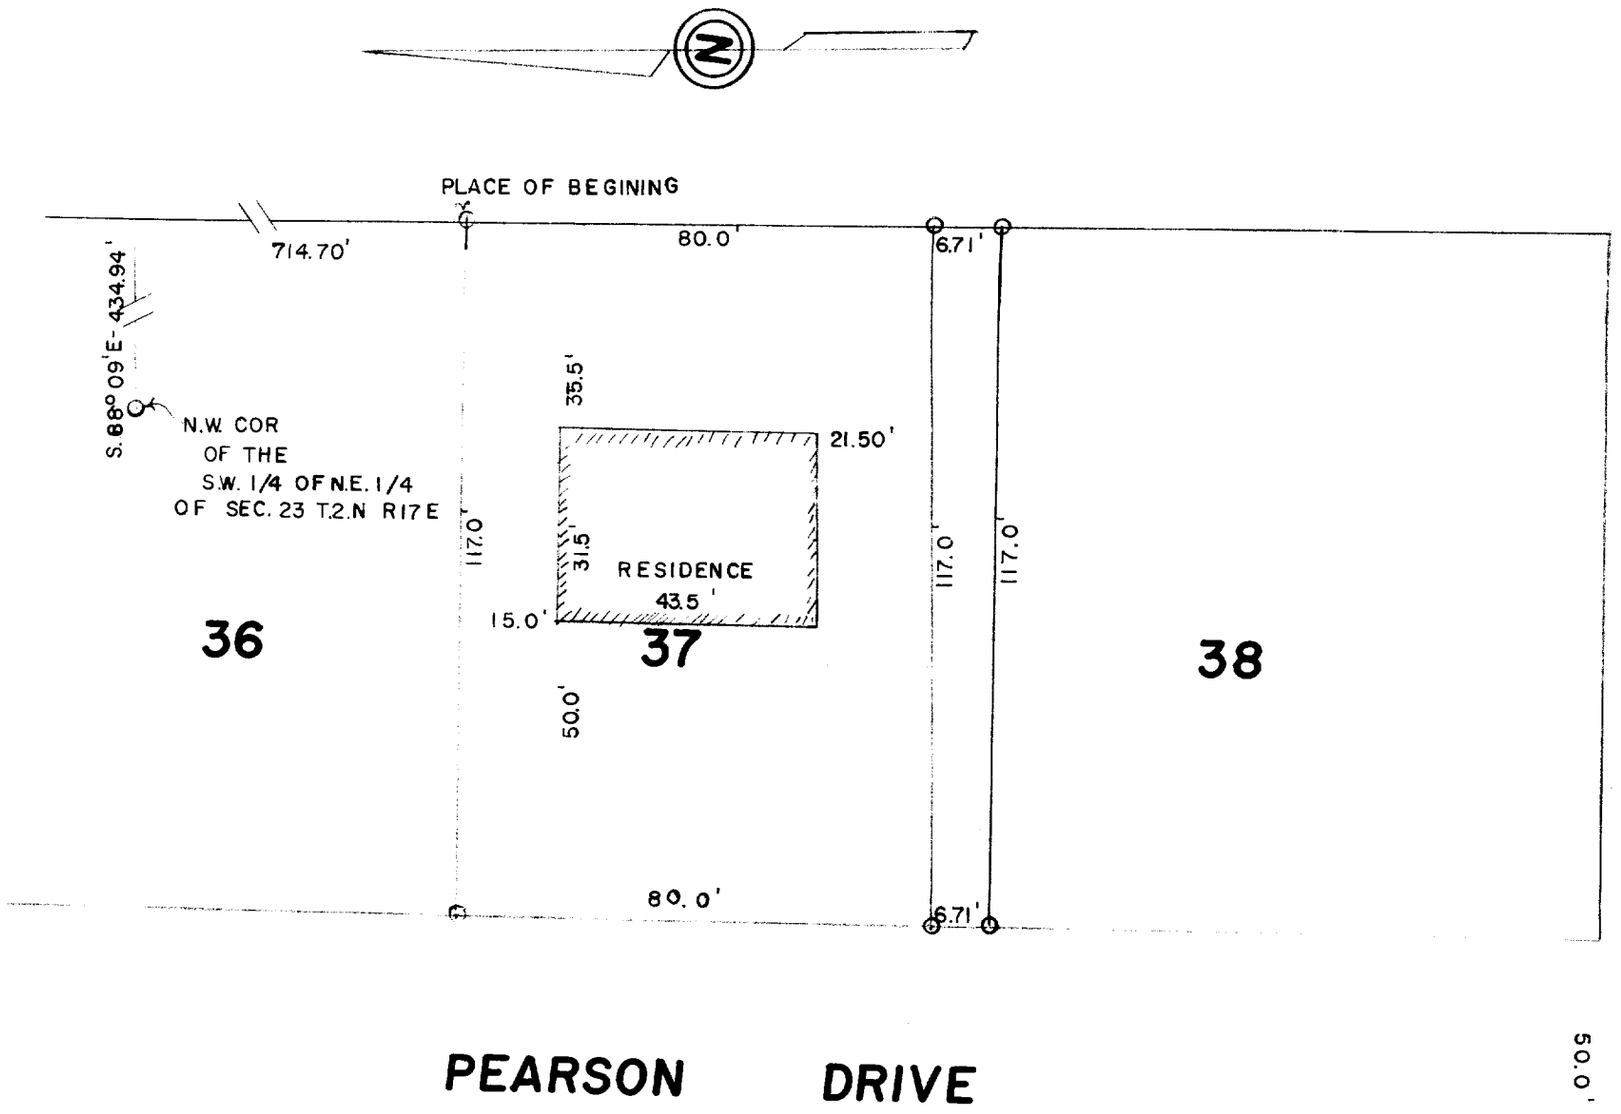

N
PLACE OF BEGINING
714.70'
80.0'
6.71'
S. 88° 09' E- 434.94'
N.W. COR
OF THE
S.W. 1/4 OF N.E. 1/4
OF SEC. 23 T.2.N R17E
35.5'
21.50'
117.0'
31.5'
RESIDENCE
43.5'
15.0'
117.0'
117.0'
36
37
38
50.0'
80.0'
6.71'
PEARSON DRIVE
50.0'

P-37