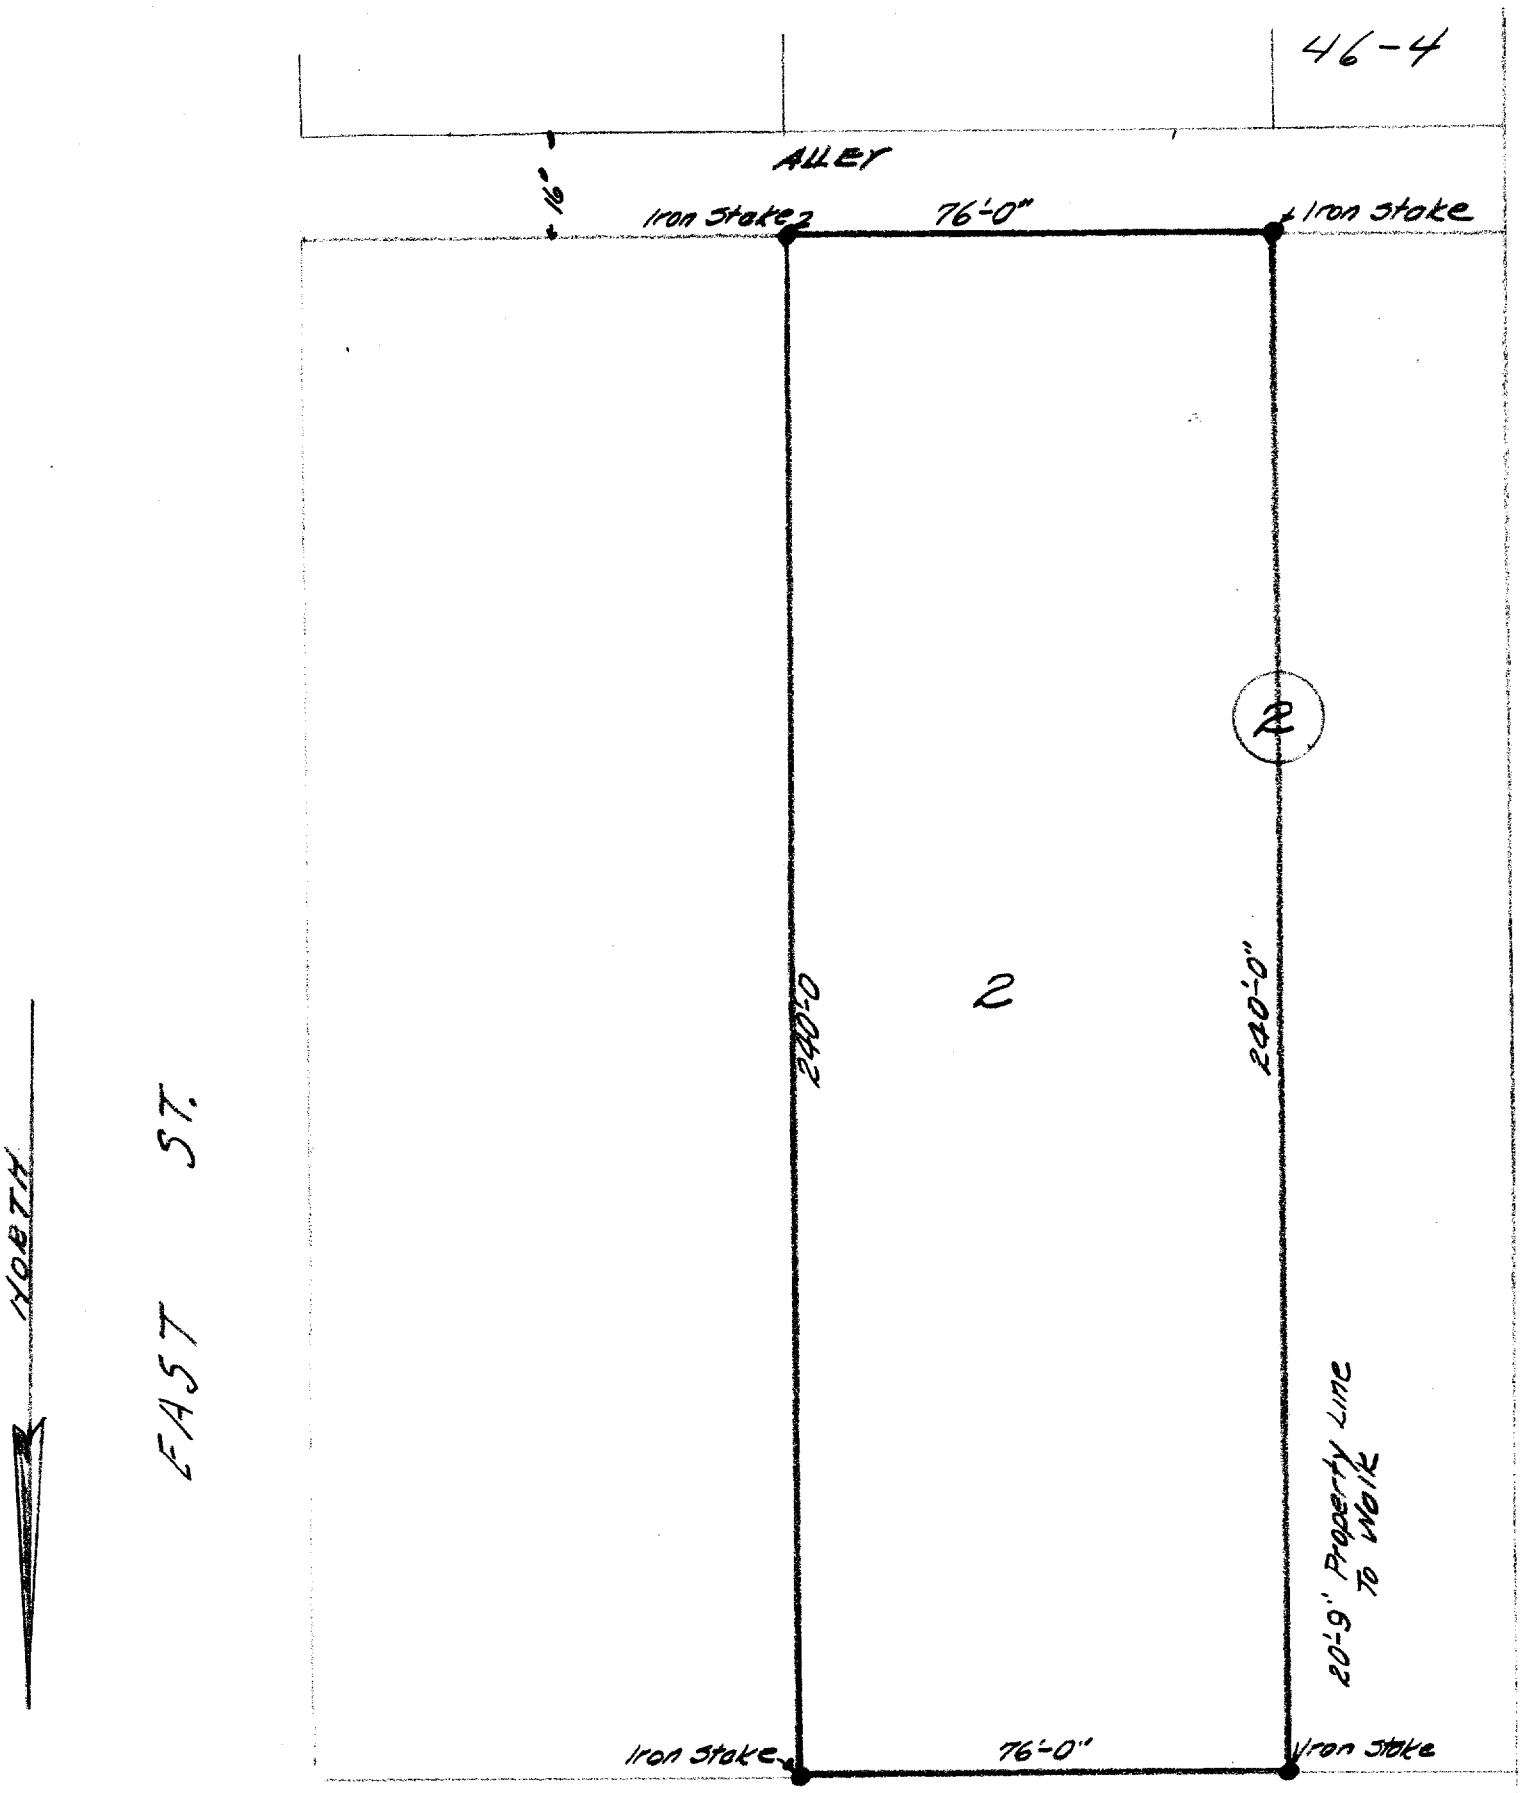


DESCRIPTION:

Lot 2, Block 2, E. D. Phillip's Subdivision of a portion of the City of Lake Geneva, Walworth County, Wisconsin.

CERTIFICATE:

I, hereby certify that I have on this the 23rd day of March, 1946, surveyed the above described property according to the official records on file in the office of the Recorder of Deeds in and for Walworth County, Wisconsin, and find that the measurements and bearings of the boundary lines of said property as taken on this day, substantially agree with those in the above description and that no encroachments exist.
SIGNED AND SEALED THIS 25TH DAY OF MARCH 1946.

Joseph M. Biagi.

Joseph M. Biagi. Professional Engineer.
Elkhorn Wisconsin.

PI - 8 + Cert Sur. 856

7-1961B