


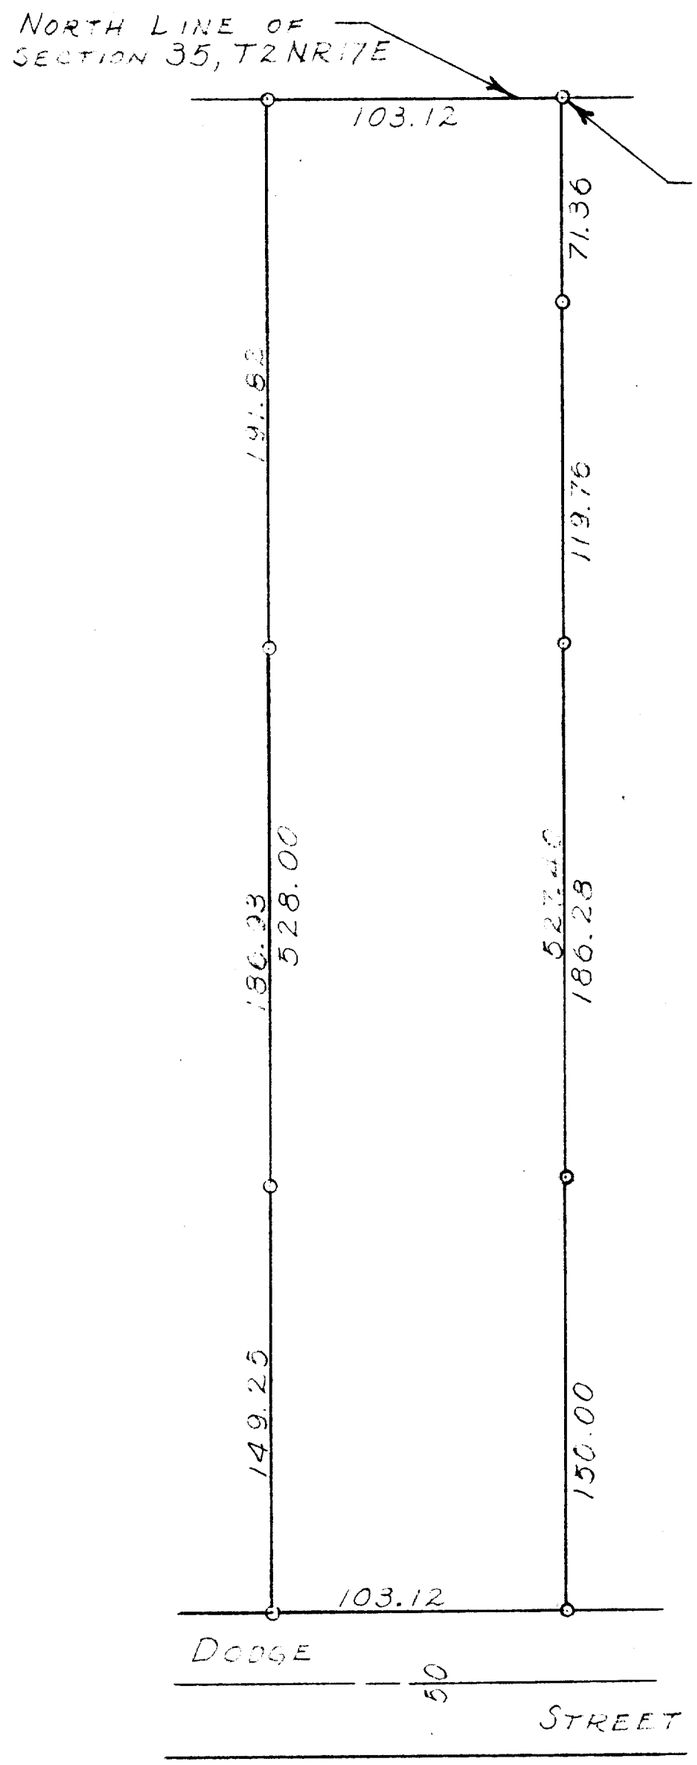

SCALE ~ 1" = 50'
O ~ IRON PIPE

PLAT OF SURVEY OF A PARCEL OF LAND LOCATED IN THE NORTHEAST 1/4 OF SECTION 35, T2NR17E, WALWORTH COUNTY, WISCONSIN,
JUNE 26, 1957

GEORGE T. DUNHAM, SURVEYOR
DELAVAN, WISCONSIN

UP-54

7-19D