
LEGEND:
⊙ — IRON PIPE FOUND
SCALE 1"=30'

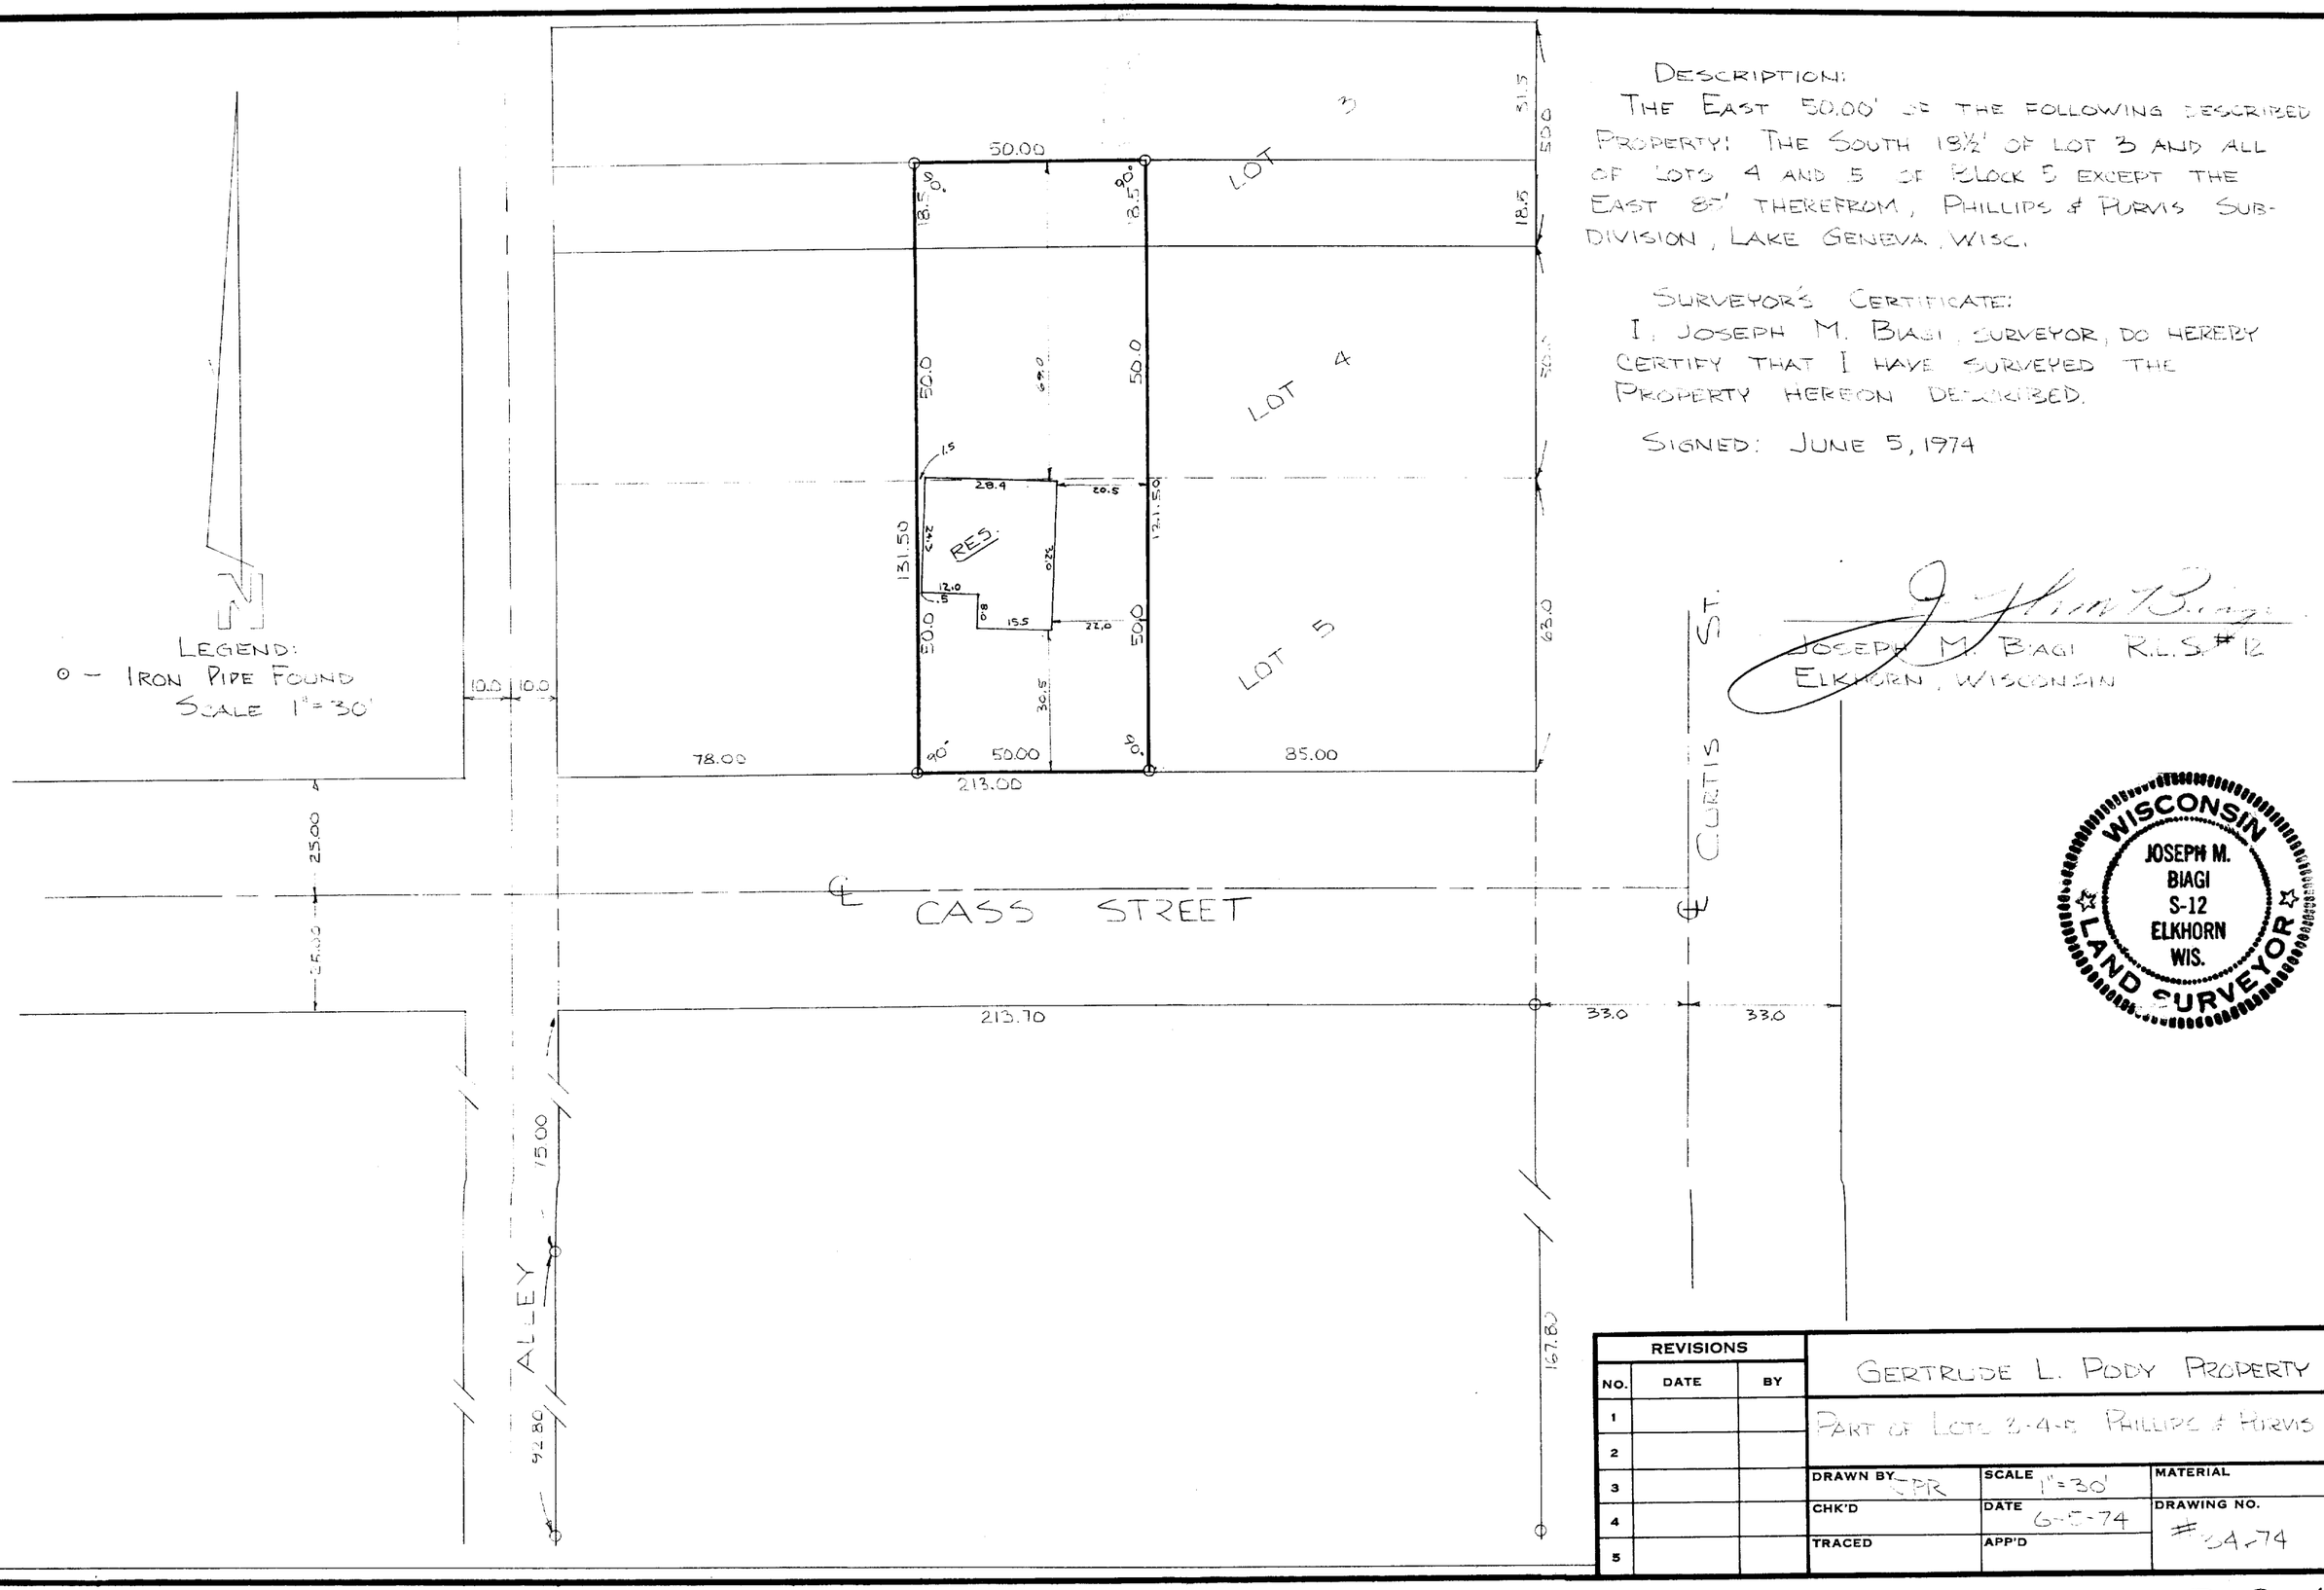

DESCRIPTION:
THE EAST 50.00' OF THE FOLLOWING DESCRIBED PROPERTY: THE SOUTH 18½' OF LOT 3 AND ALL OF LOTS 4 AND 5 OF BLOCK 5 EXCEPT THE EAST 85' THEREFROM, PHILLIPS & PURVIS SUBDIVISION, LAKE GENEVA, WISC.

SURVEYOR'S CERTIFICATE:
I, JOSEPH M. BIAGI, SURVEYOR, DO HEREBY CERTIFY THAT I HAVE SURVEYED THE PROPERTY HEREON DESCRIBED.

SIGNED: JUNE 5, 1974

JOSEPH M. BIAGI R.L.S. #12
ELKHORN, WISCONSIN

WISCONSIN
JOSEPH M.
BIAGI
S-12
ELKHORN
WIS.
LAND SURVEYOR

REVISIONS		
NO.	DATE	BY
1		
2		
3		
4		
5		

GERTRUDE L. PODY PROPERTY

PART OF LOTS 3-4-5 PHILLIPS & PURVIS

DRAWN BY PR	SCALE 1"=30'	MATERIAL
CHK'D	DATE 6-5-74	DRAWING NO. #34-74
TRACED	APP'D	

#34-74

TELEDYNE POST 18AE-10E—12X18 PP-1C

7-201B