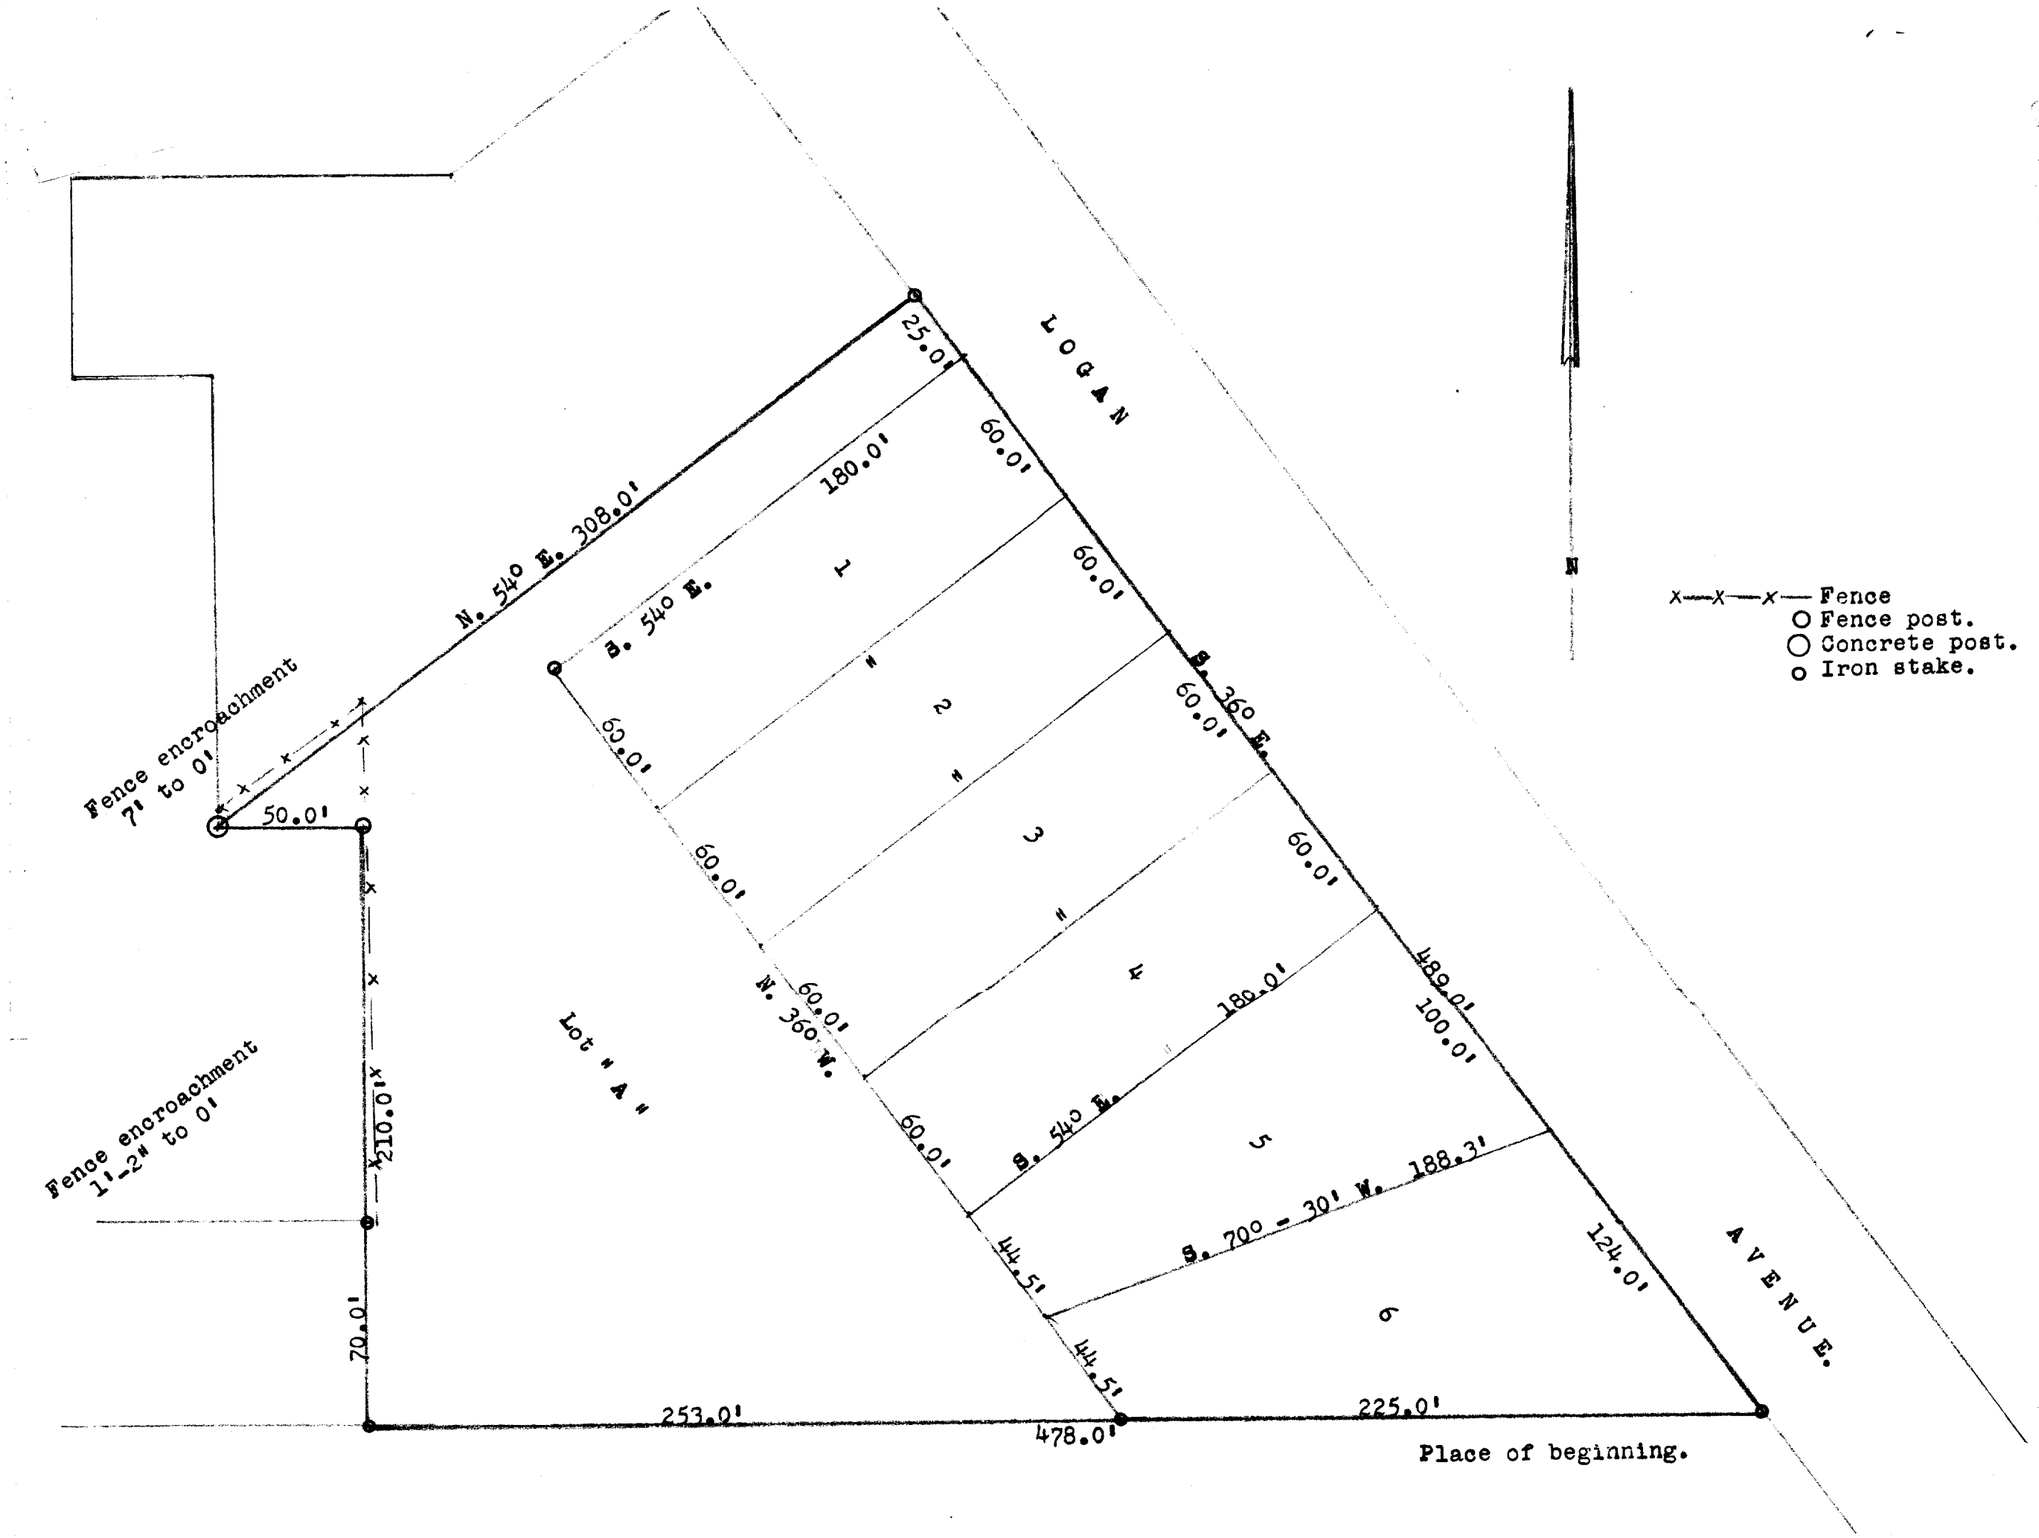

DESCRIPTION:

Commencing at an iron stake at the southeast corner of Lot 6, Searles Subdivision of a portion of the Village (now city) of Lake Geneva Walworth County, Wisconsin. thence West along the south line of said lot 6 and said lot line extended 478.0 feet to an iron stake, thence North 210.0 feet to a fence post, thence West 50.0 feet to a concrete post, thence N. 54° E., 308.0 feet to an iron stake in the westerly line of Logan Avenue, thence S. 36° E., along the westerly line of Logan Avenue 489.0 feet to the place of beginning.

CERTIFICATE:

I, hereby certify that I have on this the 30th day of September 1946, surveyed the above described property according to the official record on file in the office of the Recorder of Deeds in and for Walworth County, Wisconsin. and find that the measurements and bearings of the boundary lines of said property substantially agree with those in the above description, and that no encroachments exist other than those shown on the above plat.

SIGNED AND SEALED THIS 1ST DAY OF OCTOBER 1946.

Joseph M. Biagi. Professional Engineer.
Elkhorn Wisconsin.

S-1 and ~~S-2~~

7-202B