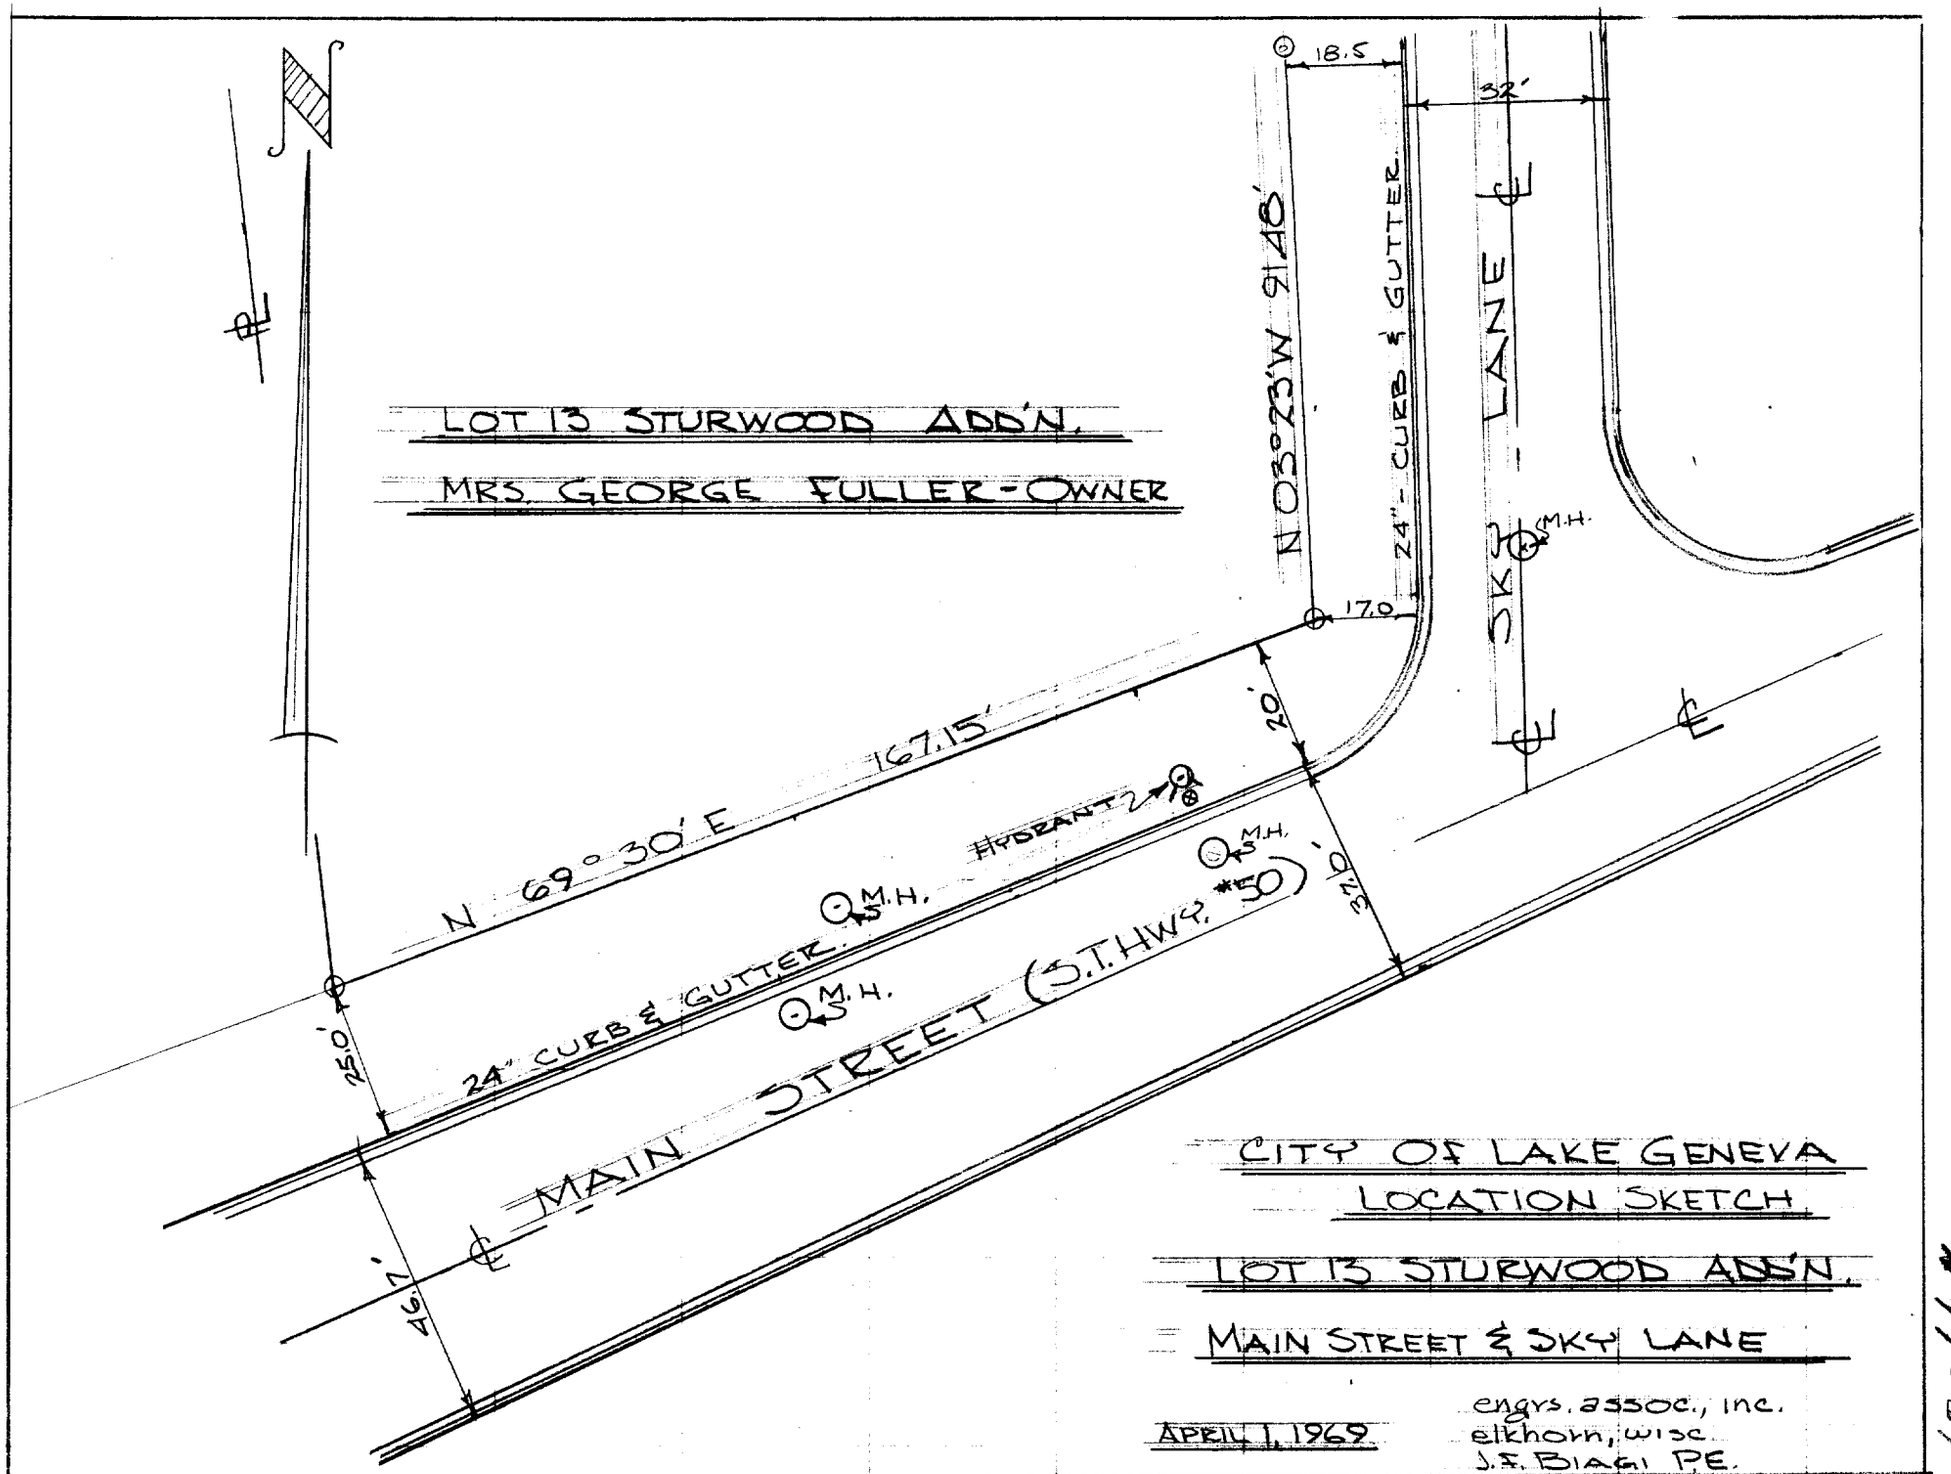

CITY OF LAKE GENEVA
LOCATION SKETCH
LOT 13 STURWOOD ADD'N.
MAIN STREET & SKY LANE

APRIL 1, 1969

engrs. assoc., inc.
elkhorn, wisc.
J.F. BIAGI P.E.

#779-69

25T. 12

7-205B