HAROLD H. KOLB

REGISTERED PROFESSIONAL LAND SURVEYOR
LAKE GENEVA, WISCONSIN

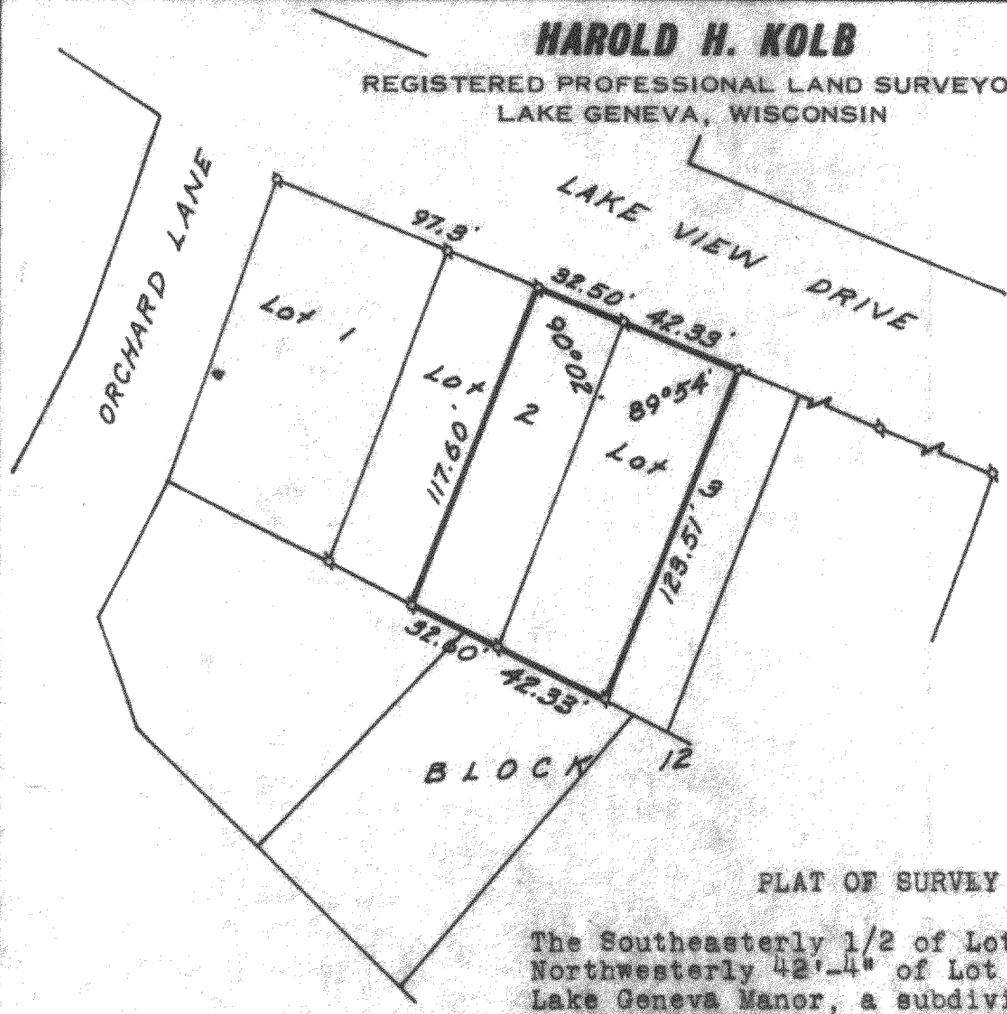

PLAT OF SURVEY OF

The Southeasterly 1/2 of Lot 2 and the Northwesterly 42'-4" of Lot 3, Block 12, Lake Geneva Manor, a subdivision located in Section 35, T 2 N, R 17 E, City of Lake Geneva, Walworth County, Wisconsin.

N

Scale 1"60'

LEGEND

- ⌐ — IRON PIPE FOUND
- ○ — IRON PIPE PLACED
- ● — CONCRETE MONUMENT
- x — SPIKE

I, HAROLD H. KOLB, DO HEREBY CERTIFY THAT I HAVE SURVEYED THE PROPERTY HEREON DESCRIBED ACCORDING TO THE OFFICIAL RECORDS, AND THAT THE PLAT HEREON IS A CORRECT REPRESENTATION OF THE LOT LINES.

Harold H. Kolb
HAROLD H. KOLB
WISCONSIN REGISTERED LAND SURVEYOR, S-187
DATE May 27, 1965

LM-3+6

7-209