
57-12

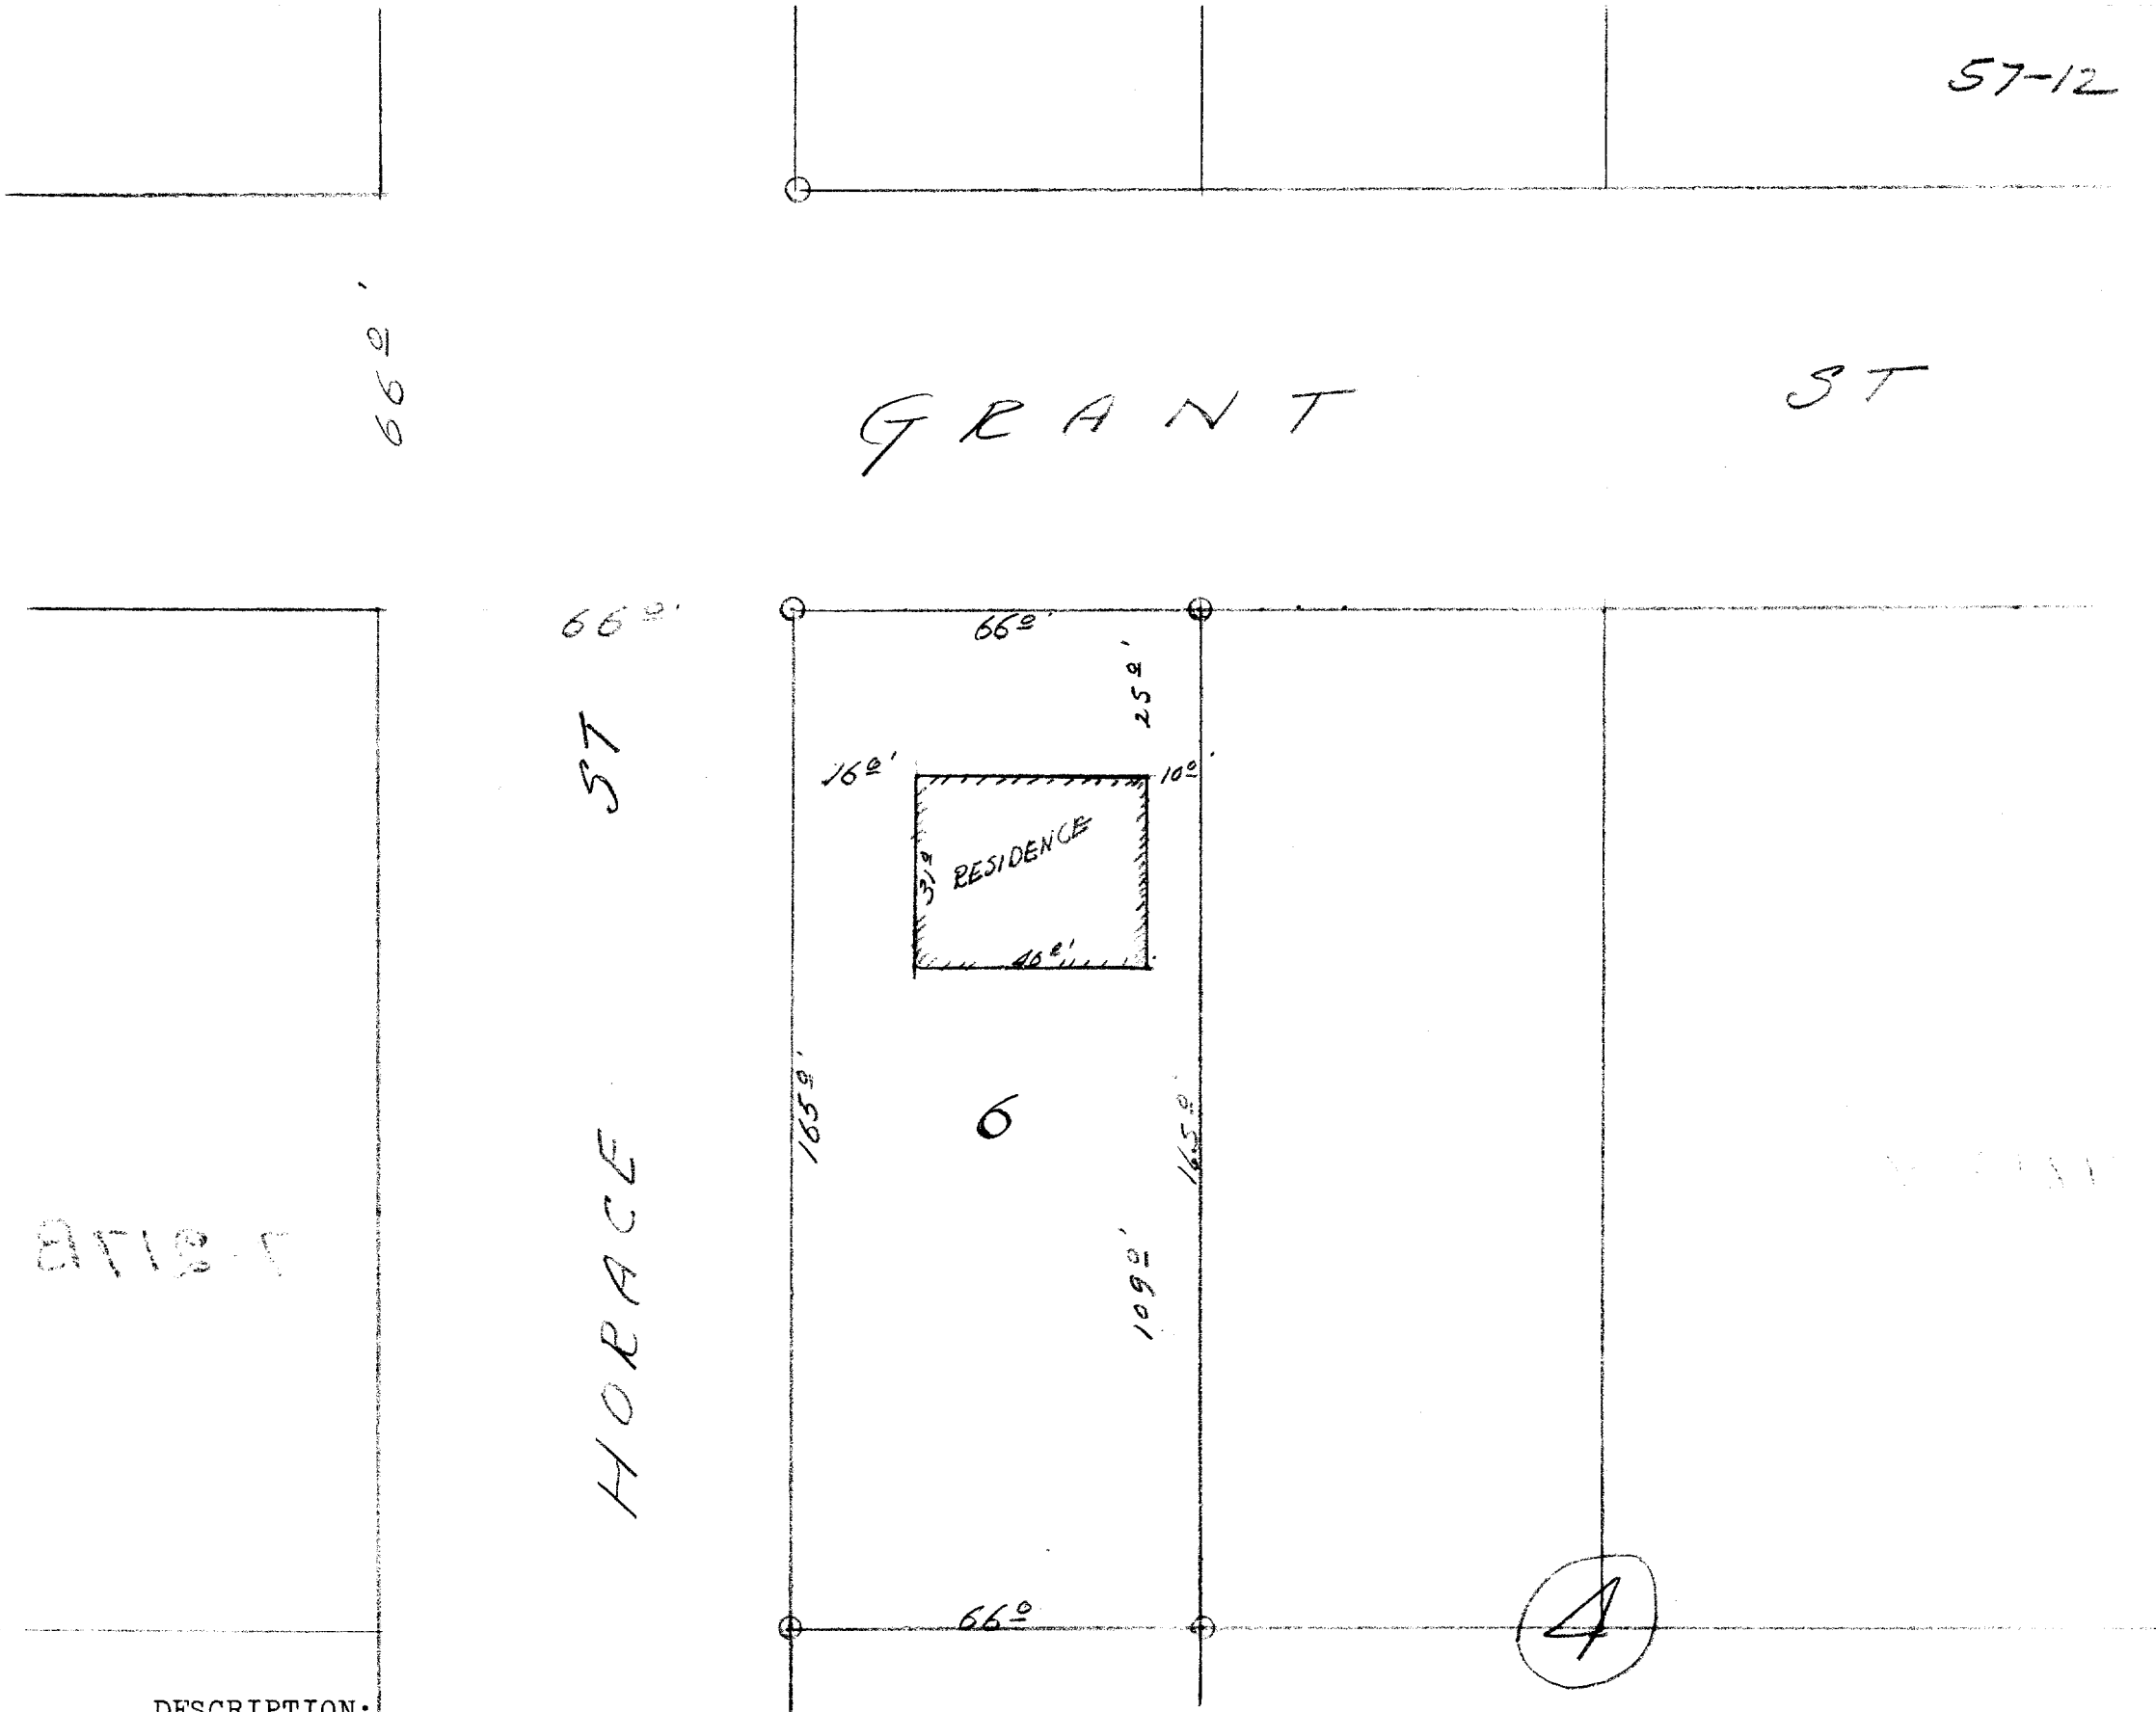

DESCRIPTION:

Lot 6, Block 4 Wheeler's Subdivision of a portion of the City of Lake Geneva, Walworth County, Wisconsin.

CERTIFICATE:

I, hereby certify that I have on this the 20th day of May, 1957, surveyed the above described property, and find that no encroachments exist, and that the residence thereon constructed as of this date is wholly within the boundarys of said lot.

SIGNED AND SEALED ON THIS THE 20TH DAY OF MAY 1957.

Joseph M. Biagi
Registered Surveyor
Elkhorn Wisconsin.

7-217B