
51-14

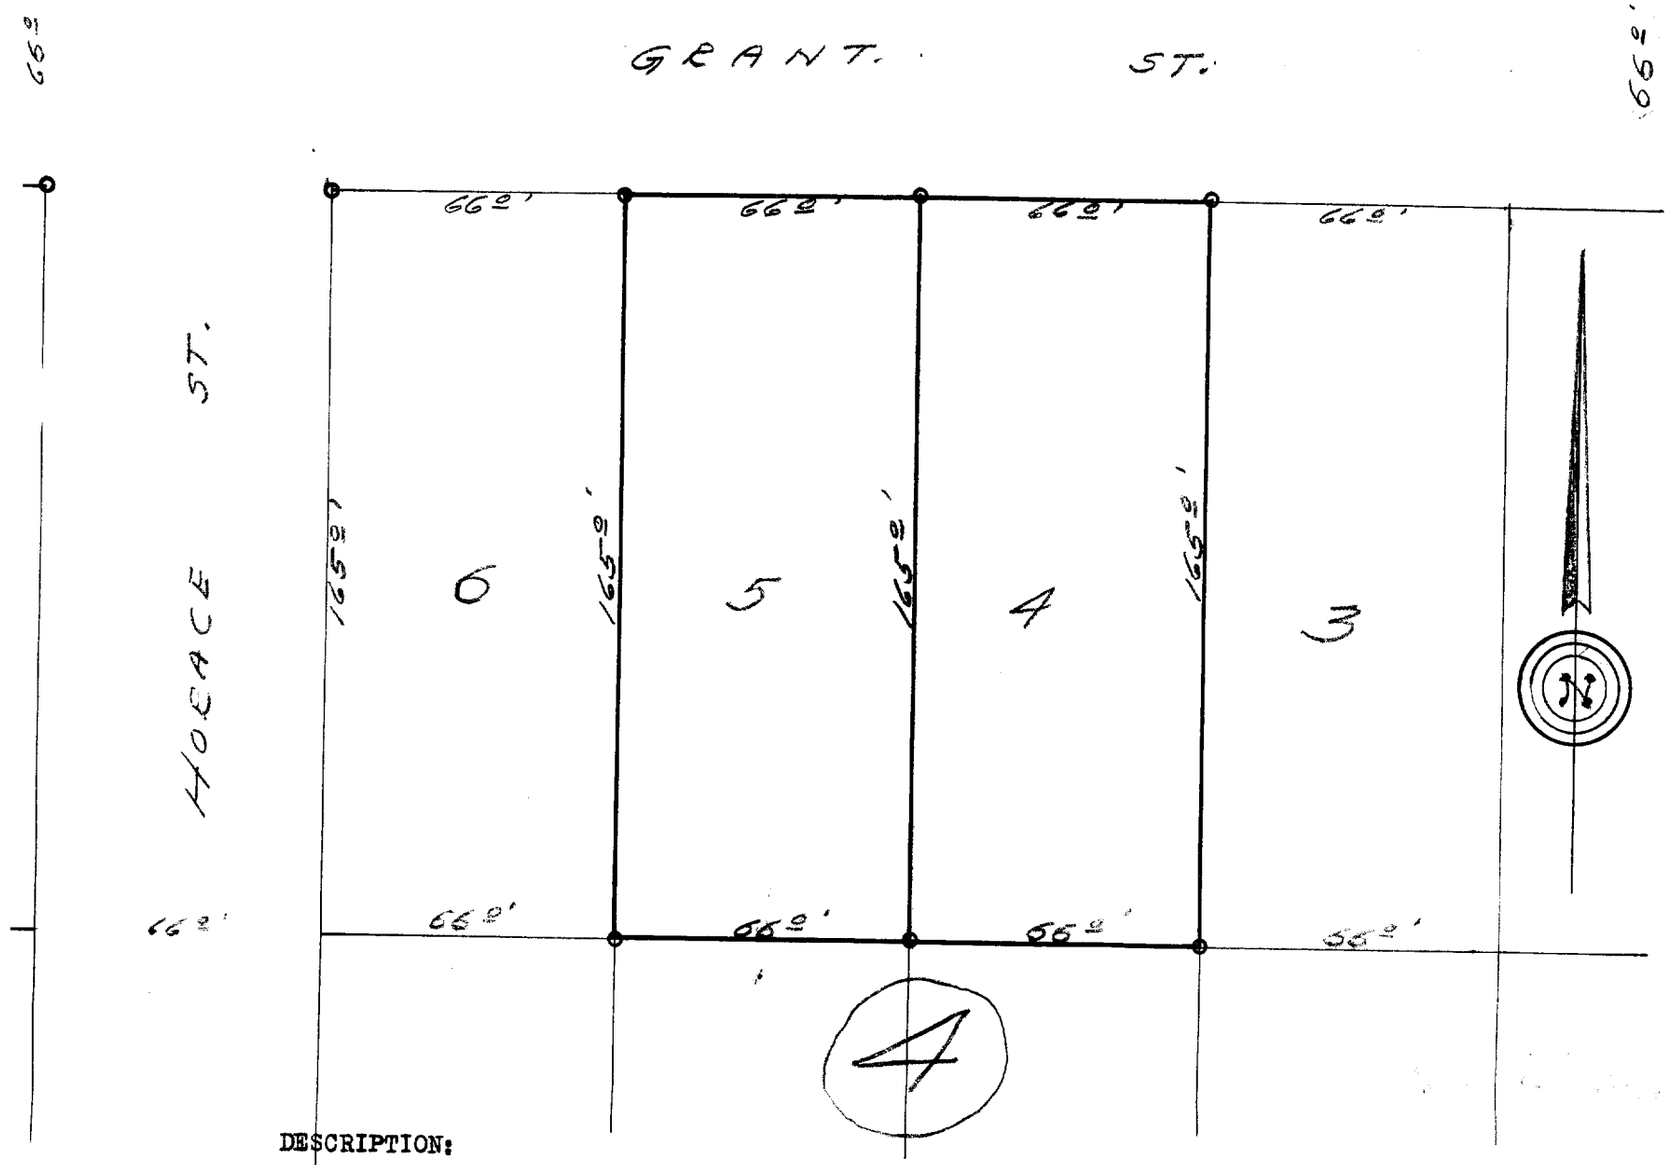

DESCRIPTION:

Lots 4 and 5; Block 4 of Wheeler's Subdivision of a portion of the City of Lake Geneva Walworth County, Wisconsin.

CERTIFICATE:

I, hereby certify that I, have on this the 28th day of May, 1951, surveyed the above described property according to the official records on file in the office of the Recorder of Deeds in and for Walworth County, Wisconsin, and find that the measurements and bearings of the boundary lines of said property as taken at the site on this day, substantially agree with those in said official record and that no encroachments exist. SIGNED AND SEALED ON THSS THE 1ST DAY OF JUNE 1951.

Joseph M. Biagi. Professional Engineer.
Elkhorn, Wisconsin

ZON-185-19

7-2185