
61-4

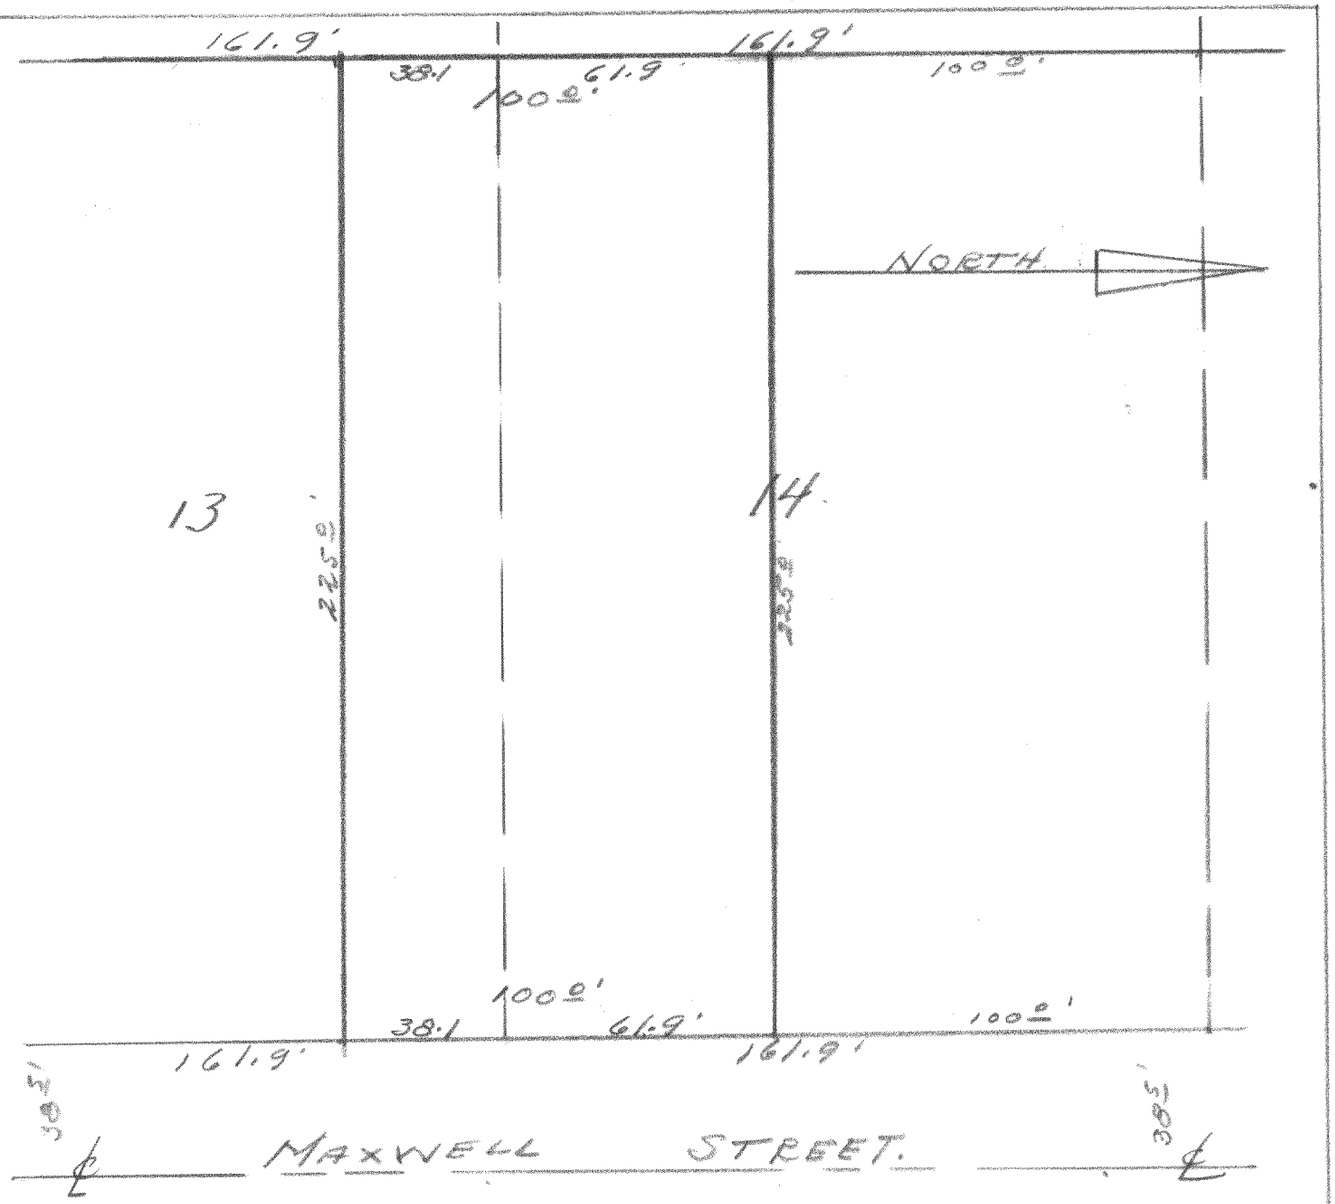

DESCRIPTION: The south 100.00 feet of the North 200.00 feet of the east one half of Lots 13 and 14 Columbian 2nd Subdivision of a portion of the City of Lake Geneva, Walworth County, Wisconsin.

CERTIFICATE: I, James F. Biagi, surveyor, do hereby certify that I have on this the 2nd day of March 1961, surveyed the above portrayed and described property.

SIGNED AND SEALED ON THIS THE 4th day of March, 1961.

James F. Biagi

James F. Biagi Registered surveyor
Elkhorn, Wisconsin.

7-22B

CL2-17A