TOPOGRAPHICAL MAPPING
LOT 48 OF LAKE GENEVA BUSINESS PARK PHASE II
CITY OF LAKE GENEVA, WALWORTH COUNTY, WISCONSIN

LEGEND
- ○ = FOUND IRON PIPE STAKE
- ● = SET IRON REBAR STAKE
- (XXX) = RECORDED AS

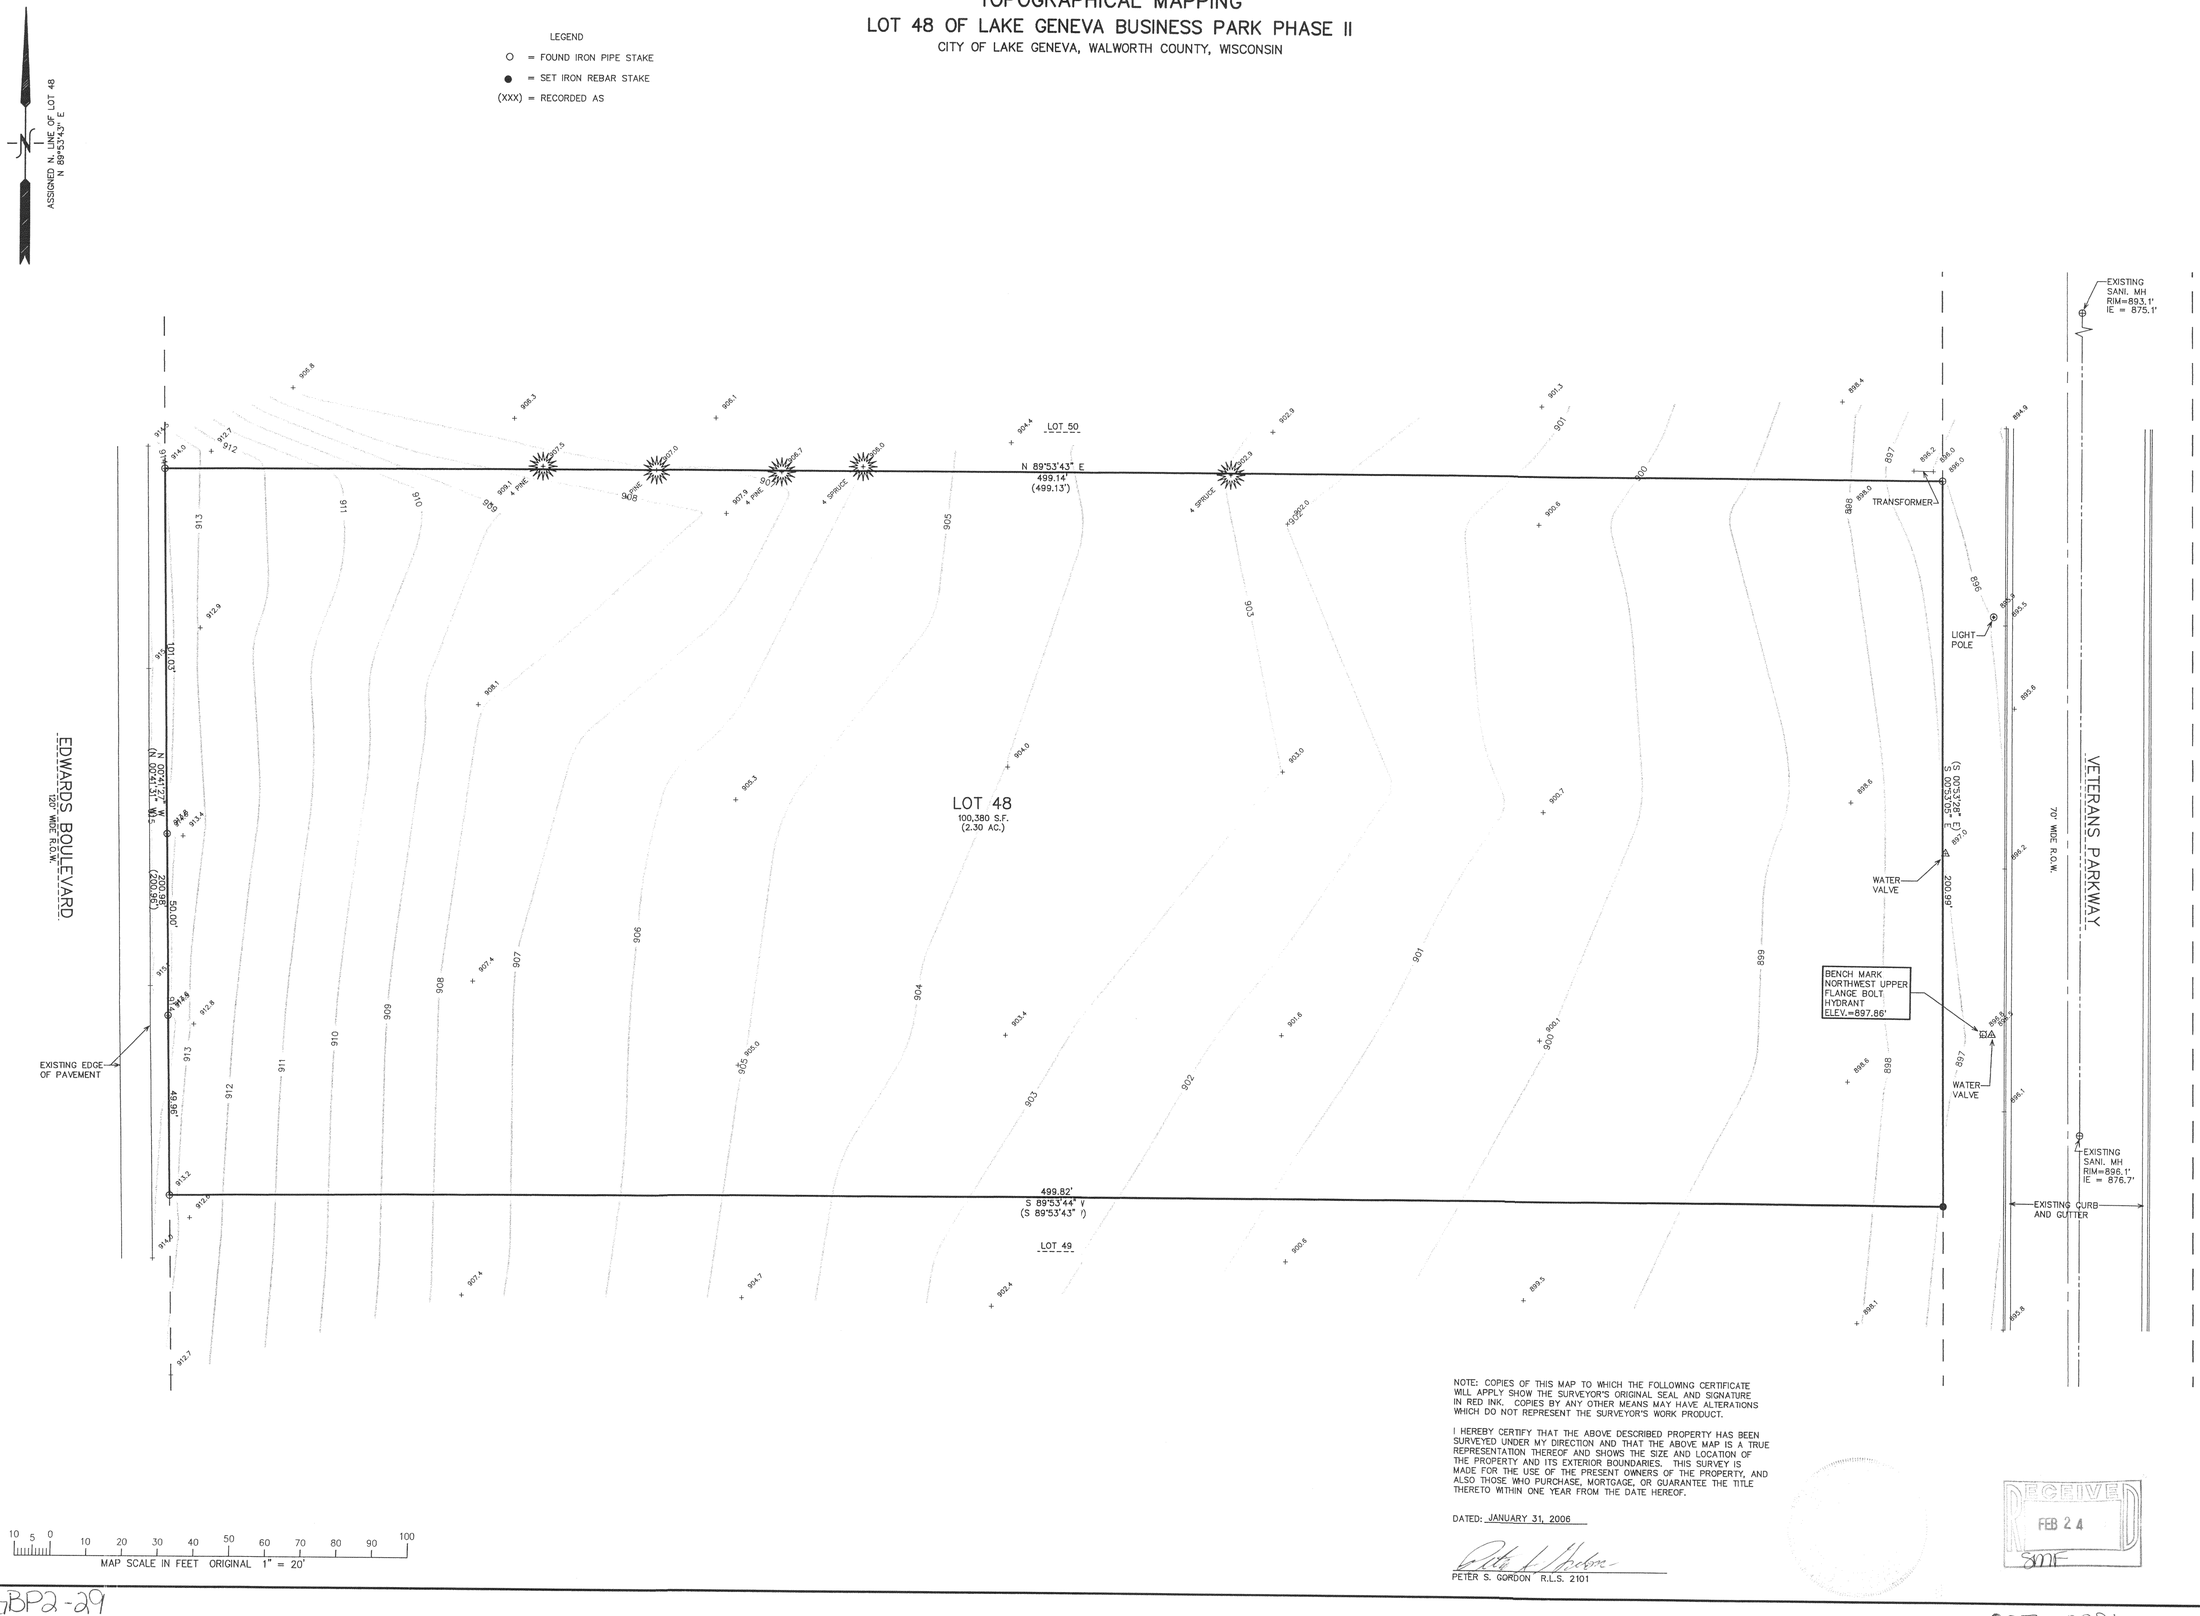

NOTE: COPIES OF THIS MAP TO WHICH THE FOLLOWING CERTIFICATE WILL APPLY SHOW THE SURVEYOR'S ORIGINAL SEAL AND SIGNATURE IN RED INK. COPIES BY ANY OTHER MEANS MAY HAVE ALTERATIONS WHICH DO NOT REPRESENT THE SURVEYOR'S WORK PRODUCT.

I HEREBY CERTIFY THAT THE ABOVE DESCRIBED PROPERTY HAS BEEN SURVEYED UNDER MY DIRECTION AND THAT THE ABOVE MAP IS A TRUE REPRESENTATION THEREOF AND SHOWS THE SIZE AND LOCATION OF THE PROPERTY AND ITS EXTERIOR BOUNDARIES. THIS SURVEY IS MADE FOR THE USE OF THE PRESENT OWNERS OF THE PROPERTY, AND ALSO THOSE WHO PURCHASE, MORTGAGE, OR GUARANTEE THE TITLE THERETO WITHIN ONE YEAR FROM THE DATE HEREOF.

DATED: JANUARY 31, 2006

PETER S. GORDON R.L.S. 2101

RECEIVED
FEB 24

10 5 0 10 20 30 40 50 60 70 80 90 100
MAP SCALE IN FEET ORIGINAL 1" = 20'

TOPOGRAPHICAL MAPPING
LOT 48 OF LAKE GENEVA BUSINESS PARK PHASE II
CITY OF LAKE GENEVA
WALWORTH COUNTY, WISCONSIN

– WORK ORDERED BY –
CURT LANGILLE
LANCO DEVELOPMENT COMPANY
7355 BANNOCKBURN CIRCLE
LAKEWOOD, IL 60014

FARRIS, HANSEN & ASSOCIATES, INC.
Engineering, Architecture, Surveying
7 Ridgway Court P.O. Box 437
ELKHORN, WISCONSIN 53121
Office: (262) 723-2098
Fax: (262) 723-6886

REVISIONS

PROJECT NO. 6975
DATE 01/31/2006
SHEET NO. 1 OF 1

ELGBP2-29

007-2381