PREPARED FOR:
KENNELLY DEVELOPMENT COMPANY , L.L.C.
303 BRIAN LANE PROSPECT HEIGHTS, ILL
60070

PLAT OF SURVEY

- OF -

LOT 48 OF LAKE GENEVA BUSINESS PARK PHASE 2 , LOCATED IN THE SOUTHEAST 1/4 OF SECTION 31 ; TOWN 2 NORTH , RANGE 18 EAST , CITY OF LAKE GENEVA , WALWORTH COUNTY, WISCONSIN.

J.K. SURVEYING INC.
N3705 WILLOWBEND LANE
LAKE GENEVA, WI. 53147
262-248-3697

SMF

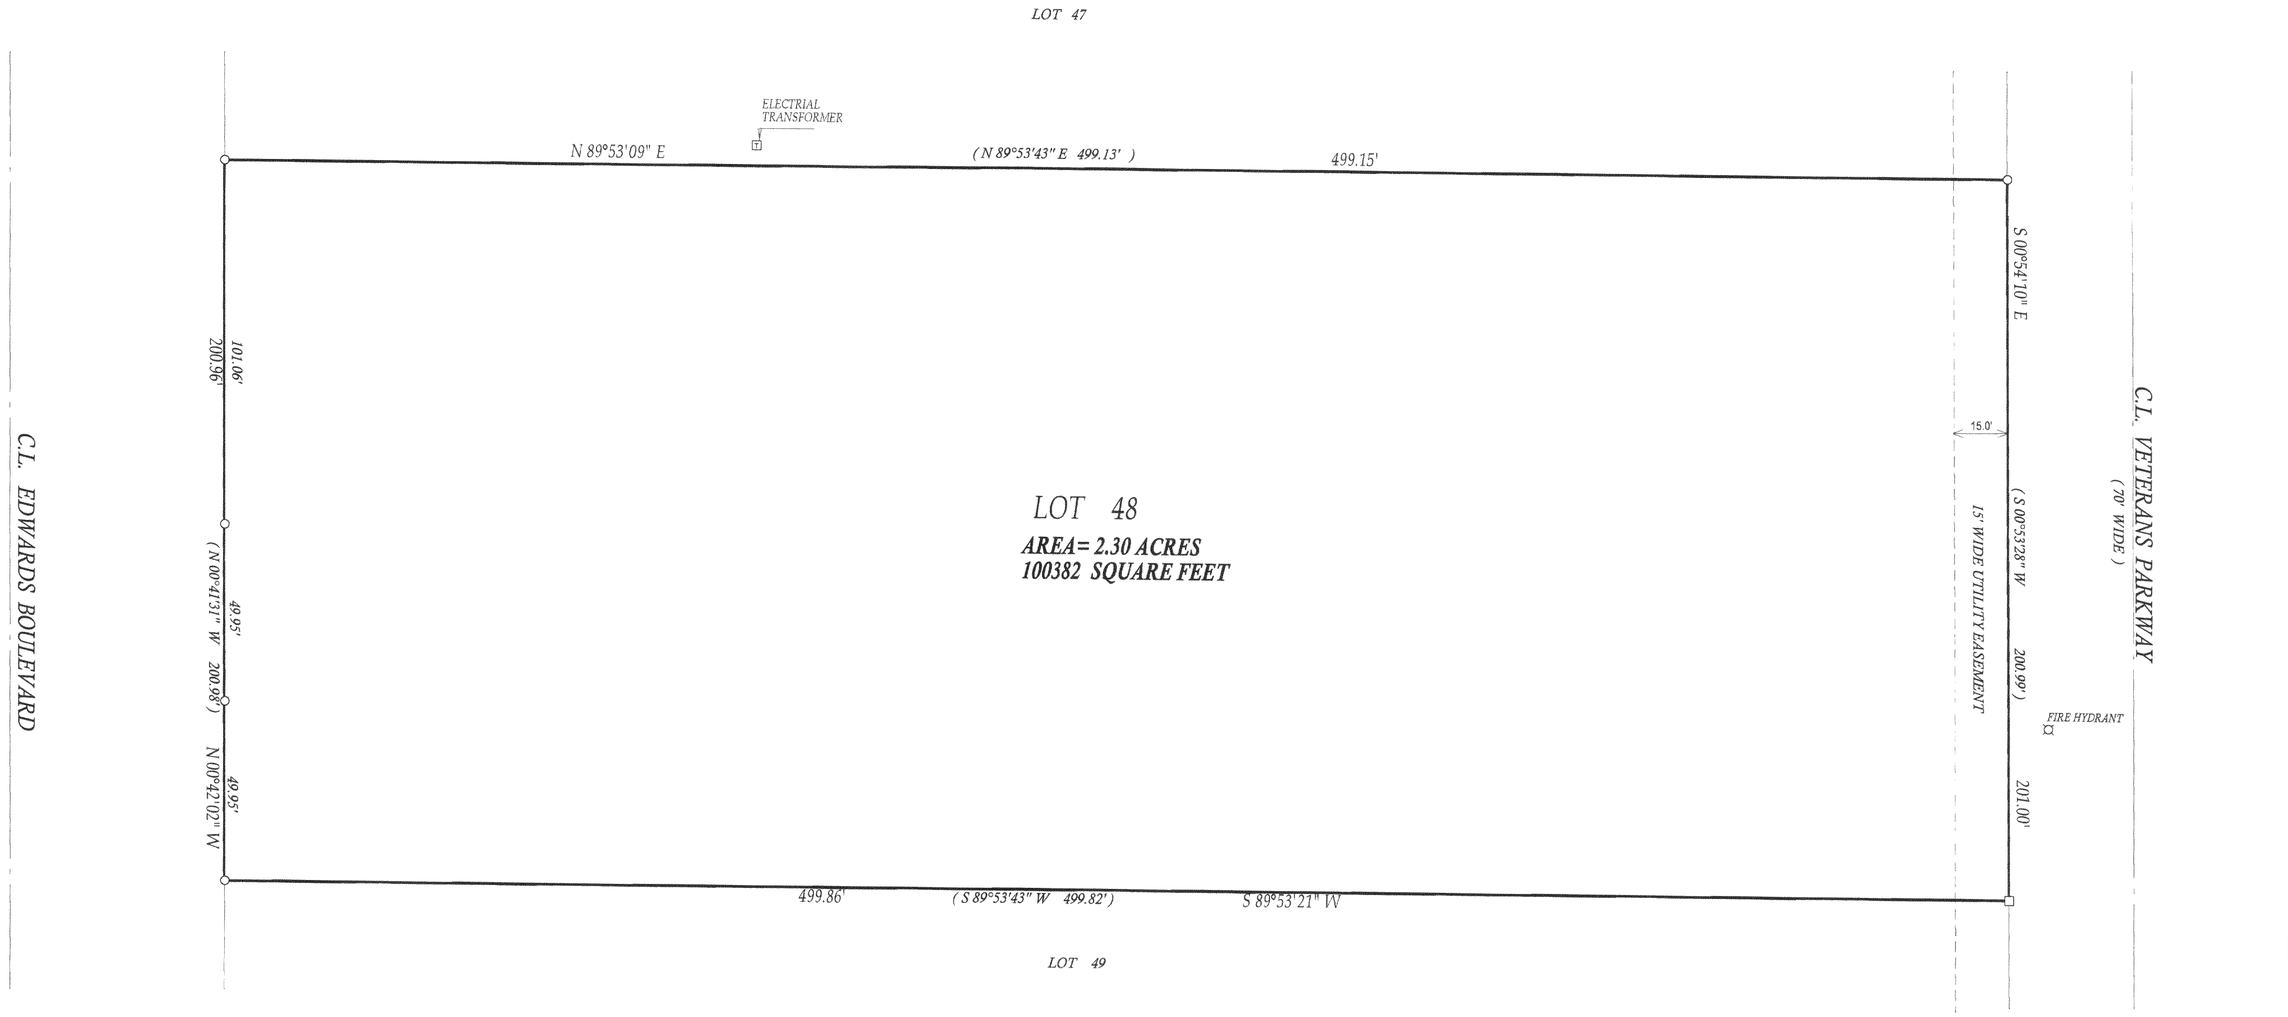

LEGEND

( )= recorded as
□ = found iron bar
○ = found iron pipe
● = set iron pipe
■ = set iron bar

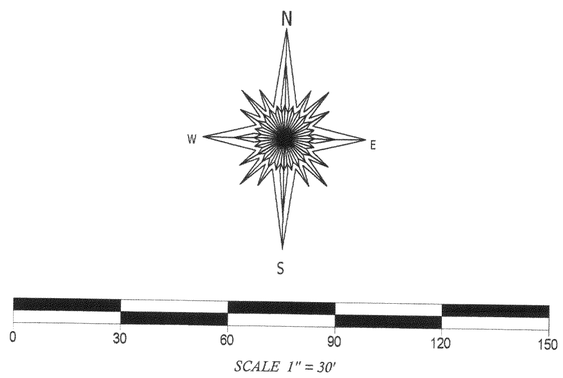

SCALE 1" = 30'

JOB # 06-49

TAX ID # ZLGBP200029

BEARINGS ARE REFERENCED TO THE RECORD PLAT OF LAKE GENEVA BUSINESS PARK PHASE 2

COMPARE LEGAL DESCRIPTION ABOVE AND DRAWING WITH DEED. FOR BUILDING RESTRICTIONS AND EASEMENTS NOT SHOWN REFER TO DEED, ABSTRACT SOURCES AND LOCAL MUNICIPAL CODES. NOTIFY THE SURVEYOR IMMEDIATELY OF ANY DISCREPANCY.

"I hereby certify that I have surveyed the above described property and that the above map is a true representation thereof and shows the size and location of all visible structures, apparent easements and encroachments if any."
This survey is made for the present owners of the property, and those who purchase, mortgage, or guarantee the title thereto, within one year from the date hereof.

DATED THIS 10th , DAY OF FEBRUARY , 2006

WISCONSIN
JOHN P.
KROTT
S-2258
LAKE GENEVA
WIS.
LAND SURVEYOR

JOHN KROTT S - 2258
Wisconsin Registered Land Surveyor
(original if signed in red)

007-2403