
247-65

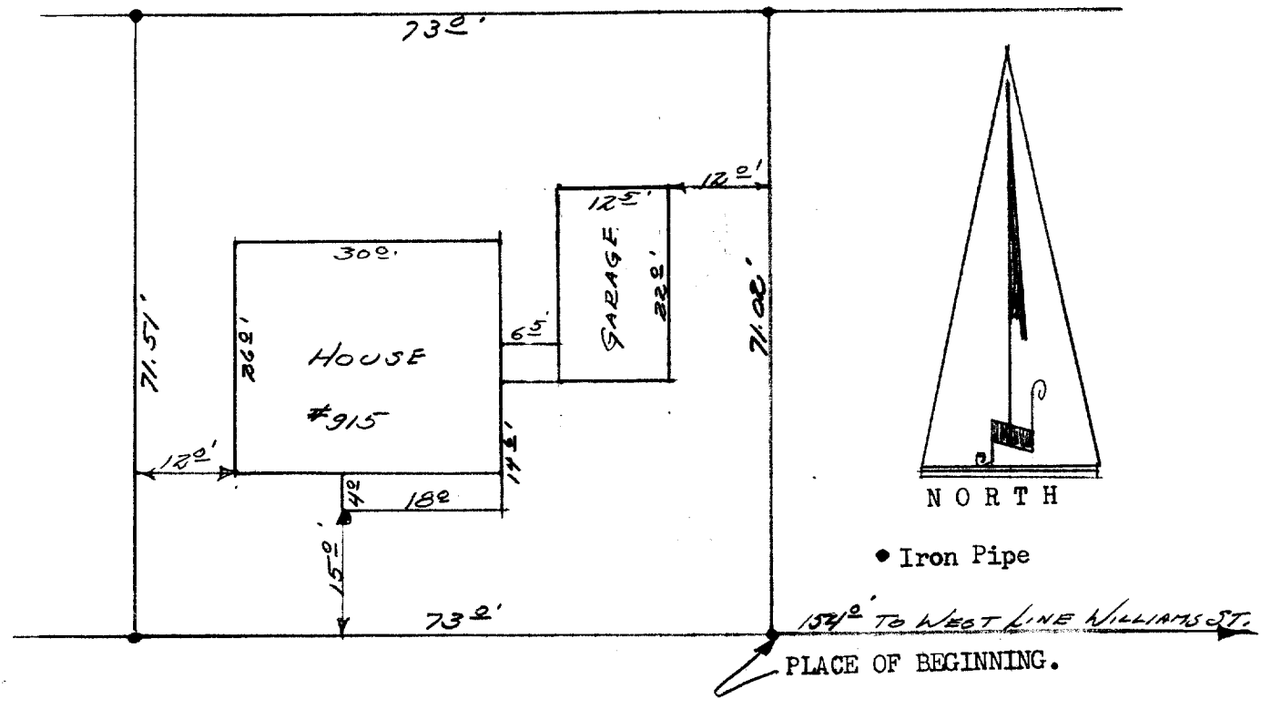

GRANT STREET

DESCRIPTION: Commencing at a point in the North Line of Grant Street, 154.0 feet West of the West line of Williams Street, thence North 71.02 feet, thence West 73.0 feet, thence South 71.51 feet, thence East 73.0 feet to the place of beginning. in the City of Lake Geneva, Walworth County, Wisconsin.

CERTIFICATE: I hereby certify that I have surveyed the above mentioned property and that the hereon portrayed is an accurate survey and a true representation thereof and correctly shows the exterior boundary lines and the location of buildings and other improvements thereof.

James F. Biagi. RLS 272
Elkhorn, Wisconsin.

Dated October 25th 1965.

WISCONSIN
JAMES F.
BIAGI
MILWAUKEE,
WIS.
LAND SURVEYOR

UP-13C

7-240B