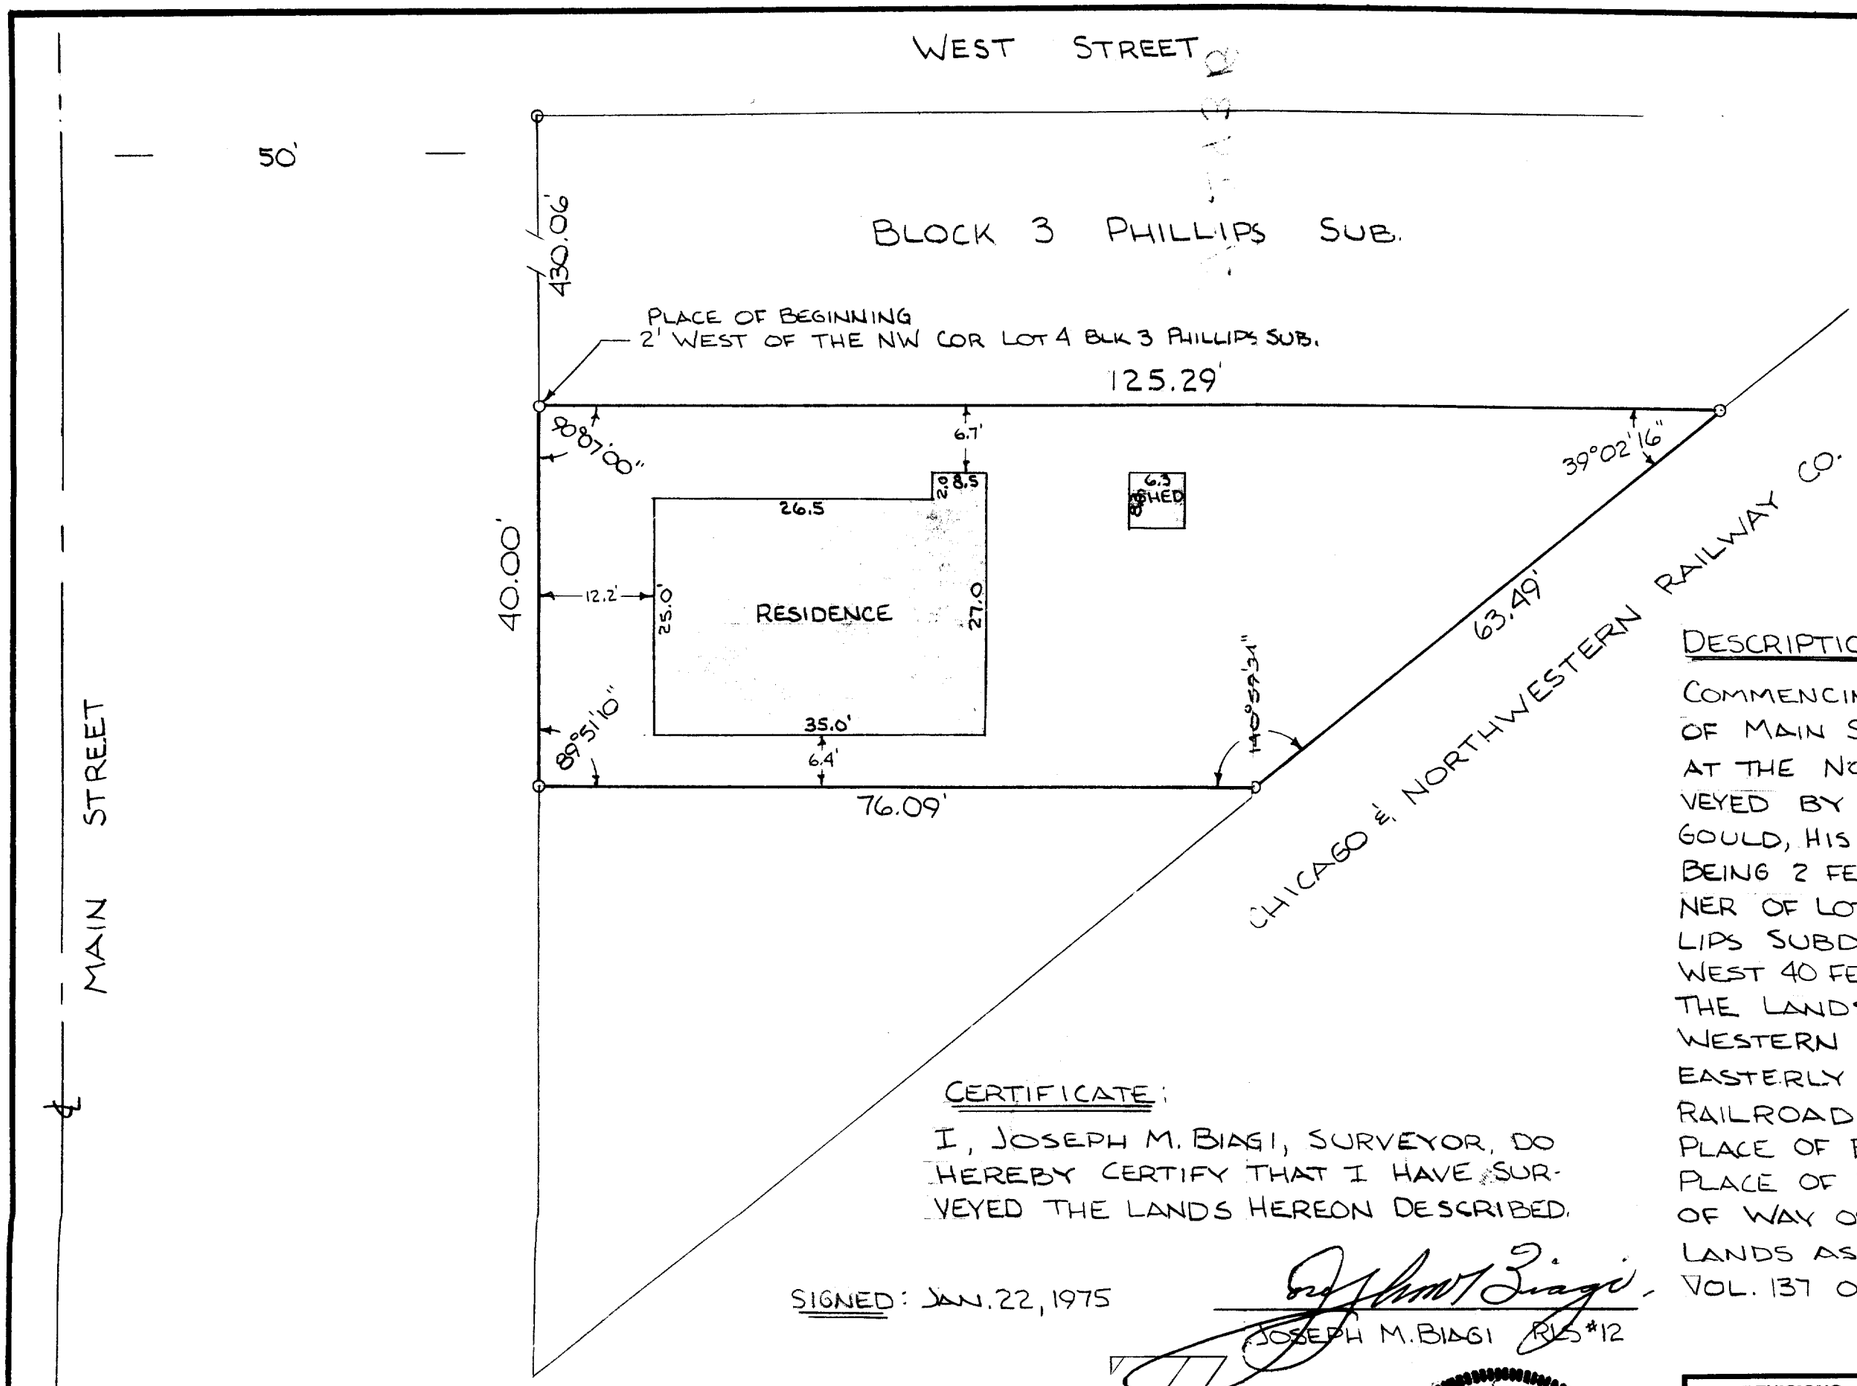


DESCRIPTION:

COMMENCING AT A POINT IN THE SOUTH LINE OF MAIN ST., OF THE CITY OF LAKE GENEVA, AT THE NORTHWEST CORNER OF LANDS CONVEYED BY MILES S. GOULD, AND MARTHA E. GOULD, HIS WIFE TO THOMAS DAY, SAID POINT BEING 2 FEET WEST OF THE NORTHWEST CORNER OF LOT NO'D 4 OF BLOCK NO'D 3 OF PHILLIPS SUBDIVISION IN SAID CITY; RUN THENCE WEST 40 FEET, THENCE SOUTH TO THE LINE OF THE LANDS OCCUPIED BY THE CHICAGO & NORTHWESTERN RAILWAY CO., THENCE IN A SOUTHEASTERLY DIRECTION IN THE LINE OF SAID RAILROAD LANDS TO A POINT SOUTH OF THE PLACE OF BEGINNING; THENCE NORTH TO THE PLACE OF BEGINNING; SUBJECT TO A RIGHT OF WAY OVER THE WEST 10 FEET OF SAID LANDS AS DESCRIBED IN DEED RECORDED IN VOL. 137 OF DEEDS ON PAGE 568

CERTIFICATE:

I, JOSEPH M. BIAGI, SURVEYOR, DO HEREBY CERTIFY THAT I HAVE SURVEYED THE LANDS HEREON DESCRIBED.

SIGNED: JAN. 22, 1975

JOSEPH M. BIAGI RLS #12

WISCONSIN JOSEPH M. BIAGI S-12 ELKHORN WIS. LAND SURVEYOR

LEGEND

o INDICATES IRON PIPE FOUND

REVISIONS		
NO.	DATE	BY
1		
2		
3		
4		
5		

RITA M. GRITZUK

DRAWN BY GW	SCALE 1" = 15'	MATERIAL
CHK'D HG	DATE 1-22-75	DRAWING NO. 13-75
TRACED	APP'D JMB	

TELEDYNE POST 18AE-10E—12X18

OP-384

7-943B