
46-23

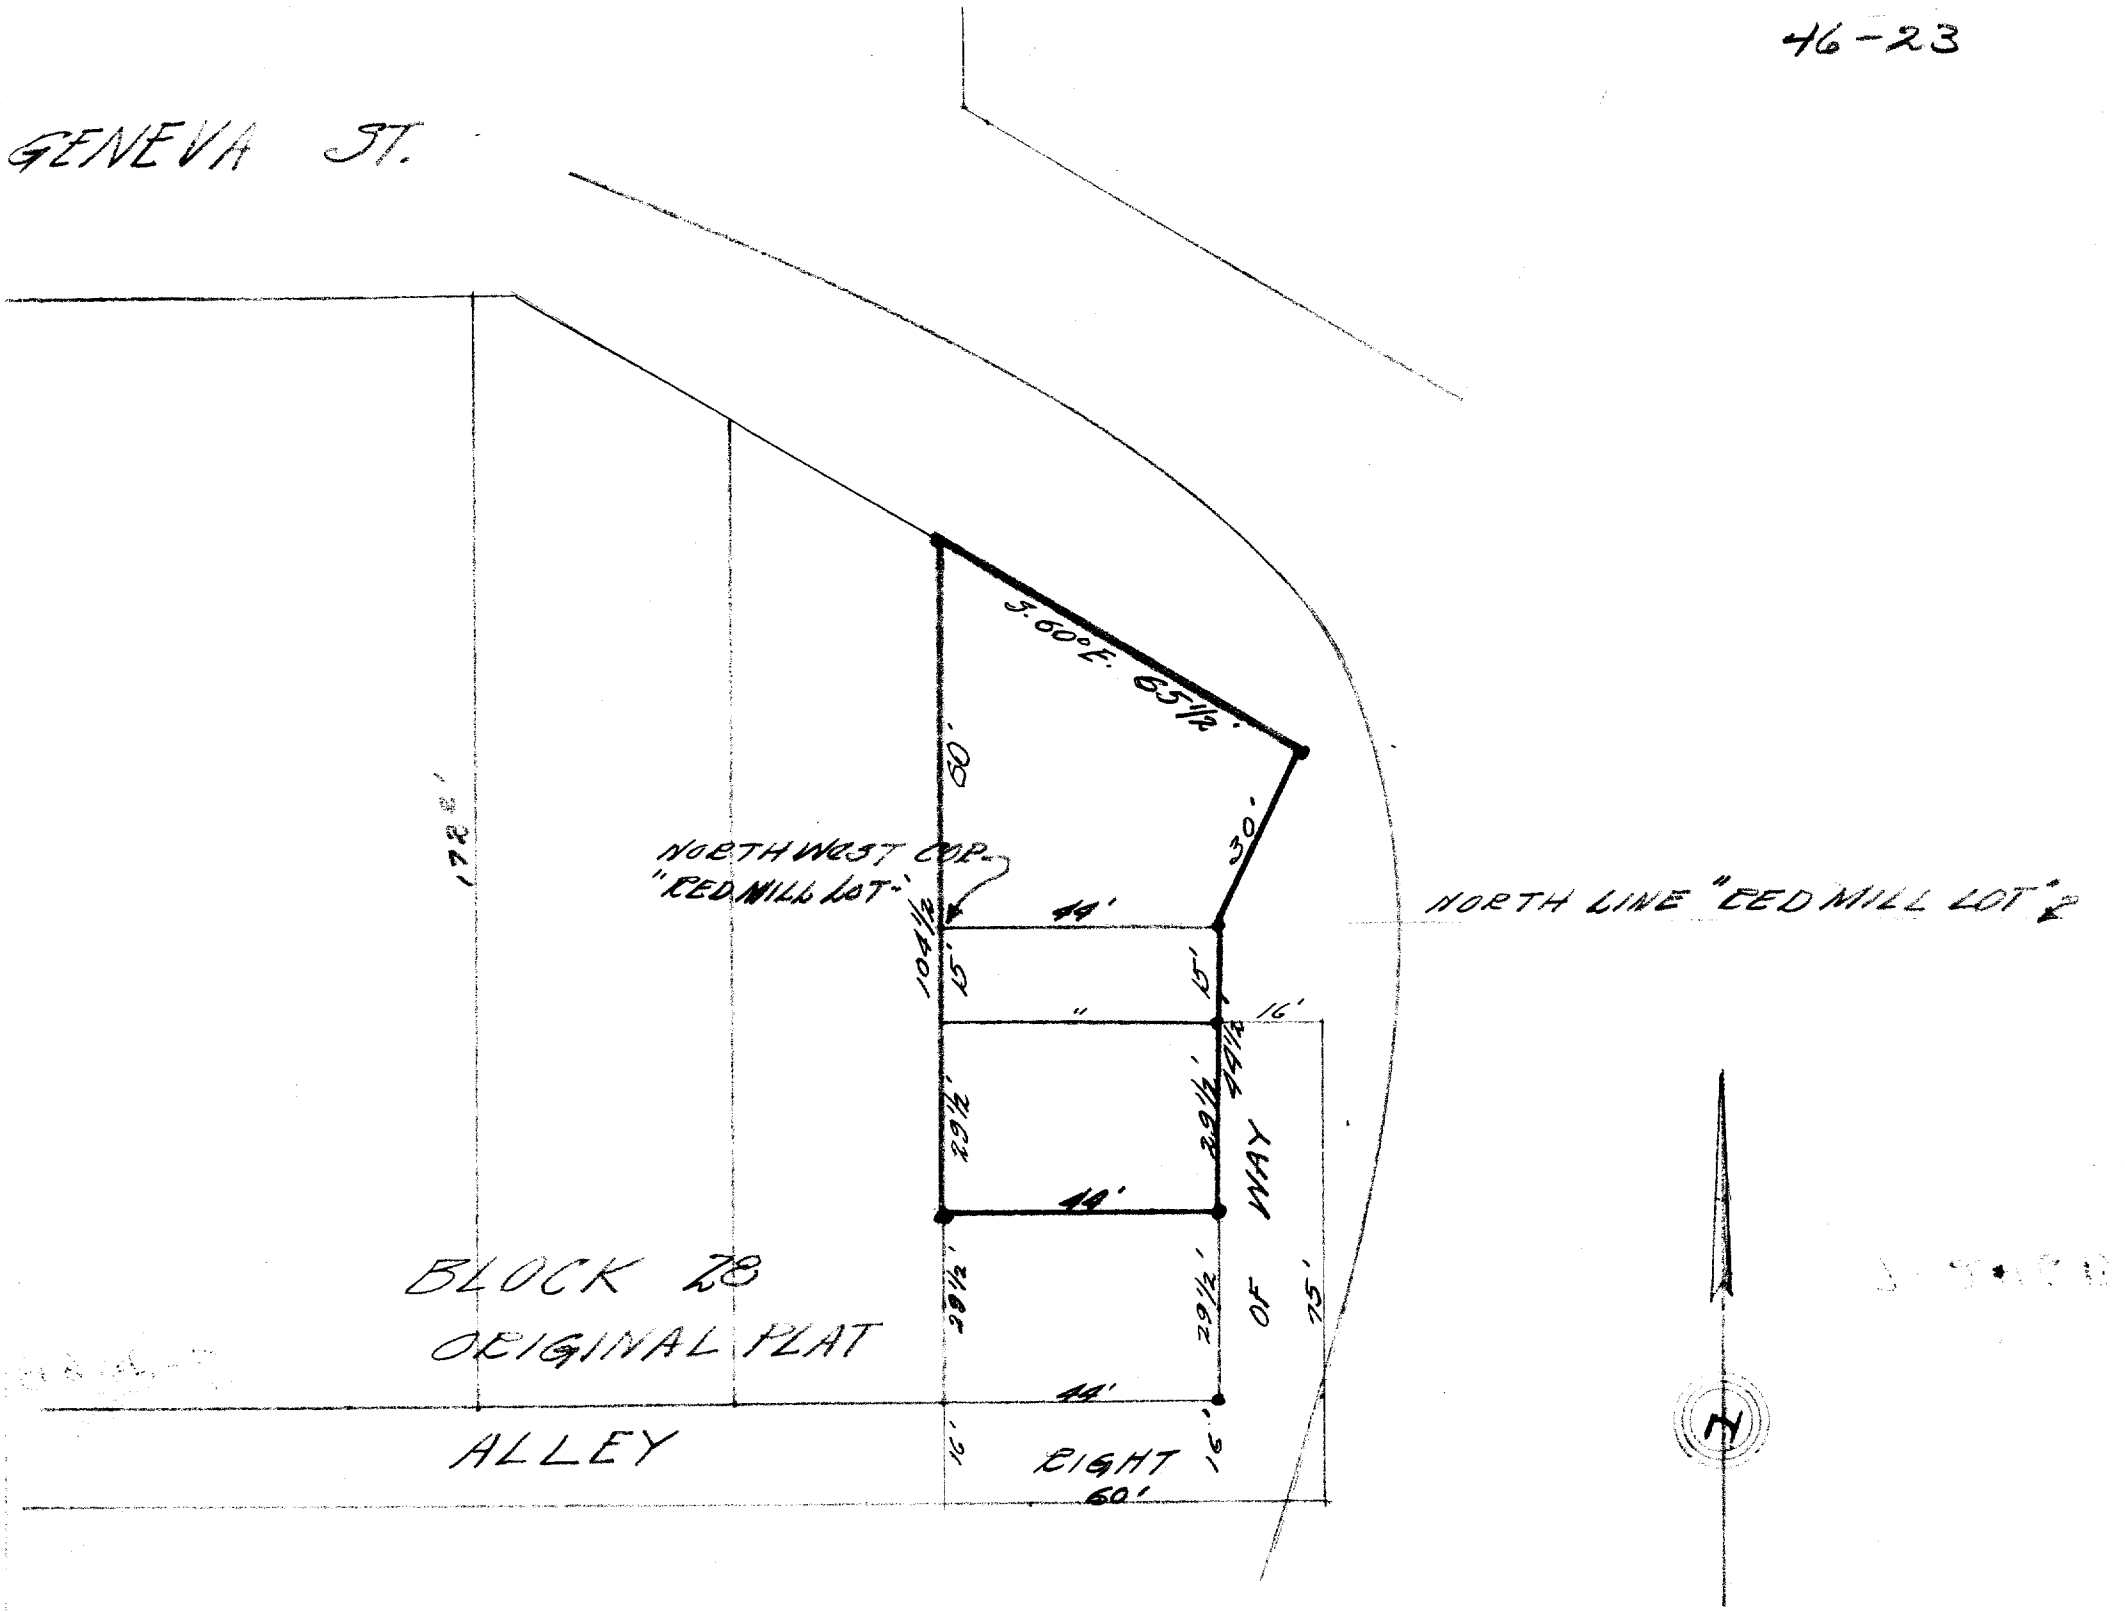

• Iron Stakes

DESCRIPTION: Commencing at the northwest corner the "Red Mill Lot", thence north along the north extension of the west line of said "Red Mill Lot" 60 feet to an iron stake, thence S. 60 E., 65.5 feet to an iron stake, thence southwesterly 30 feet to a point in the north line of said "Red Mill Lot" that is 44 feet east of the northwest corner of said lot, thence South 44.5 feet, to an iron stake, thence West 44 feet to an iron stake, thence North 44.5 feet to the place of beginning. Also a right of way 16 feet in width described as follows to wit; Commencing at a point that is 44 feet east of and 15 feet south of the northwest corner of "Red Mill Lot", thence east 16 feet to a point, thence south 75 feet to a point, thence west 60 feet to a point, thence north 16 feet to a point, thence east 44 feet to a point, thence north 59 feet to the place of beginning.

CERTIFICATE: I, hereby certify that I have on this the 15th day of May 1946, surveyed the above described property according to the official records on file in the office of the Recorder of Deeds, in and for Walworth County, Wisconsin, and find that the measurements and bearings of the boundary lines of said property as taken on this day substantially agree with those in the above description, and that no encroachments exist.
SIGNED AND SEALED THIS 16TH DAY OF MAY 1946.

Joseph M. Biagi.

Joseph M. Biagi. Professional Engineer
Elkhorn Wisconsin.

OP-292, 292B

7-246B