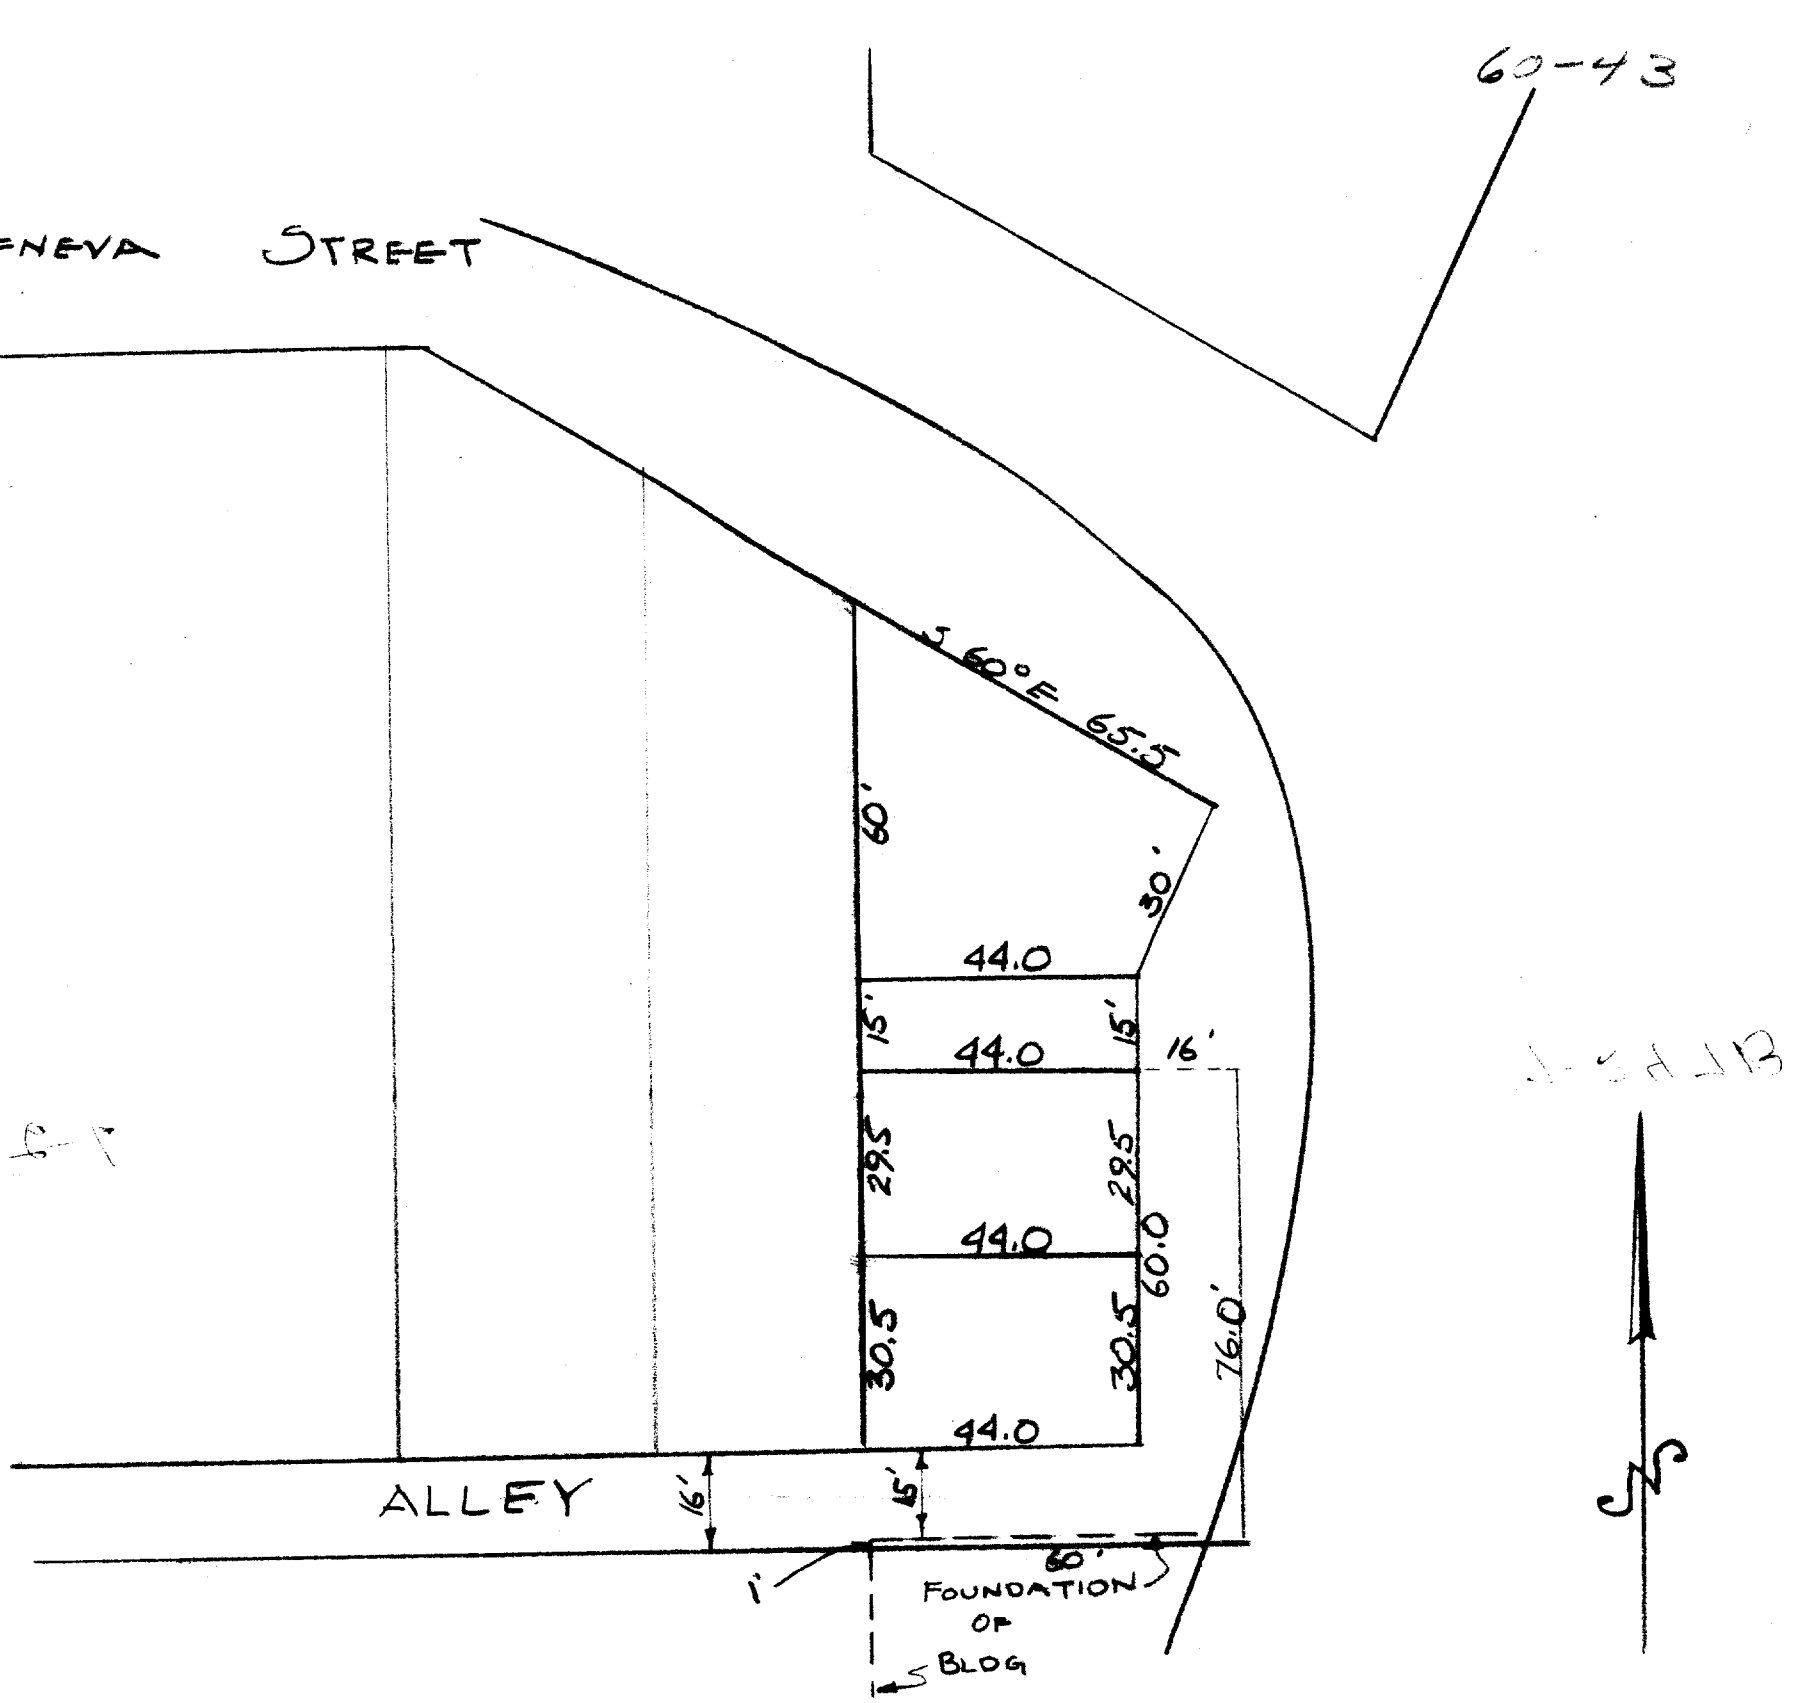


CORRECTION OF DESCRIPTION OF SURVEY BY J. M. BIAGI MAY 15, 1946:

Commencing at the northwest corner of the "Red Mill Lot", thence north along the north extension of the west line of said lot 60.00 feet to a point, thence S. 60° E., 65.50 feet to a point, thence southwesterly 30.00 feet to a point in the north line of said "Red Mill Lot" that is 44.00 feet east of the northwest corner of said lot, thence south 44.5 feet to a point, thence west 44.00 feet to a point, thence north 44.50 feet to the place of beginning. Also a right of way 16.00 feet in width described as follows: Commencing at a point that is 44.00 feet east of and 15 feet south of the northwest corner of "Red Mill Lot", thence east 16.00 feet to a point, thence south 76.00 feet to a point, thence west 60.00 feet to a point, thence north 16.00 feet to a point, thence east 44.00 feet to a point, thence north 60.00 feet to the place of beginning. All lands in the City of Lake Geneva, Walworth County, Wisconsin.

Certificate: I hereby certify that I have resurveyed the property hereon described on this 30th day of Jan. 1960.

SIGNED James F. Biagi

WISCONSIN JAMES F. BIAGI MILWAUKEE, WIS. LAND SURVEYOR

OP-292, OP-292A & OP-292B

7-247B