


FARRIS, HANSEN & ASSOCIATES, INC.

ENGINEERING — ARCHITECTURE — SURVEYING
7 RIDGWAY COURT — P.O. BOX 437 — ELKHORN, WISCONSIN 53121
PHONE: (262) 723-2098 FAX: (262) 723-5886

PLAT OF SURVEY

LOT 30 OF DAVID O. MARSH'S ADDITION TO THE
CITY OF LAKE GENEVA, WALWORTH COUNTY, WISCONSIN

— WORK ORDERED BY —
ANITA WHEELER
SHOREWEST REALTORS
830 EAST GENEVA STREET
DELAVER, WI 53115

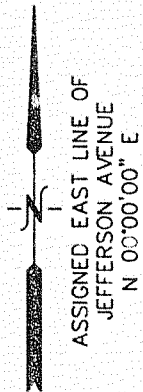

JEFFERSON AVENUE
{60' WIDE R.O.W.}

CENTERLINE

FOUND IRON PIPE STAKE
0.40' WEST OF LINE

LOT 23

LOT 30
9,364 S.F.
0.22 AC.

S 89°45'47" E

{60'}
59.98'

16.5'
8.3'
2.01'
10.2'
8.2'

SHED

FENCE CORNER
0.2' SOUTH AND 0.9'
EAST OF PIPE

FENCE 2.6' WEST
OF LINE

WOOD FENCE

CONCRETE

20.3'

28.4'

28.4'

20.3'

27.3'

CHIMNEY


































