
PREPARED FOR:
TROY WISE
938 GEORGE ST
LAKE GENEVA, WI 53147

PLAT OF SURVEY

-OF-

LOT 12 OF KOHN'S SUBDIVISION, LOCATED IN THE CITY OF LAKE GENEVA, WALWORTH COUNTY, WISCONSIN

PATHFINDER SURVEYING INC.
W2888 KRUEGER ROAD, UNIT "D"
LAKE GENEVA, WI, 53147
262-248-3697

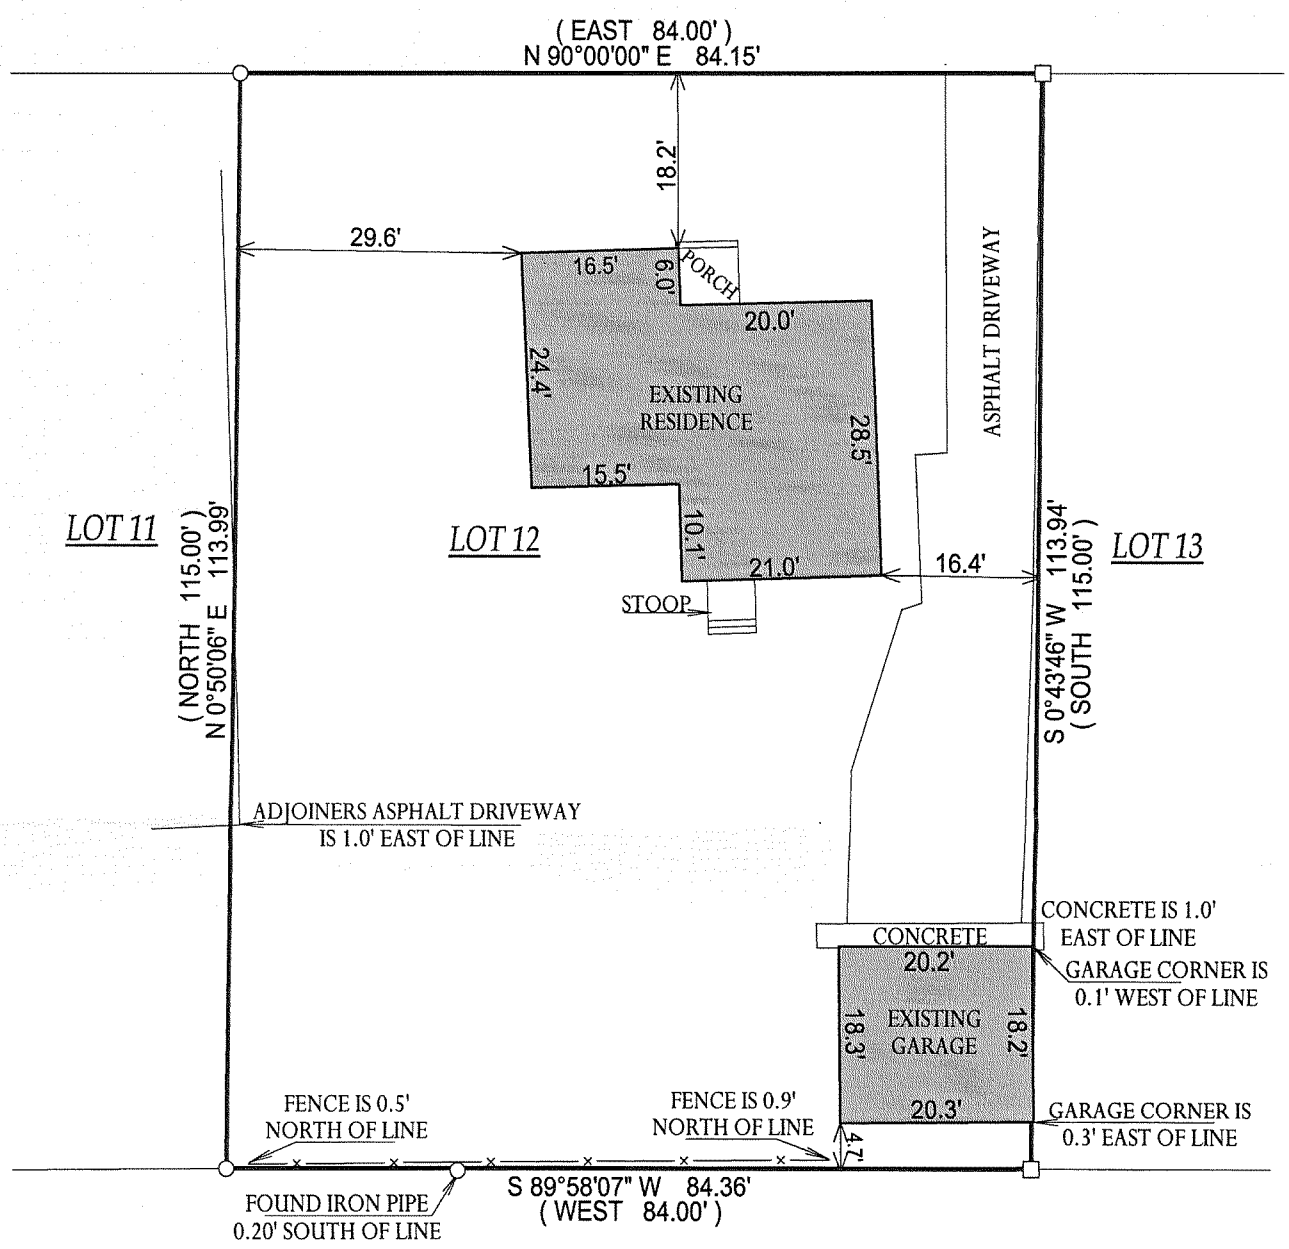

( ) = RECORDED AS

□ = *FOUND IRON BAR*

○ = *FOUND IRON PIPE*

● = *SET IRON PIPE*

■ = *SET IRON BAR*

SCALE: 1" = 20'

JOB #: 07-234

TAX ID #: ZK 00011

NOTE: BEARINGS BASED ON GEORGE STREET BEING ASSUMED EAST-WEST.

COMPARE LEGAL DESCRIPTION ABOVE AND DRAWING WITH DEED. FOR BUILDING RESTRICTIONS AND EASEMENTS NOT SHOWN,REFER TO DEED, ABSTRACT SOURCES AND LOCAL MUNICIPAL CODES. NOTIFY THE SURVEYOR IMMEDIATELY OF ANY DISCREPANCY.

"I hereby certify that the above described property was surveyed under my supervision and that the above map, to the best of my knowledge and belief, is a true representation thereof and shows the size and location of all visible structures, apparent easements and encroachments if any." This survey is made for the present owners of the property, and those who purchase, mortgage, or guarantee the title thereto, within one year from the date hereof.

RECEIVED
OCT - 9 2007

WISCONSIN
JOHN P.
KROTT
S-2258
LAKE GENEVA
WIS.
LAND SURVEYOR

JOHN KROTT S - 2258
Wisconsin Registered Land Surveyor
(original if signed in red)

DATED THE 6th DAY OF JUNE, 2007.

007 - 2556