
PLAT OF SURVEY
OUTLOT 1 AND LOT 2 OF CERTIFIED SURVEY MAP NO. 1485

LOCATED IN THE SOUTHWEST 1/4 OF THE SOUTHEAST 1/4 OF SECTION 26, TOWN 2 NORTH, RANGE 17 EAST, CITY OF LAKE GENEVA, WALWORTH COUNTY, WISCONSIN

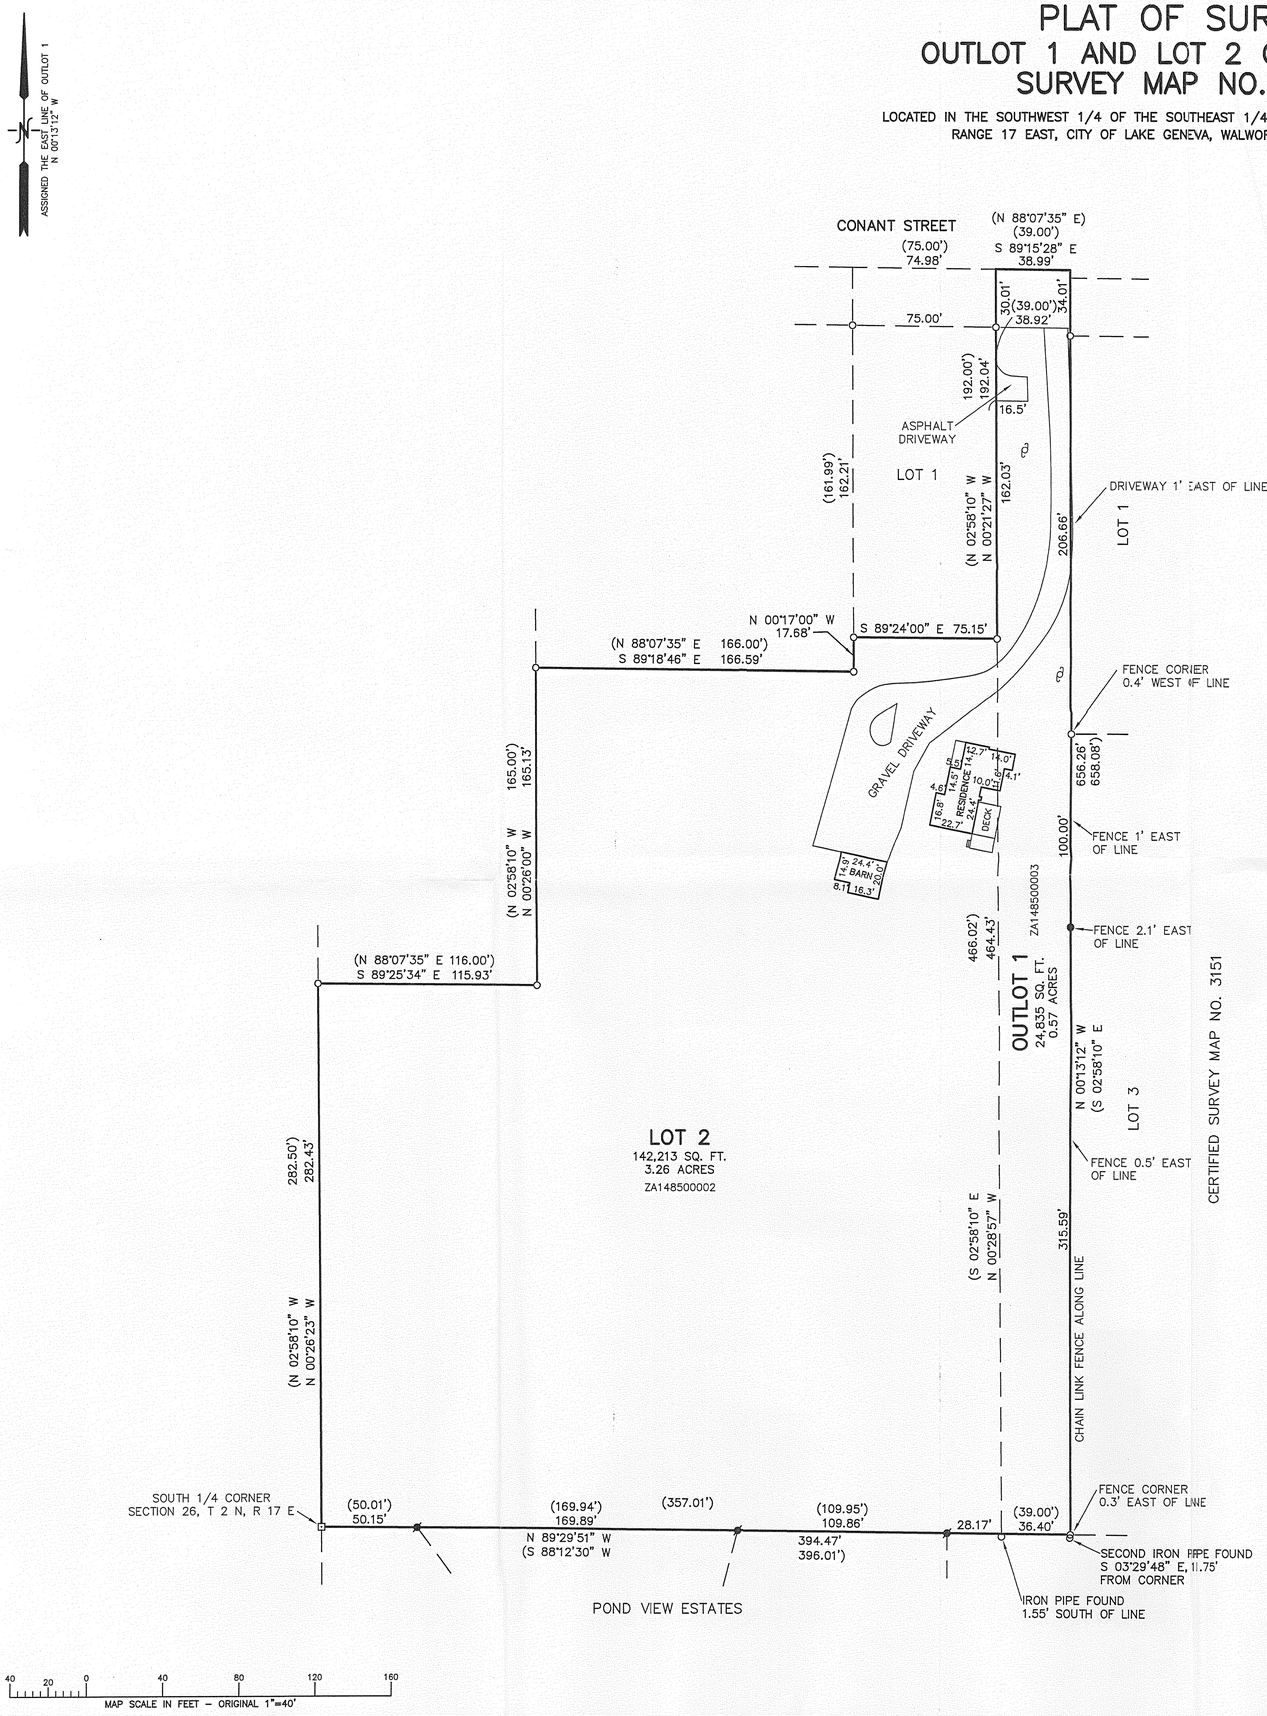

LEGEND

- ○ – FOUND IRON PIPE STAKE
- ● – FOUND IRON REBAR STAKE
- ⊡ – FOUND CONCRETE MONUMENT
- ● – PLACED IRON REBAR STAKE
- (XXX) – RECORDED AS
- ⌀ – UTILITY POLE

PER RECORD C.S.M.

NOTE: OUTLOT 1 IS RESERVED AS A PRIVATE ROAD IF LOT 2 IS REDIVIDED.

NOTE: COPIES OF THIS MAP TO WHICH THE FOLLOWING CERTIFICATE WILL APPLY SHOW THE SURVEYOR'S ORIGINAL SEAL AND SIGNATURE IN RED INK. COPIES BY ANY OTHER MEANS MAY HAVE ALTERATIONS WHICH DO NOT REPRESENT THE SURVEYOR'S WORK PRODUCT.

I HEREBY CERTIFY THAT THE ABOVE DESCRIBED PROPERTY HAS BEEN SURVEYED UNDER MY DIRECTION AND THAT THE ABOVE MAP IS A TRUE REPRESENTATION THEREOF AND SHOWS THE SIZE AND LOCATION OF THE PROPERTY AND ITS EXTERIOR BOUNDARIES. THIS SURVEY IS MADE FOR THE USE OF THE PRESENT OWNERS OF THE PROPERTY, AND ALSO THOSE WHO PURCHASE, MORTGAGE, OR GUARANTEE THE TITLE THERETO WITHIN ONE YEAR FROM THE DATE HEREOF.

RECEIVED
JUN 13 2008

DATED: 5/28/2008

PETER S. GORDON

WISCONSIN
PETER S. GORDON
S-2101
ELKHORN, WI
LAND SURVEYOR

PLAT OF SURVEY

– WORK ORDERED BY –
LEONARD JEGERSKI
1804 CONANT STREET
LAKE GENEVA, WI 53147

FARRIS, HANSEN & ASSOCIATES, INC.
ENGINEERING – ARCHITECTURE – SURVEYING
7 RIDGWAY COURT P.O. BOX 437
ELKHORN, WISCONSIN 53121
OFFICE: (262) 723-2098 FAX: (262) 723-5886

REVISIONS

PROJECT NO. 7614
DATE 05/28/2008
SHEET NO. 1 OF 1

ZA1485-2 ZA1485-3

007-2605