
55-5

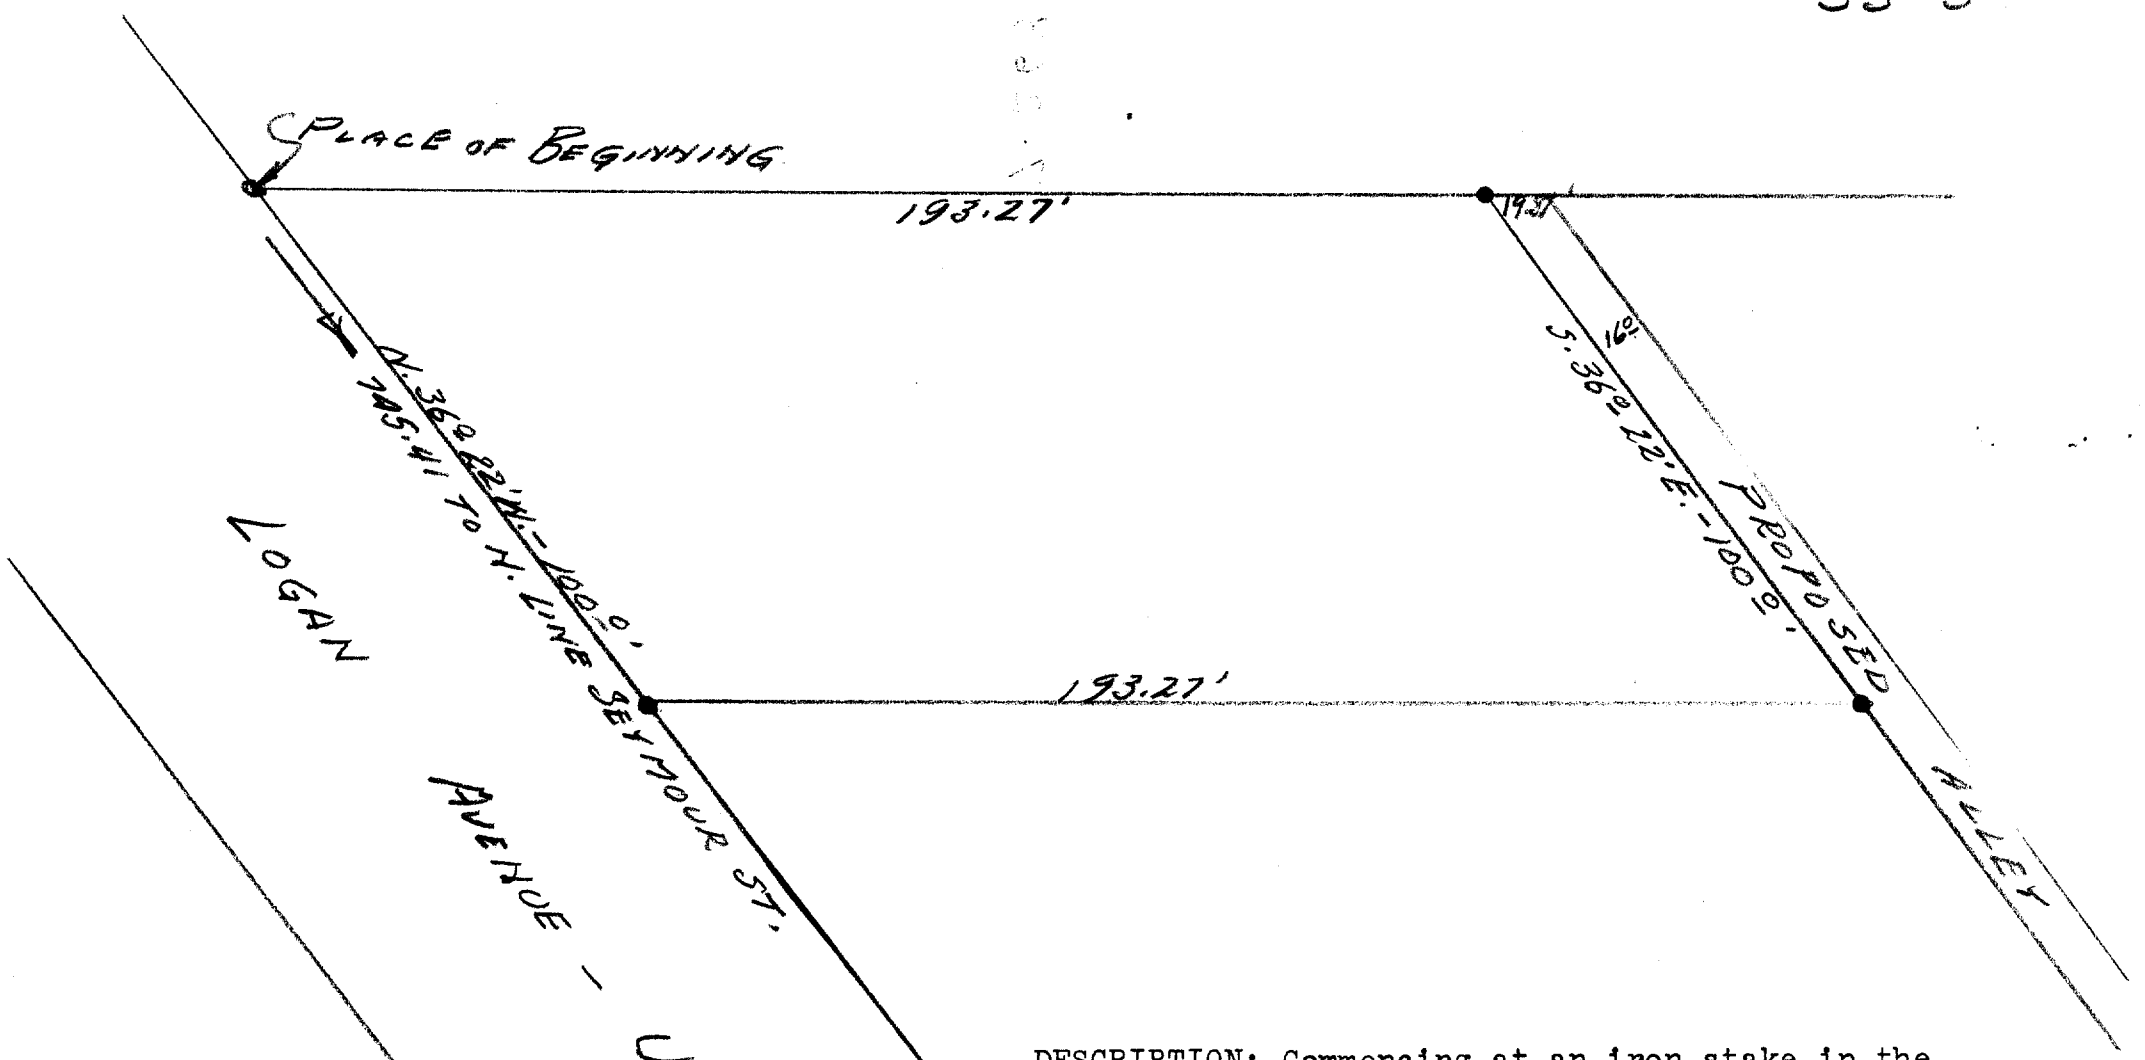

DESCRIPTION: Commencing at an iron stake in the easterly line of Logan Avenue of the City of Lake Geneva, Walworth County, Wisconsin, that is 745.41, feet N. 36° 22' W., of the intersection of the north line of Seymour Street and the said easterly line of Logan Street of said city, thence East, parallel with the north line of said Seymour Street, 193.27 feet to an iron stake, thence S. 36° 22' E., 100.0 feet to an iron stake, thence West 193.27 feet, to an iron stake in the easterly line of said Logan Avenue, thence N. 36° 22' W., along the easterly line of Lagan Avenue, 100.0 feet to the place of beginning.

CERTIFICATE: I, hereby certify that I have on this the 22nd day of October 1955, surveyed the above described property, according to the official record on file in the office of the Recorder of Deeds for Walworth County, and the plat hereon portrayed is an exact and accurate reproduction of said survey.

SIGNED AND SEALED ON THIS THE 24TH DAY OF OCTOBER 1955.

Joseph M. Biagi. Professional Engineer.
Elkhorn Wisconsin.

James F. Biagi. Surveyor.
Elkhorn Wisconsin.

• IRON STAKES

OP-398 (Part of)

7-263B