PREPARED FOR
FRED GELDERMAN
REMAX GENEVA REALTY
101 BROAD ST. SUITE 102
LAKE GENEVA WI. 53147


PLAT OF SURVEY

-OF-

THE NORTH 1/3 OF LOTS 4 AND 5 OF BLOCK 17 OF GENEVA LAKE CRAWFORD MANUFACTURING COMPANY'S ADDITION, A SUBDIVISION LOCATED IN THE SOUTHEAST 1/4 OF SECTION 25 TOWN 2 NORTH, RANGE 17 EAST, CITY OF LAKE GENEVA, WALWORTH COUNTY, WISCONSIN.

KROTT SURVEYING INC.
N3705 WILLOW BEND LANE
LAKE GENEVA WI. 53147
PHONE # (262)248-3697
FAX # (262)249-0639

RECEIVED
SEP 10 2010
By

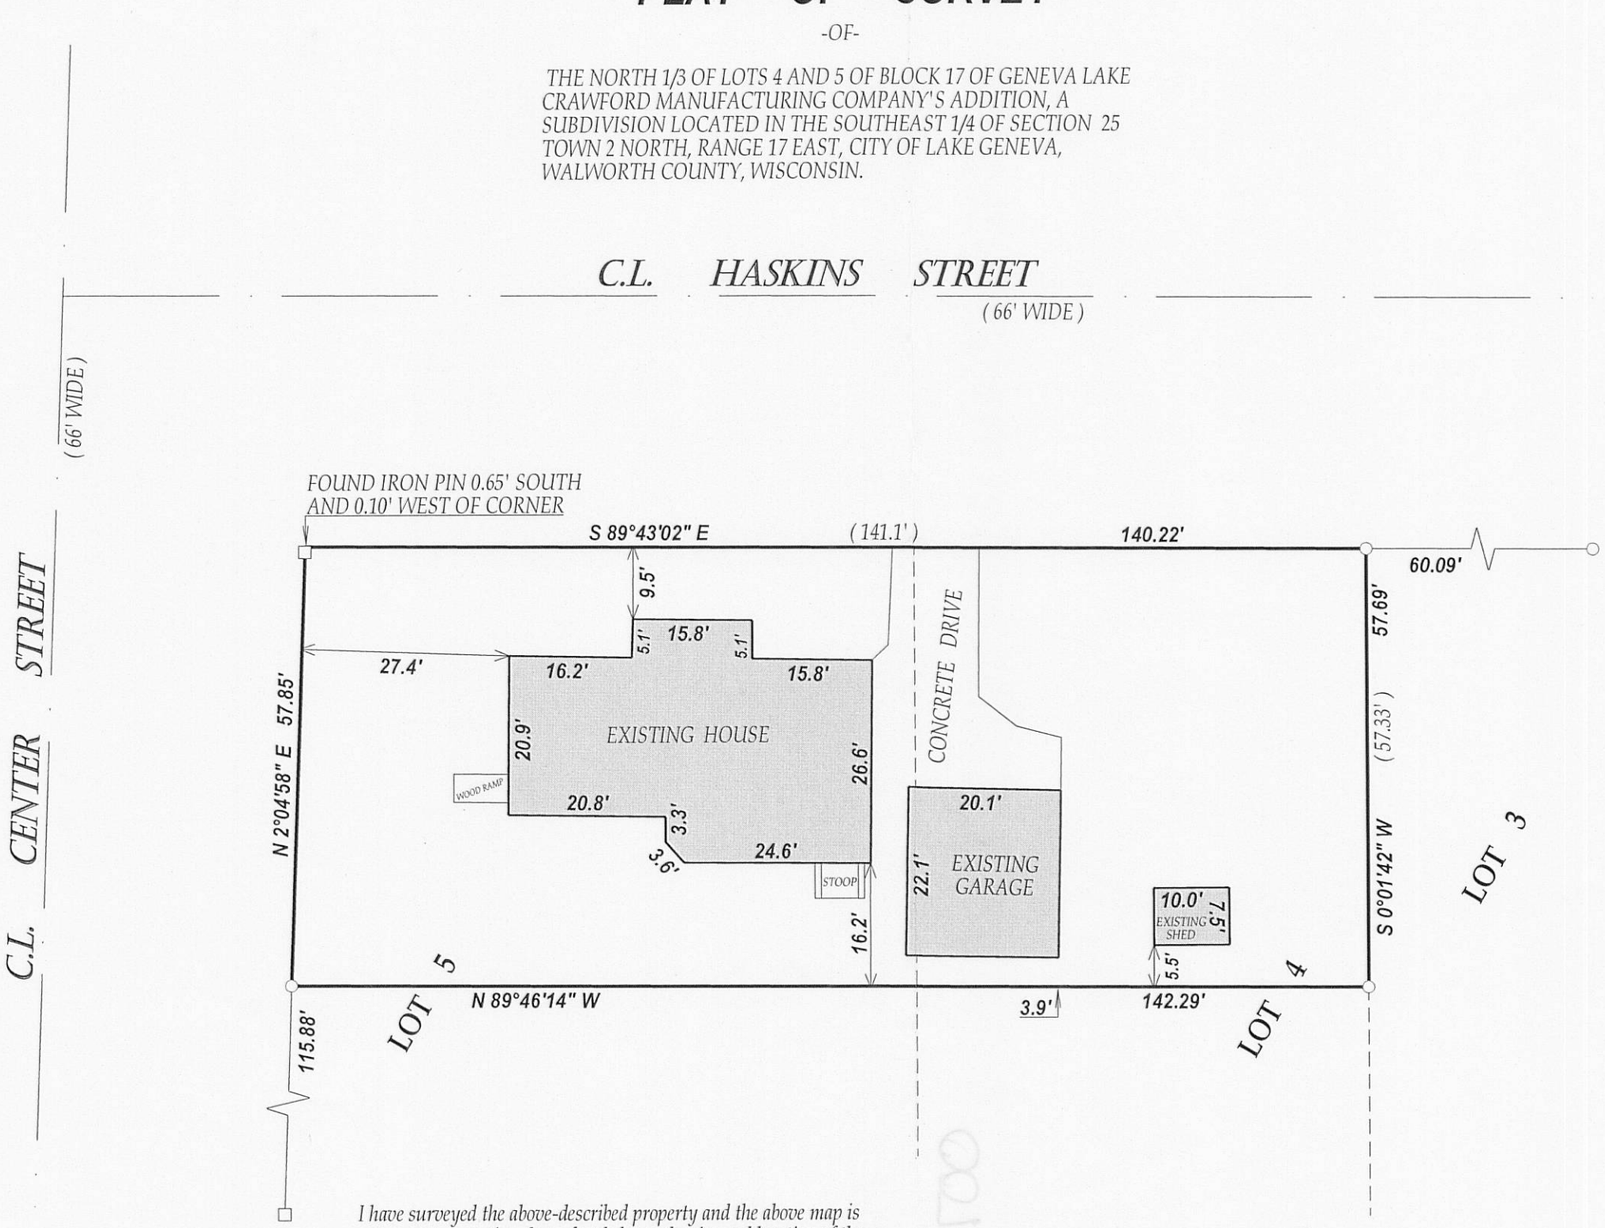

LEGEND

- ○ FOUND IRON PIPE
- □ FOUND IRON BAR
- (XX) RECORDED AS

TAX ID # ZGC00084A
JOB # 10-146

I have surveyed the above-described property and the above map is a true representation thereof and shows the size and location of the property, its exterior boundaries, the location and dimensions of all structures thereon, fences apparent easements and roadways and visible encroachments. if any.

This survey is made for the exclusive use of the present owners of the property, and also those who puchase, mortgage,or insure the title therto within one (1) year from date hereof, and as to them I warrant the accuracy of said survey map.

NOTE : BEARINGS ARE REFRENCED TO PREVIOUS SURVEYS OF RECORD

N W E S

SCALE 1"=20'

0 20 40 60 80

WISCONSIN
JOHN P. KROTT
S-2258
LAKE GENEVA WIS.
LAND SURVEYOR

DATED THIS 30th DAY OF AUGUST 2010.

JOHN KROTT S - 2258
Wisconsin Registered Land Surveyor
(original if signed in red)