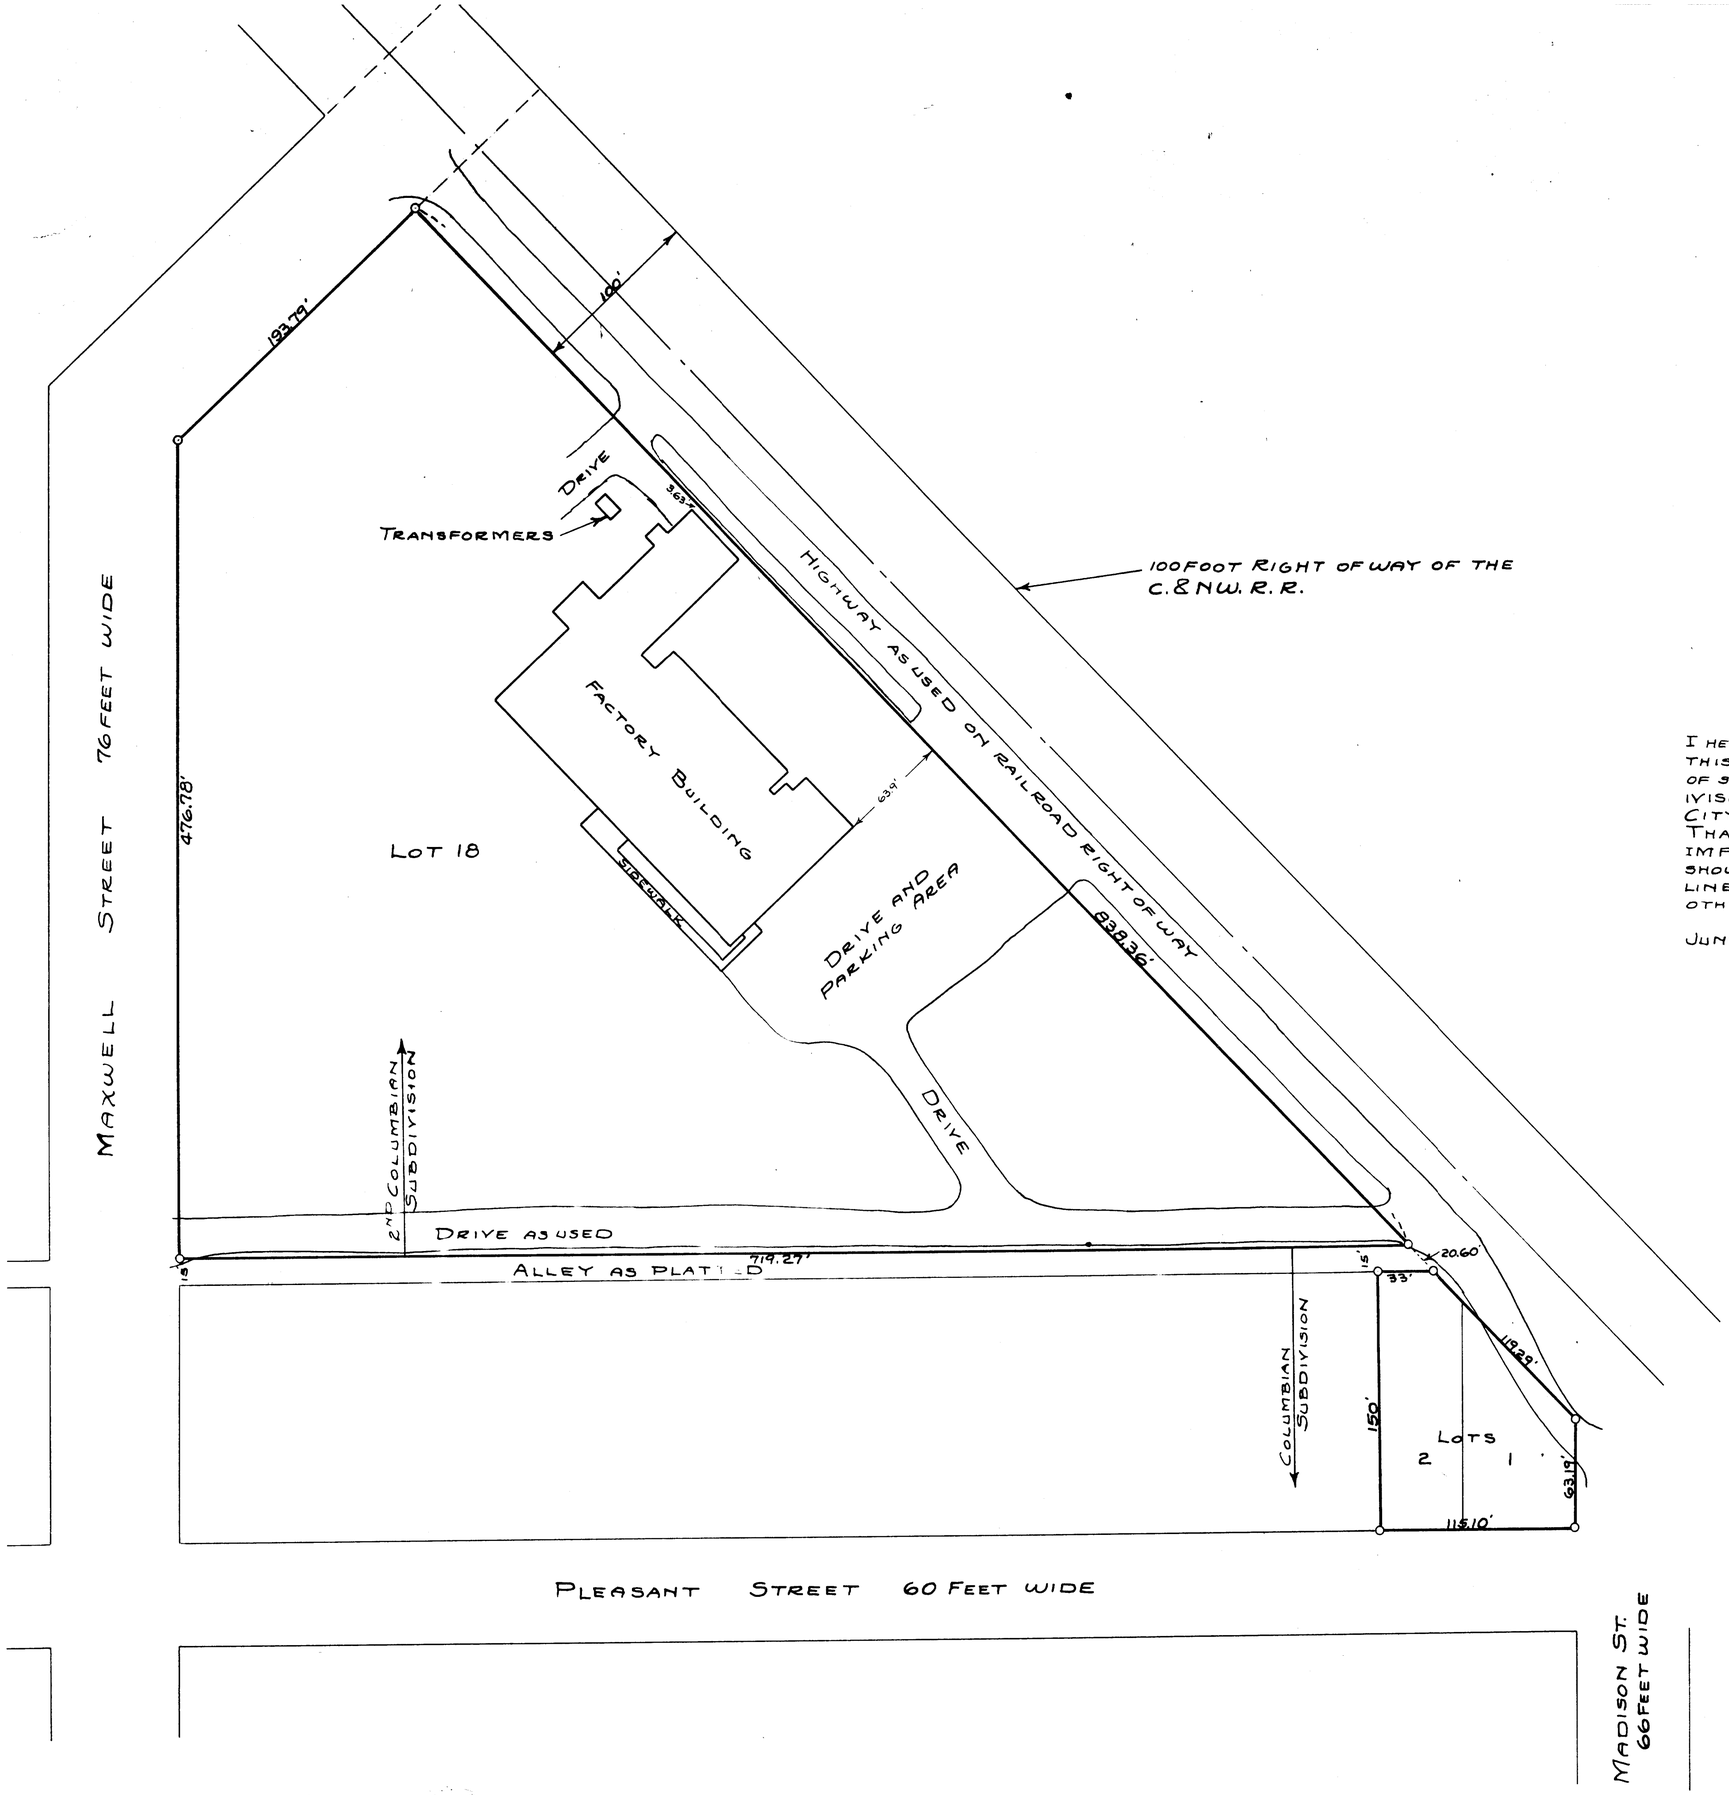


N

SCALE 1" = 50'

O - IRON PIPE

I HEREBY CERTIFY: THAT I HAVE SURVEYED THE LAND SHOWN ON THIS PLAT ACCORDING TO THE OFFICIAL RECORDS, THE DESCRIPTION OF SAID LAND IS AS FOLLOWS: LOT 18 OF 2ND COLUMBIAN SUBDIVISION AND LOTS 1 AND 2 OF COLUMBIAN SUBDIVISION OF THE CITY OF LAKE GENEVA, WALWORTH COUNTY WISCONSIN; THAT I HAVE LOCATED ALL BUILDINGS, FENCES AND OTHER IMPROVEMENTS THAT ARE ON THE PROPERTY; THAT THE PLAT SHOWN HEREON IS A CORRECT REPRESENTATION OF THE LOT LINES AND THE PRINCIPAL LINES OF ALL BUILDINGS AND OTHER IMPROVEMENTS THEREON.

Floyd L. Jensen
WALWORTH COUNTY SURVEYOR

JUNE 1952

PLAT OF SURVEY

CITY OF LAKE GENEVA, WISCONSIN

DRAWN BY G. DUNHAM	JENSEN & JOHNSON CIVIL ENGINEERS ELKHORN, WIS.	SCALE:
CHECKED BY L. L. JENSEN		REVISED
APPROVED BY		SHEET NO. OF