


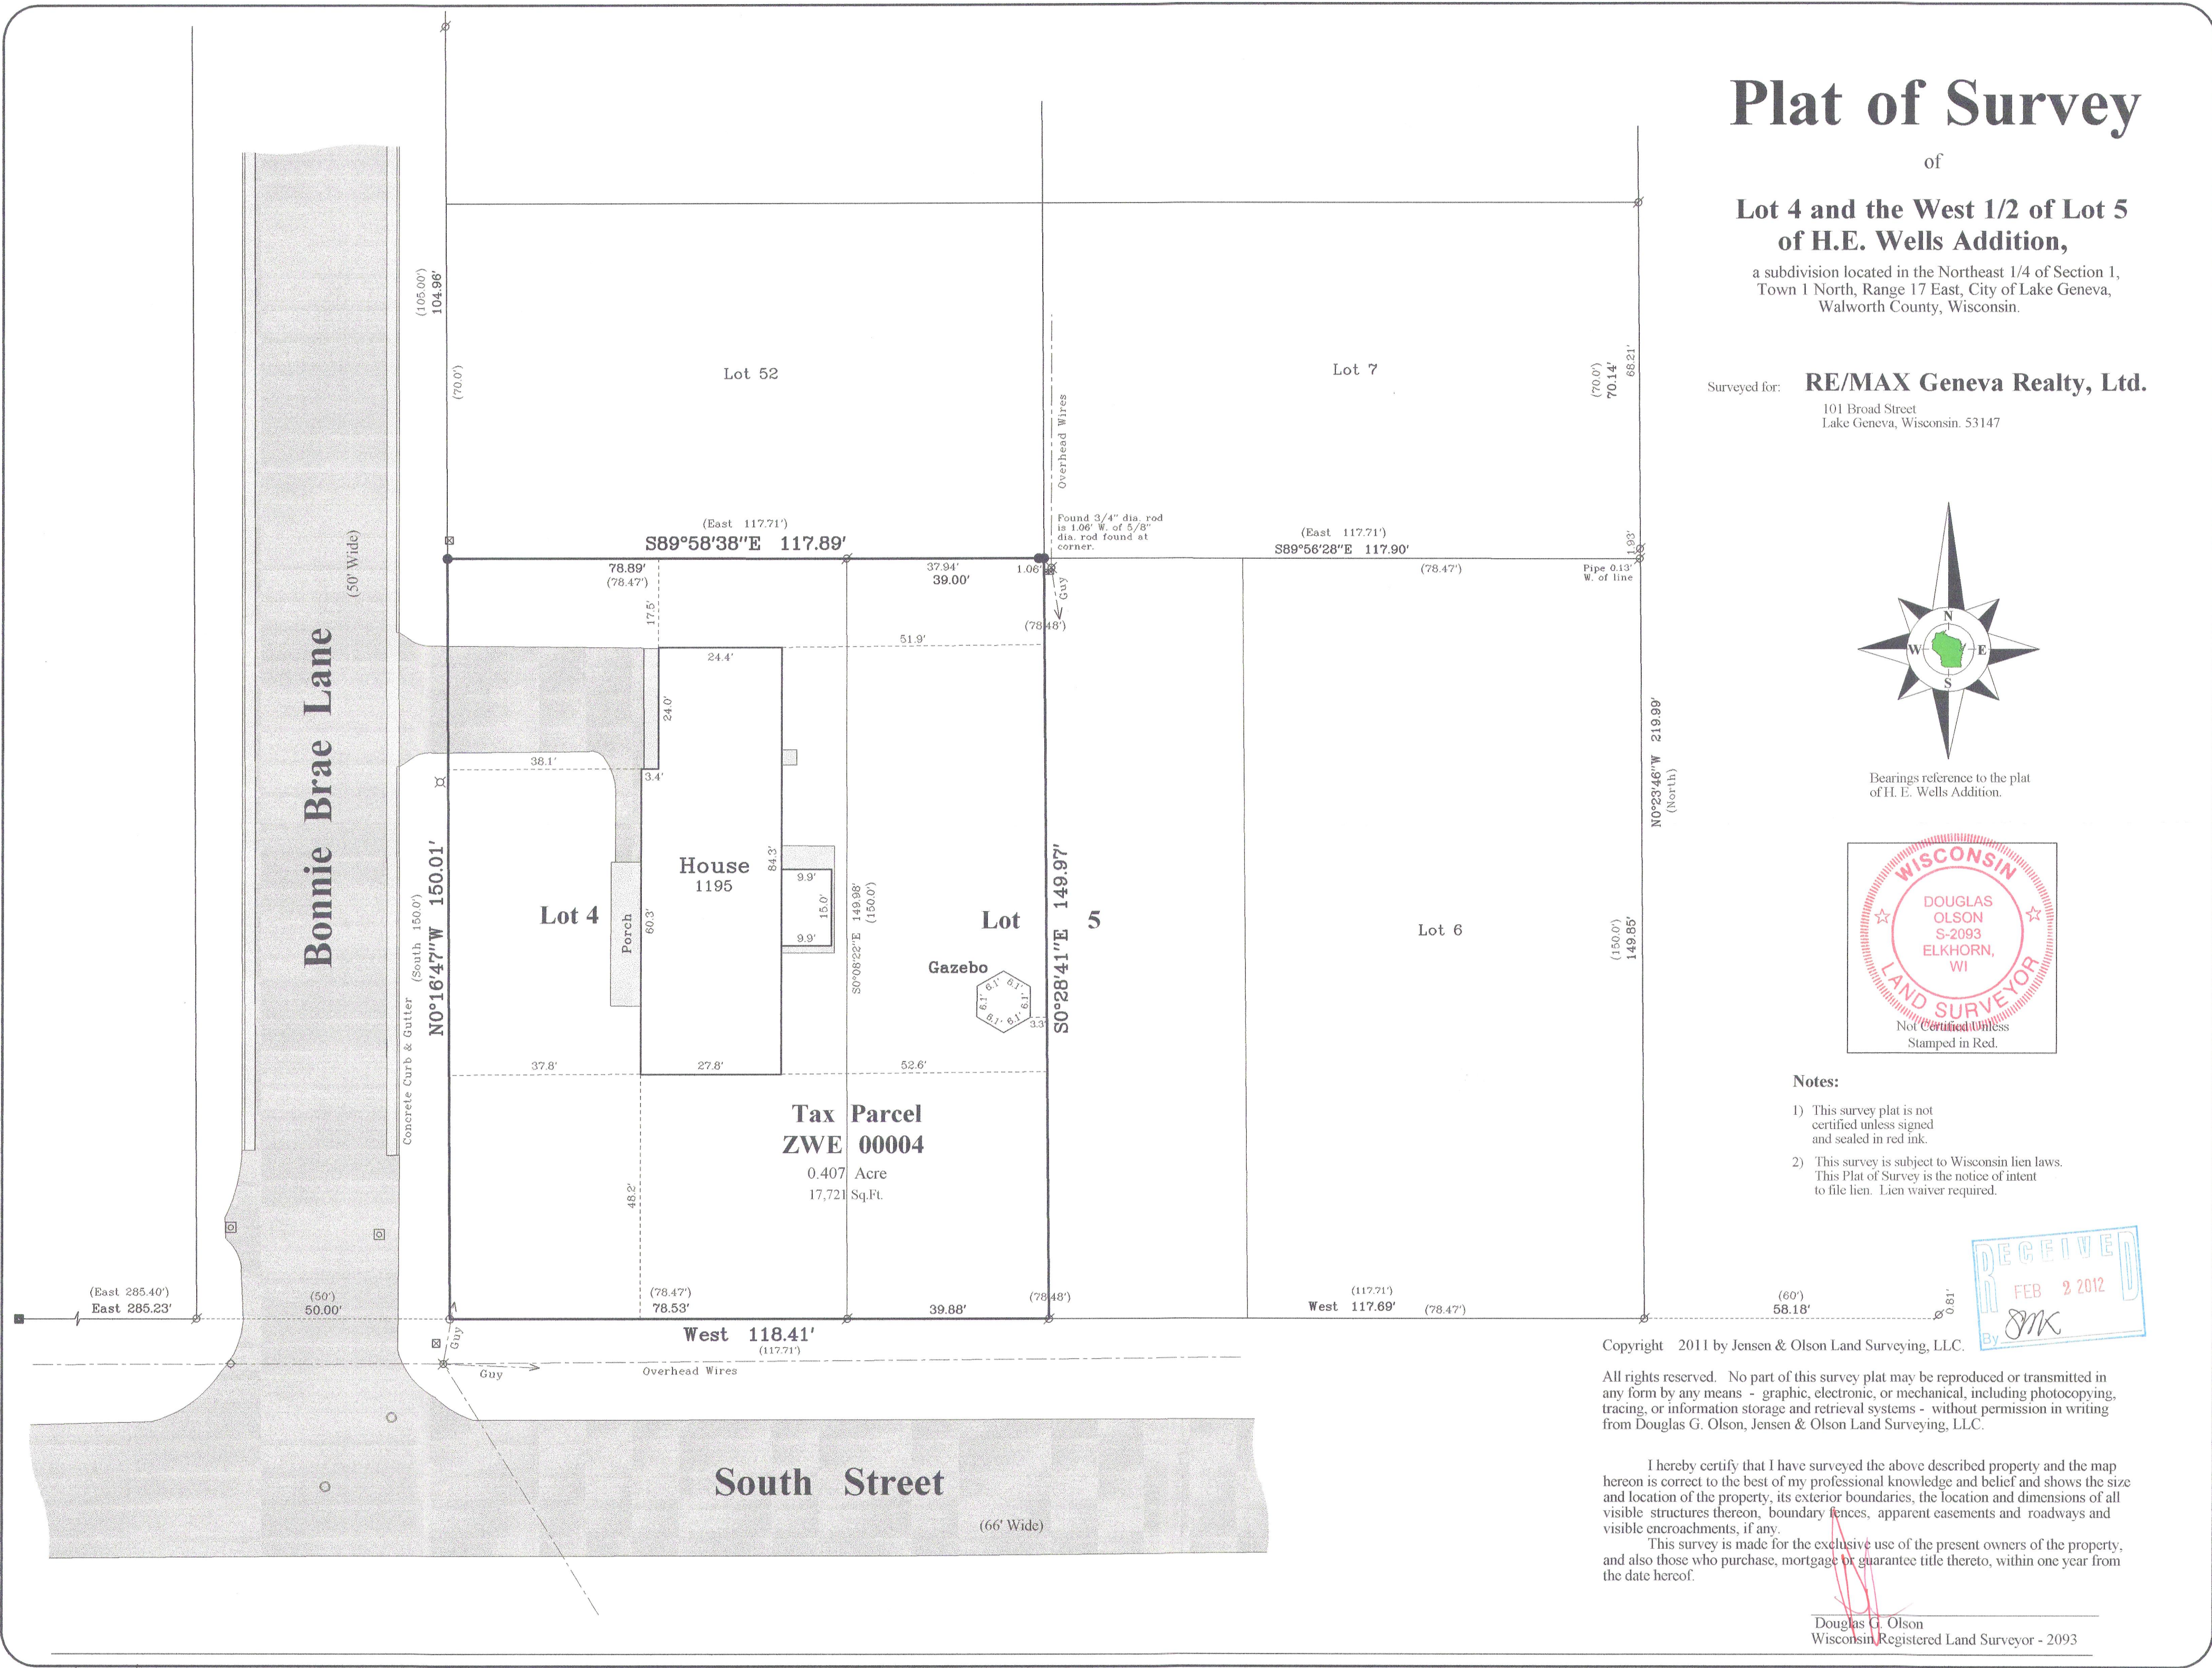

ZWE-4

007-2833