
46-22

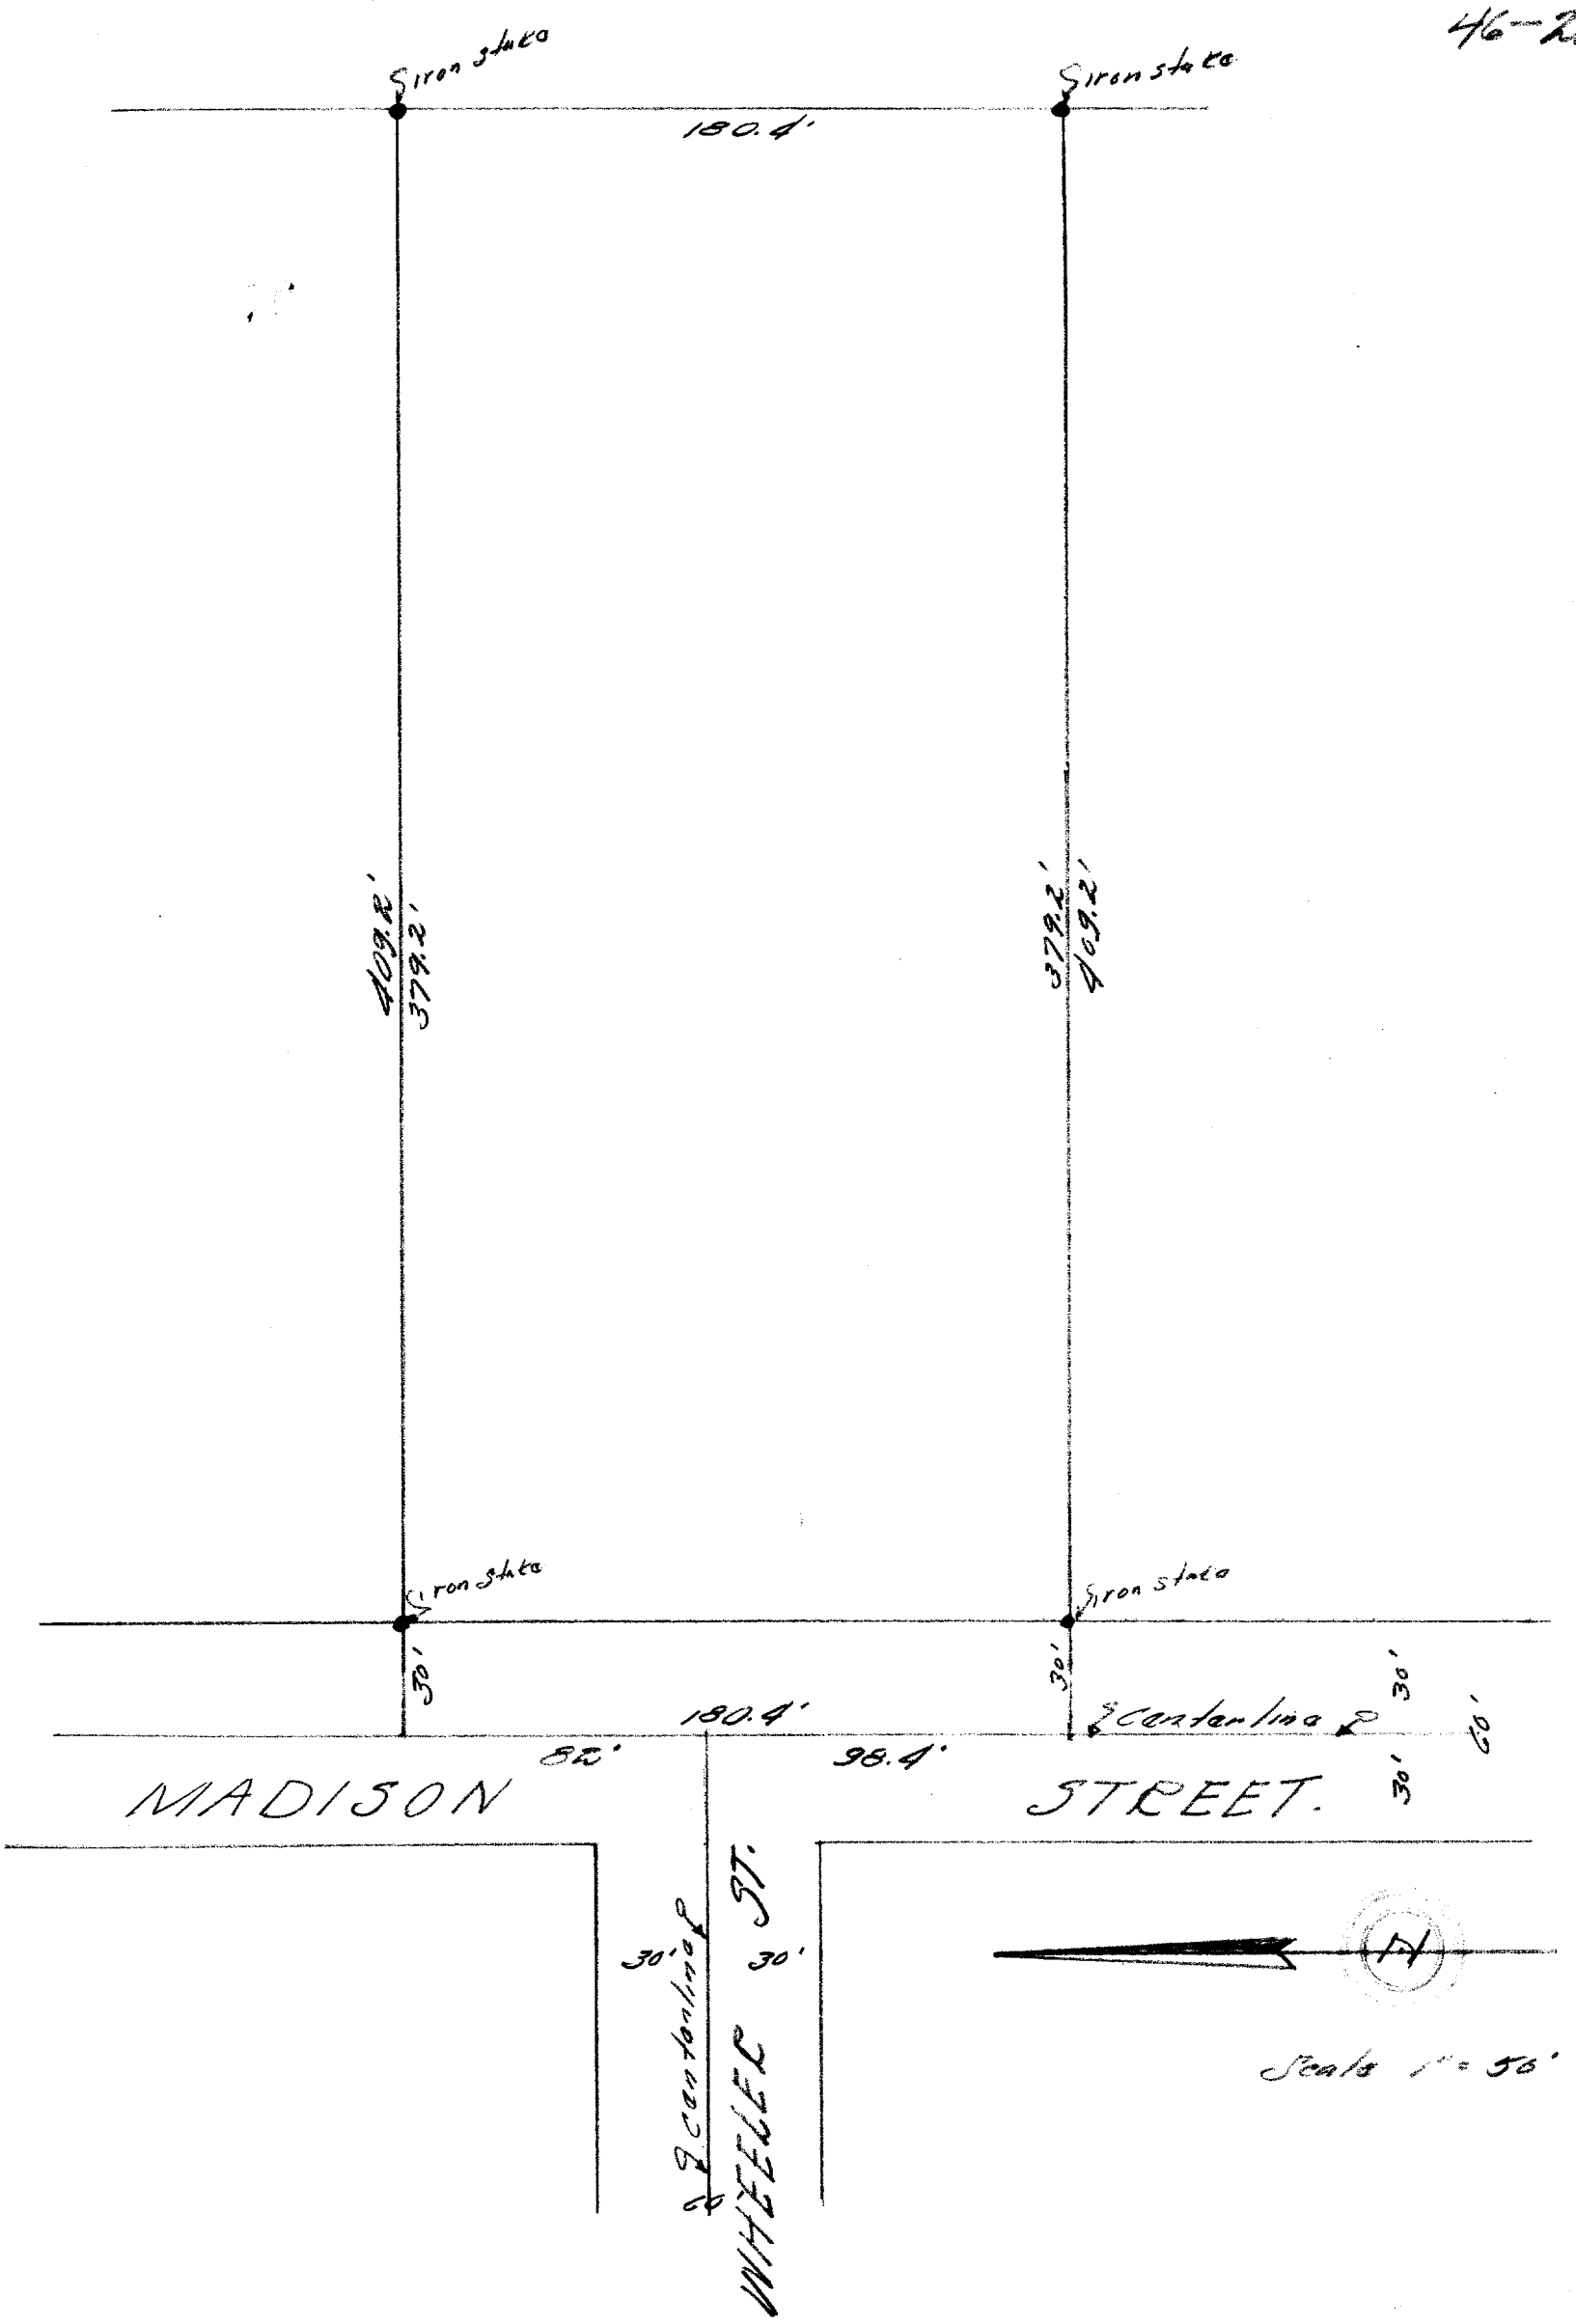

DESCRIPTION:

Commencing at a point in the centerline of Madison Street in the City of Lake Geneva, Walworth County Wisconsin., that is 98.4 feet South of the intersection of said centerline with the centerline of Wheeler Street in said city, thence East 409.2 feet to an iron stake, thence North 180.4 feet to an iron stake, thence West 409.2 feet to a point in the centerline of said Madison Street, thence South in the centerline of said Madison Street 82 feet to the place of beginning.

CERTIFICATE:

I, hereby certify that I have surveyed on this the tenth day of June 1946. surveyed the above described property according to the official records on file in the office of the Recorder of Deeds in and for Walworth County, Wisconsin, and find that the measurements and bearings of the boundary lines of said property as taken on this day substantially agree with those in the above description and that no encroachments exist.

SIGNED AND SEALED THIS 17TH DAY OF JUNE 1946.

Joseph M. Biagi.

Joseph M. Biagi. Professional Engineer.
Elkhorn Wisconsin.

UP-29A 29B

7-285B