


PREPARED FOR
SUSAN ALTER
1584 ORCHARD LN.
LAKE GENEVA, WI 53147

PLAT OF SURVEY

-OF-

KROTT SURVEYING INC.
N3705 WILLOW BEND LANE
LAKE GENEVA WI. 53147
PHONE # (262)248-3697
FAX # (262)249-0639

LOTS 8 AND 9, BLOCK 21, LAKE GENEVA MANOR TRACT NO. 17
A SUBDIVISION, IN THE CITY OF LAKE GENEVA, COUNTY OF
WALWORTH AND STATE OF WISCONSIN.

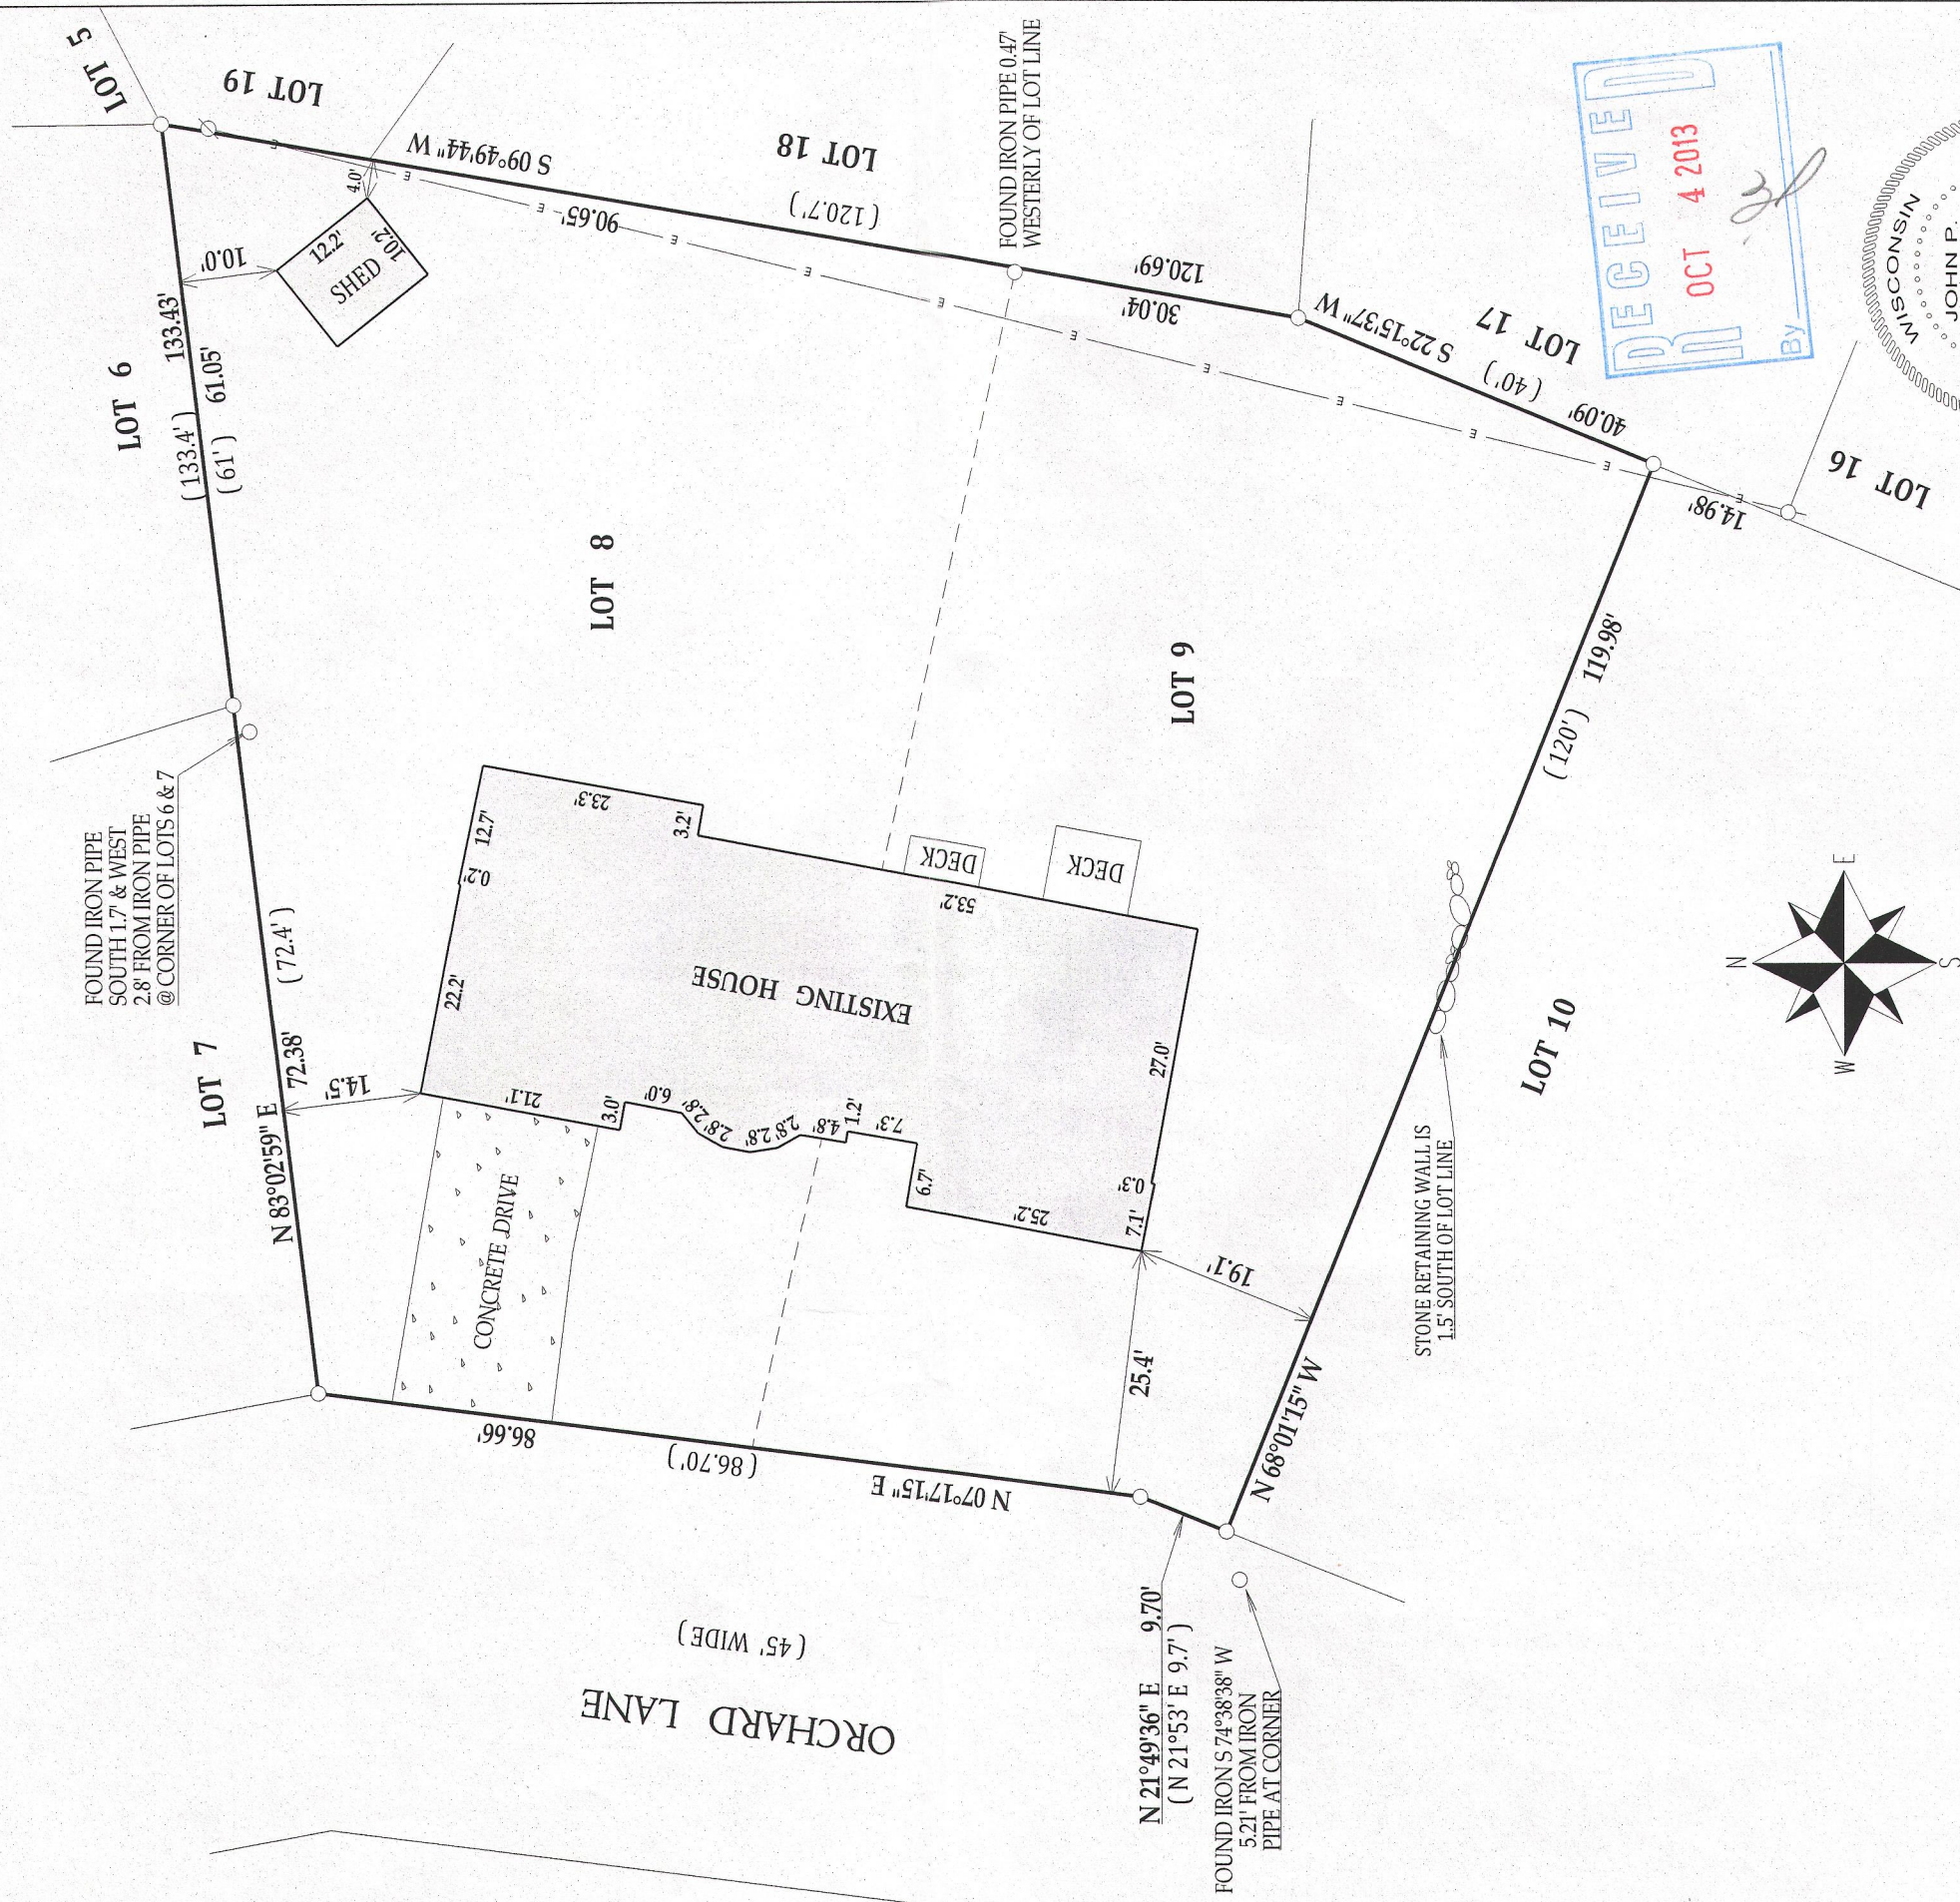


LEGEND

- FOUND IRON PIPE
- ⊘ UTILITY POLE
- OVERHEAD WIRES

(XX) RECORDED AS

TAX ID # Z1M00058


JOB # 13-138

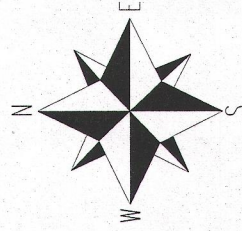

BEARINGS REFERENCED TO THE RECORD
PLAT OF LAKE GENEVA MANOR

I have surveyed the above-described property and the above map is a true representation thereof and shows the size and location of the property, its exterior boundaries, the location and dimensions of all structures thereon, fences apparent easements and roadways and visible encroachments, if any.


This survey is made for the exclusive use of the present owners of the property, and also those who purchase, mortgage, or insure the title thereto within one (1) year from date hereof; and as to them I warrant the accuracy of said survey map.

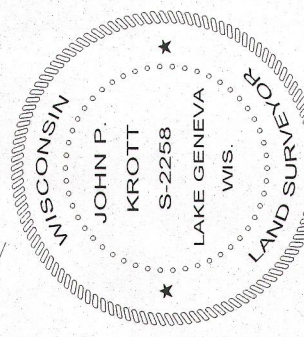

DATED THIS 10th, DAY OF SEPTEMBER, 2013

John P. Krott

JOHN KROTT S - 2258
Wisconsin Registered Land Surveyor
(original if signed in red)

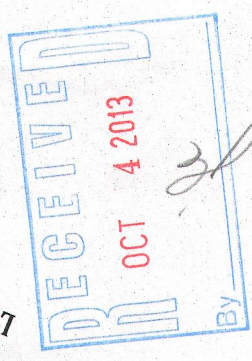

007-2979