
#3-66

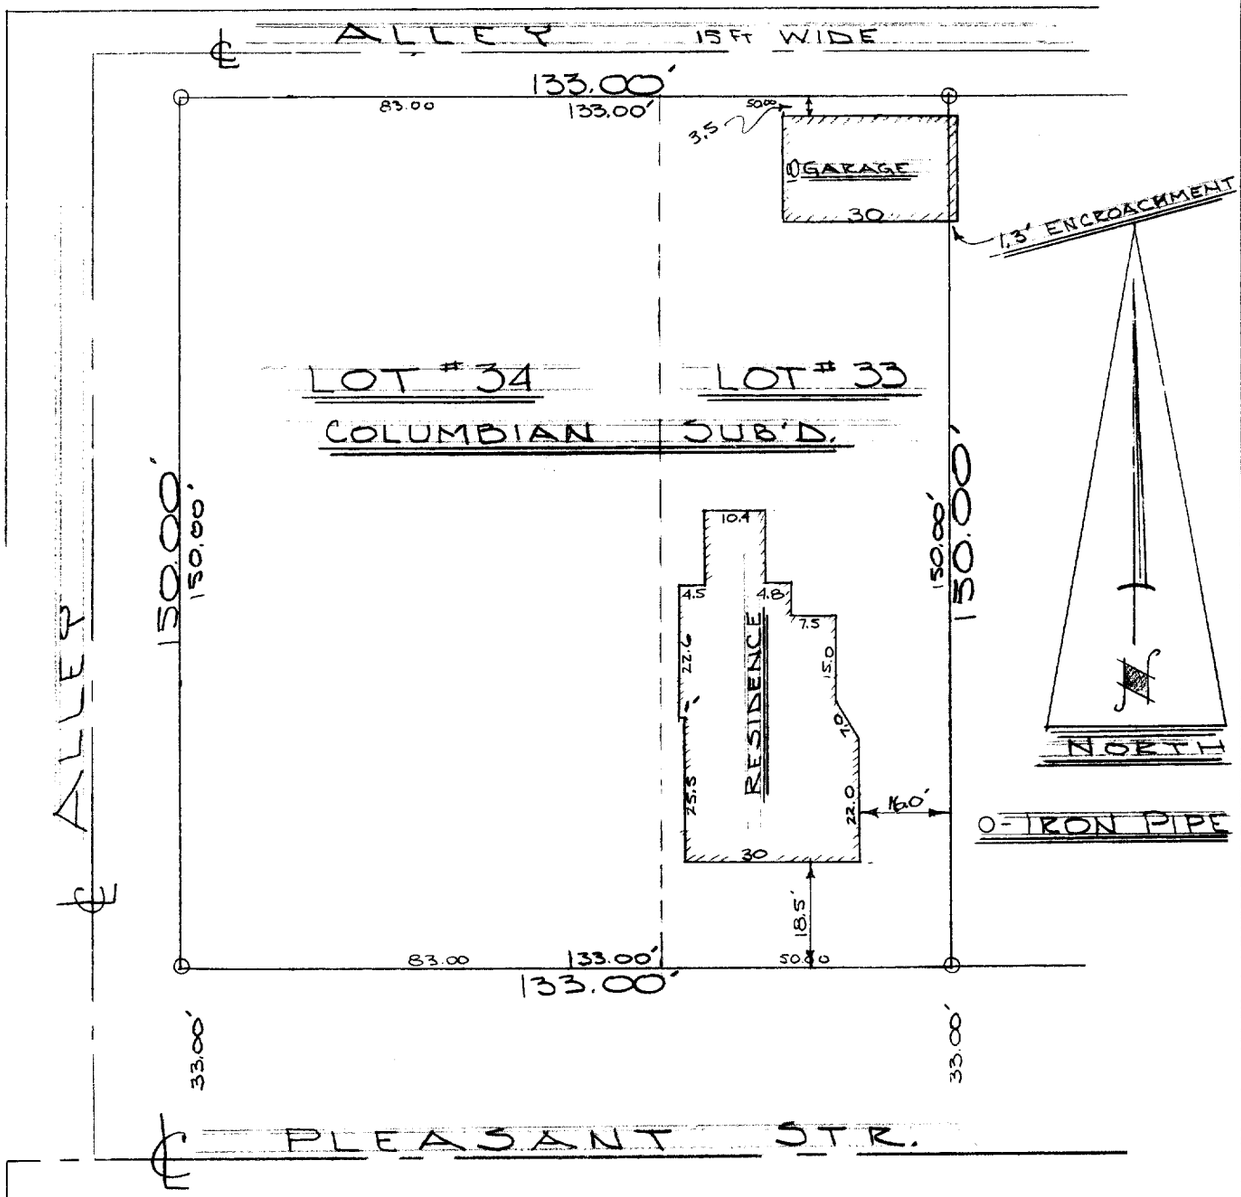

DESCRIPTION: Lots 33 and 34 in the Columbian Subdivision, so called, being a subdivision of parts of Section 25, and 26 in Township 2 North, Range 17 East, in the City of Lake Geneva in the county of Walworth and State of Wisconsin.

CERTIFICATE: I, hereby certify that I have surveyed the above mentioned property and that the hereon portrayed is an accurate survey and a true representation thereof and correctly shows the exterior boundary lines and the location of the buildings and the other improvements thereof.

January 3, 1966.

James F. Biagi

James F. Biagi, RLS 772

WISCONSIN
JAMES F. BIAGI
[redacted]
LAND SURVEYOR

CL 30A, 3

7-2B