
HAROLD H. KOLB

REGISTERED PROFESSIONAL LAND SURVEYOR
LAKE GENEVA, WISCONSIN

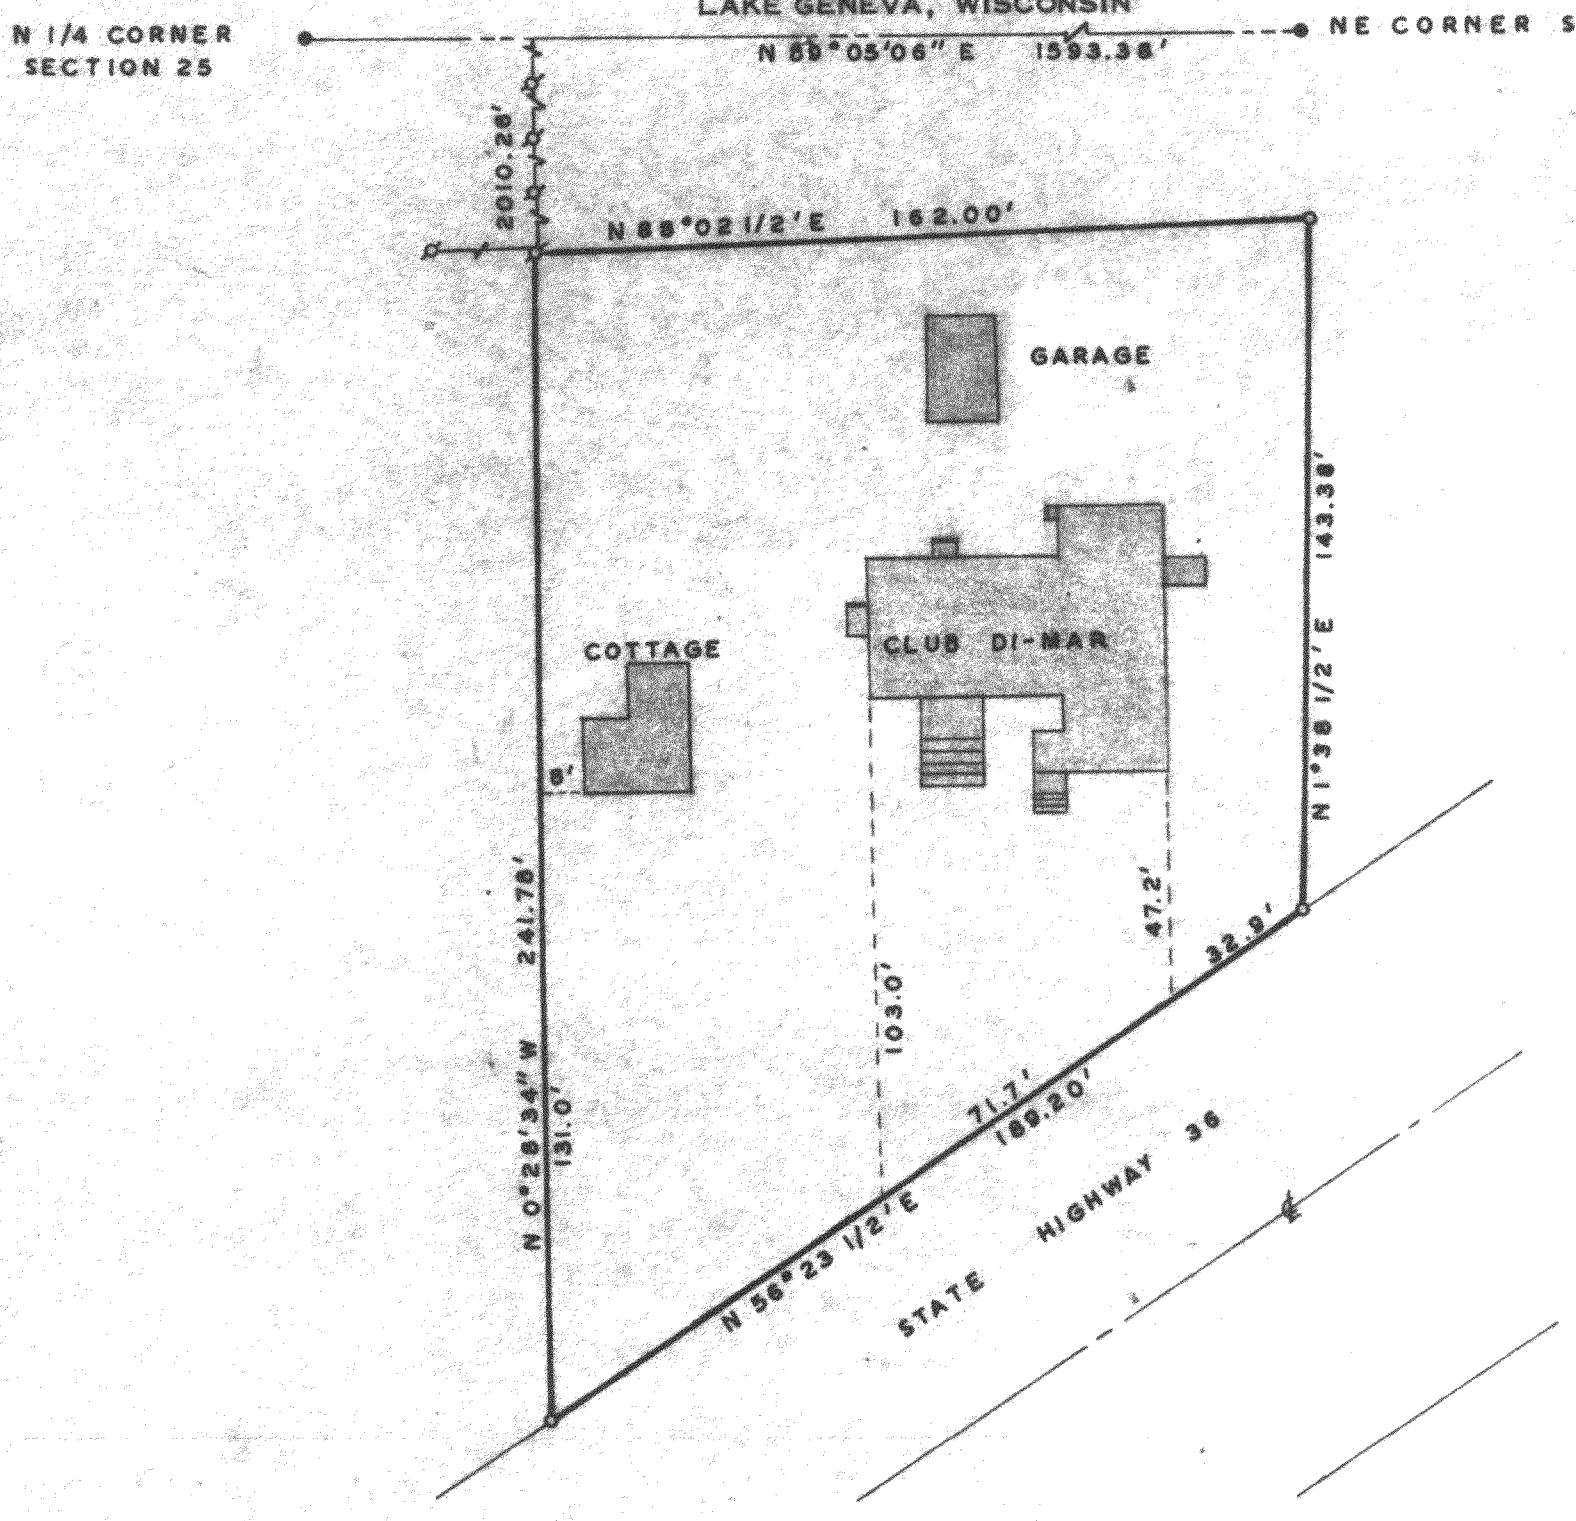

PLAT OF SURVEY OF

A parcel of land located in the Northeast 1/4 of Section 25, T 2 N, R 17 E, Walworth County, Wisconsin, as described in Volume 513, Page 62 of Deeds, Walworth County Register of Deeds Office, and more particularly described as follows; towit: Commencing at the Northeast corner of said Section 25; thence S 89°05'06" W 1593.38 feet; thence S 0°28'34" E 2010.28 feet to the place of beginning; thence N 88°02 1/2' E 162.00 feet; thence S 1°38 1/2' W 143.38 feet; thence S 56°23 1/2' W 189.20 feet; thence N 0°28'34" W 241.78 feet to the place of beginning.
NOTE: All bearings are based on the Wisconsin plane coordinate sustem.

N

SCALE: 1"=40'

LEGEND

Ø — IRON PIPE FOUND
O — IRON PIPE PLACED
● — CONCRETE MONUMENT
X — SPIKE

I, HAROLD H. KOLB, DO HEREBY CERTIFY THAT I HAVE SURVEYED THE PROPERTY HEREON DESCRIBED ACCORDING TO THE OFFICIAL RECORDS, AND THAT THE PLAT HEREON IS A CORRECT REPRESENTATION OF THE LOT LINES, and the principle lines of the buildings thereon.

Harold H. Kolb
HAROLD H. KOLB
WISCONSIN REGISTERED LAND SURVEYOR, S-187
DATE November 23, 1965

UP-137M

~~27~~-305 K