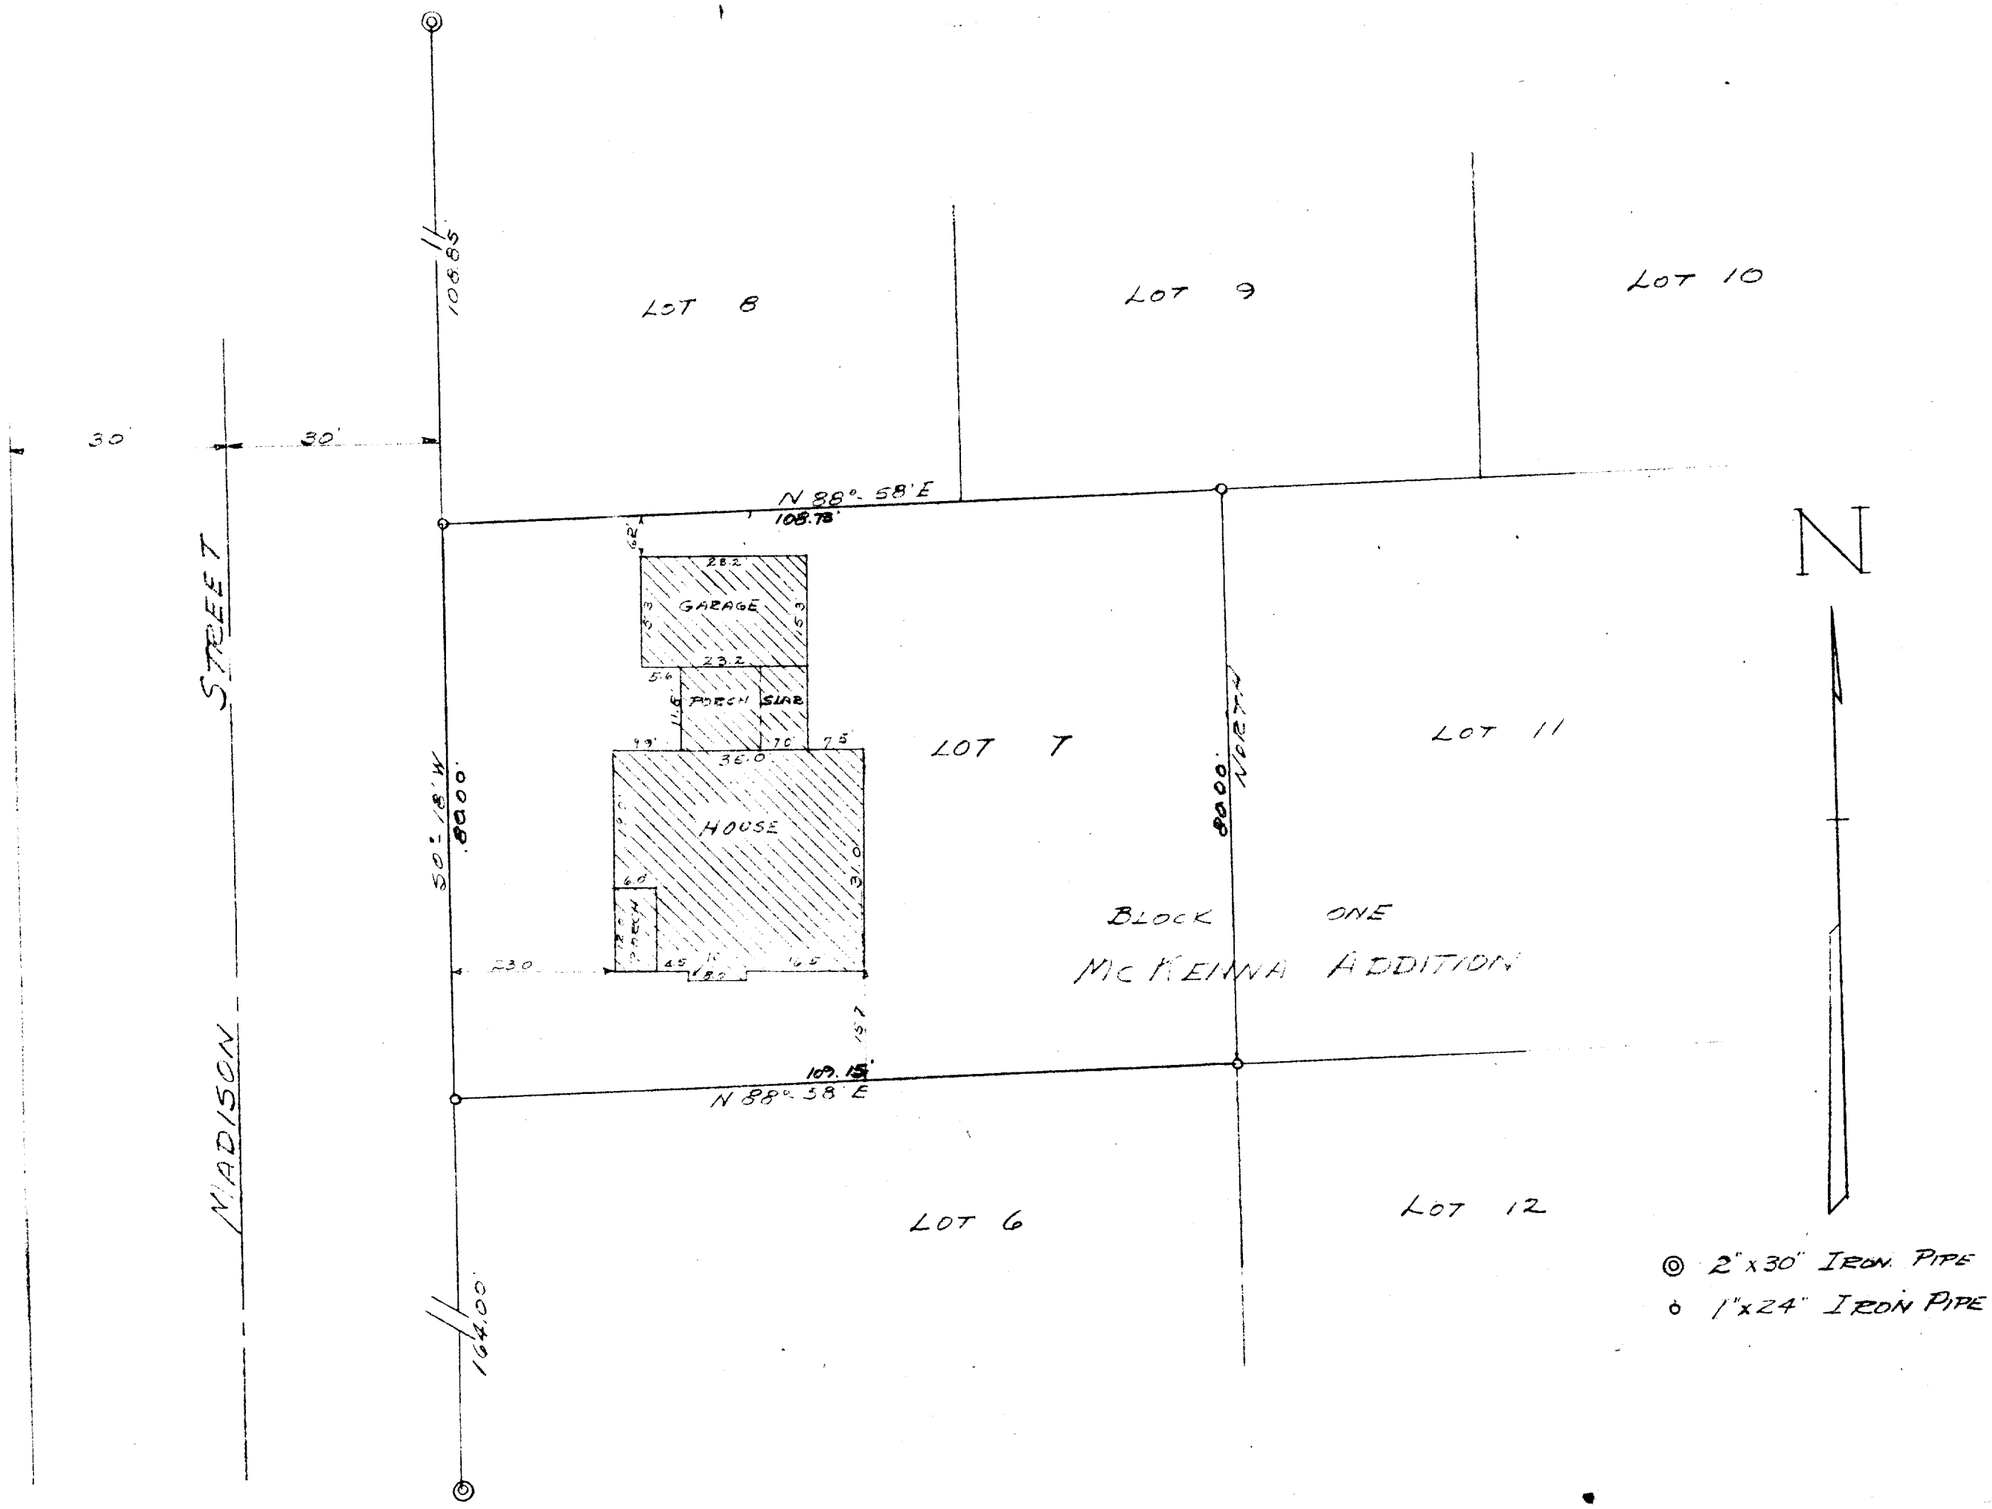


STATE OF WISCONSIN)
COUNTY OF WALWORTH) ss

I, LLOYD L. JENSEN, DO HEREBY CERTIFY THAT I HAVE SURVEYED THE PROPERTY DESCRIBED HEREON ACCORDING TO THE OFFICIAL RECORDS, AND THAT THE PLAT ABOVE IS A CORRECT REPRESENTATION OF THE LOT LINES AND PRINCIPAL LINES OF BUILDINGS THEREON.

ELKHORN, WISCONSIN Oct. 7 1954.

Lloyd L Jensen
COUNTY SURVEYOR

PLAT OF SURVEY
OF

LOT 7, BLOCK ONE OF "McKENNA ADDITION" SECTION 25 T2N R17E OF WALWORTH COUNTY WISCONSIN

Lloyd L Jensen
SURVEYOR

SCALE 1" = 20' DATE Oct. 7, 1954

M2-1

7-31 J