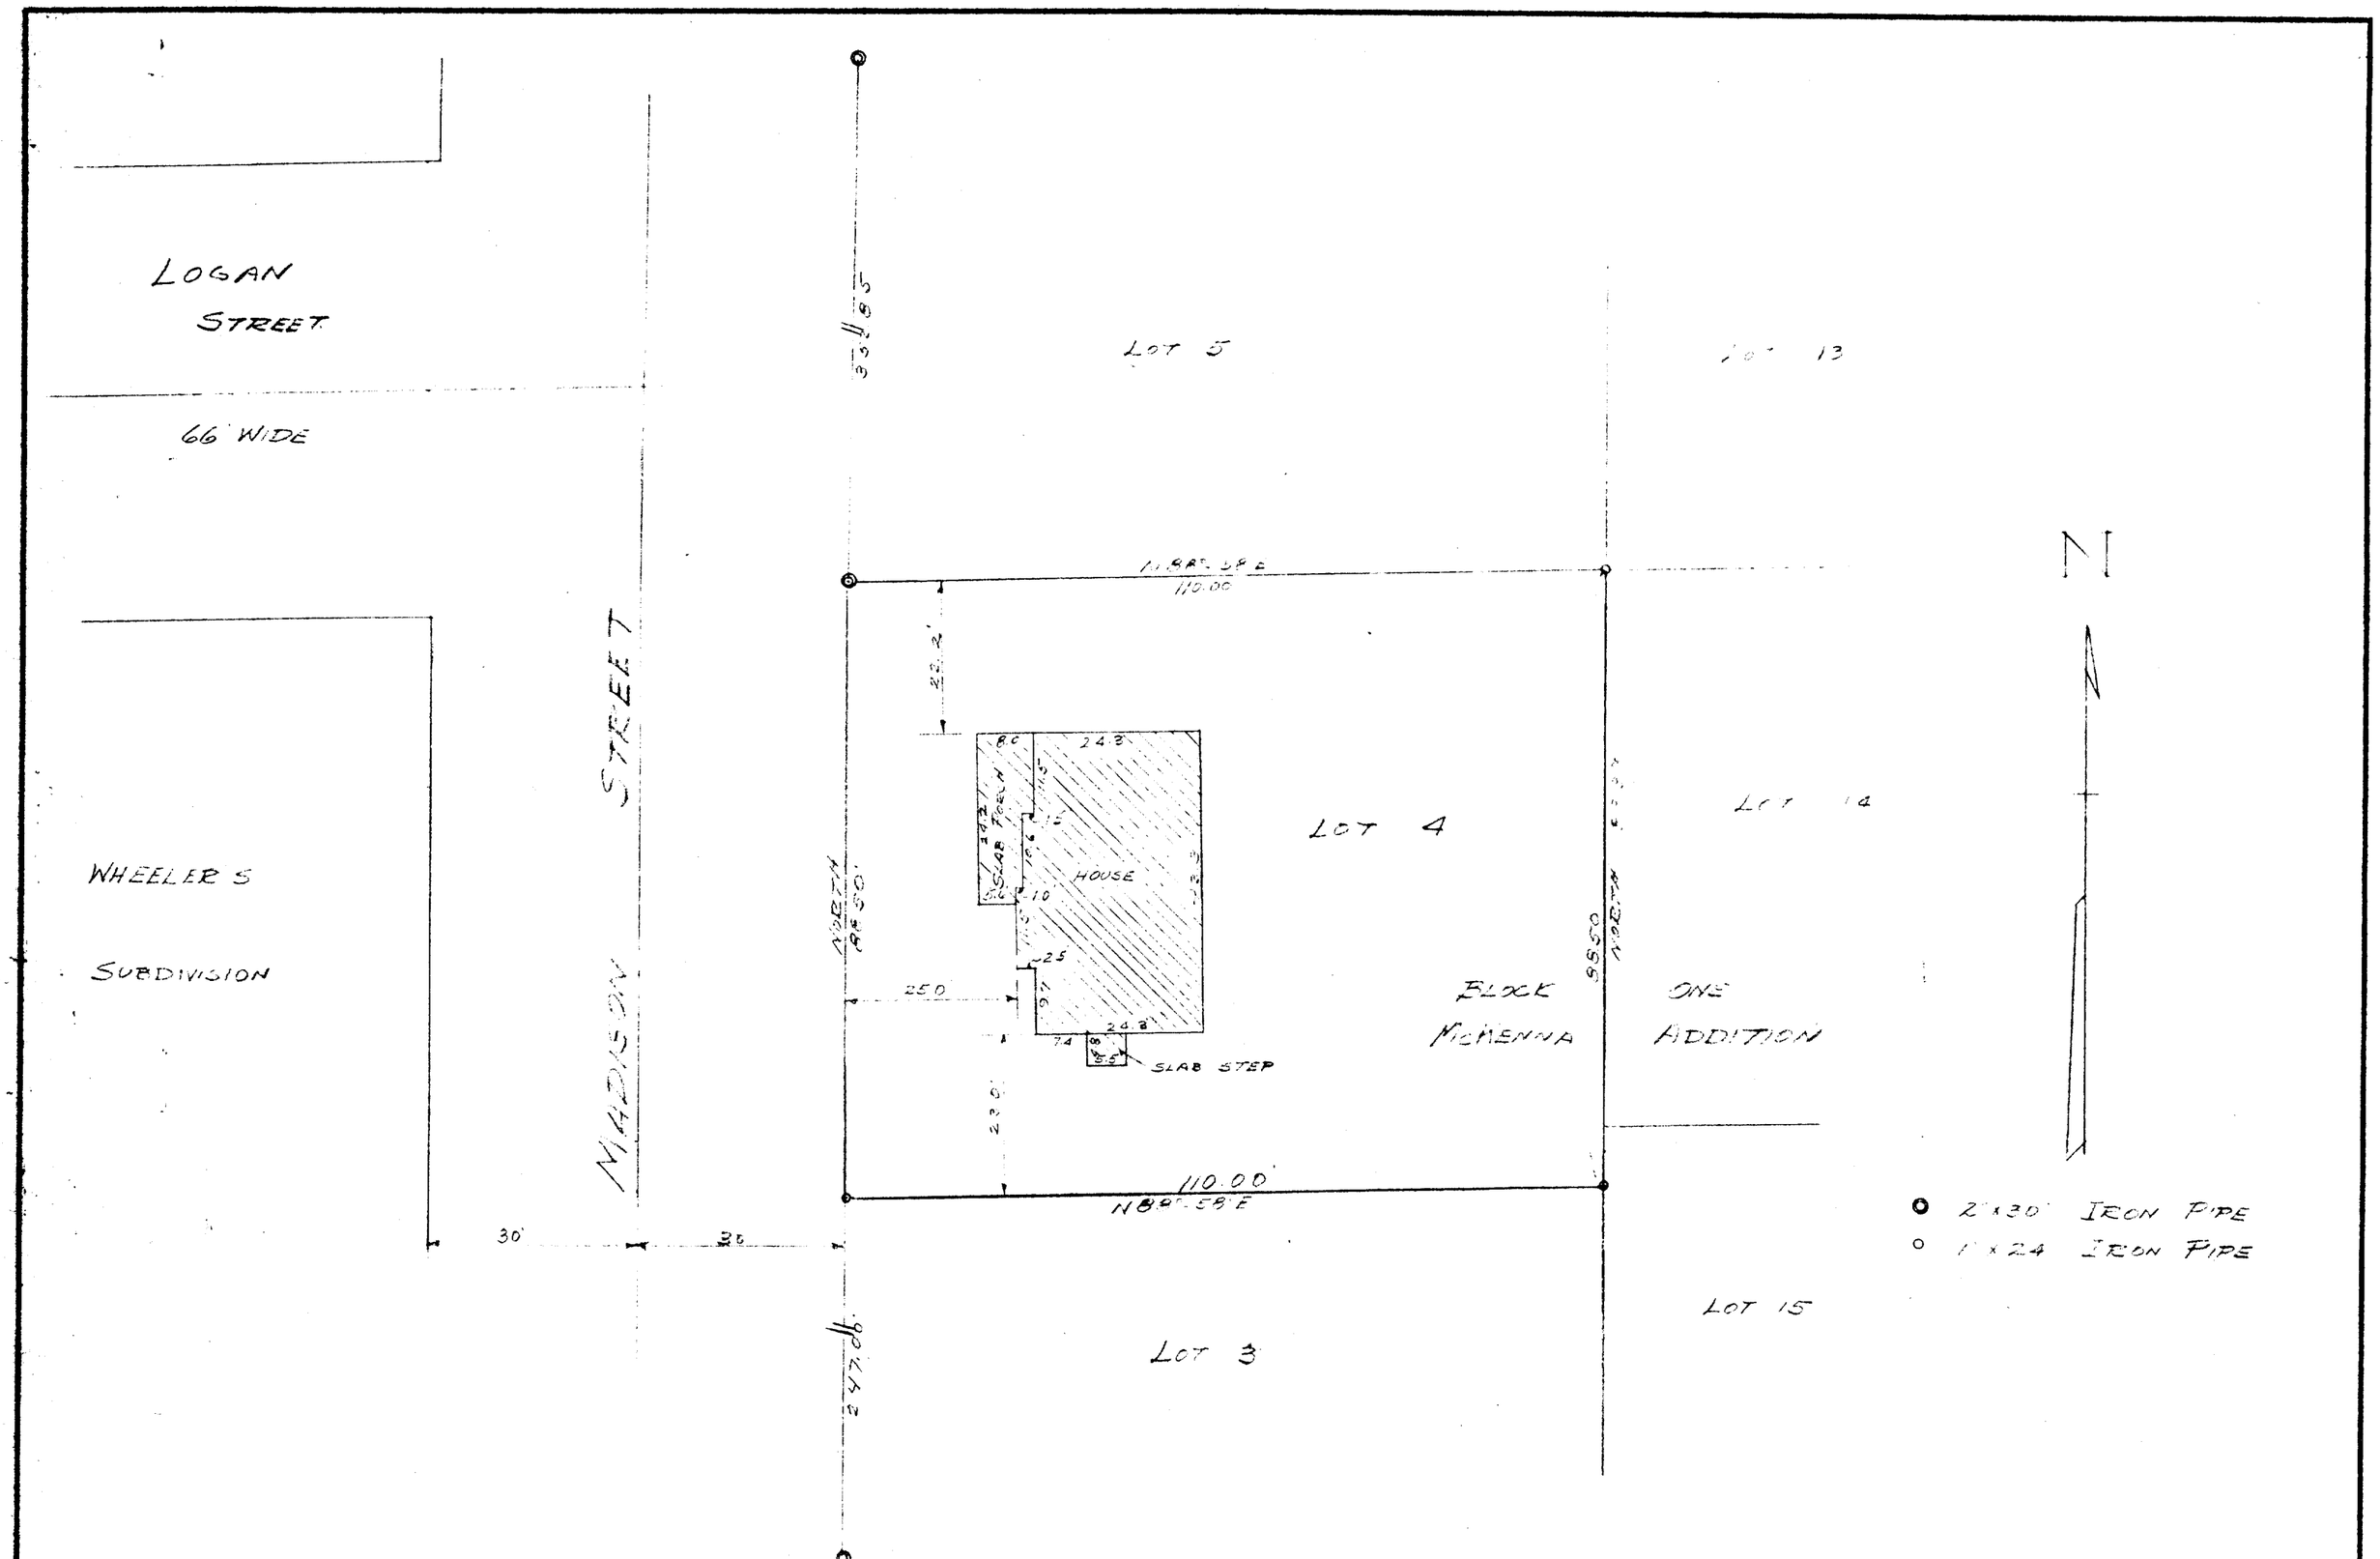

STATE OF WISCONSIN) ss
COUNTY OF WALWORTH)

I, LLOYD L. JENSEN, DO HEREBY CERTIFY THAT I HAVE SURVEYED THE PROPERTY DESCRIBED HEREON ACCORDING TO THE OFFICIAL RECORDS, AND THAT THE PLAT ABOVE IS A CORRECT REPRESENTATION OF THE LOT LINES AND PRINCIPAL LINES OF BUILDINGS THEREON.

ELKHORN, WISCONSIN Oct. 7 1954.

Lloyd L. Jensen
COUNTY SURVEYOR

I HEREBY CERTIFY THAT THE PLAT SHOWN HEREON IS A CORRECT REPRESENTATION OF THE LOT LINES AND PRINCIPAL LINES OF BUILDINGS THEREON AS OF THIS DATE.
JUNE 12, 1957 Lloyd L. Jensen
COUNTY SURVEYOR

I HEREBY CERTIFY THAT THE PLAT SHOWN HEREON IS A CORRECT REPRESENTATION OF THE LOT LINES AND PRINCIPAL LINES OF BUILDINGS THEREON AS OF THIS DATE.
AUGUST 12, 1958 Lloyd L. Jensen
COUNTY SURVEYOR

WISCONSIN LLOYD L. JENSEN S-211 ELKHORN, WIS. LAND SURVEYOR

PLAT OF SURVEY
OF

LOT 4, BLOCK ONE OF "McKENNA ADDITION" SECTION 25 T2N R17E OF WALWORTH COUNTY WISCONSIN

Lloyd L. Jensen
SURVEYOR

SCALE 1" = 20 DATE Oct. 7, 1954

Mc-4

NO. 177N—400—3-10-53

7-32 J