6 Dec. 5/31 M. R. Titner
Lot 21 Block 31 – Manor

By request of M. R. Titner surveyed lot 21, Block 31 L. G. Manor.

Measured N. on E. side of Lake View Ave. (W. side Block 21) 240' (at 120' found wood stk. in shrubbery, s.w. cor. lot 12), thence N.W. in same line 45' E. Orchard Lane, found no stk but set iron stk 1' E. of walk and 10' N. of back of curb on E. Orchard Lane: Thence E. on N. side of Lane 64.5' and found iron stk. 10' N. of back of curb: thence in same line N.E. 70.1 and found iron stk. ~~64.5~~ 9.5' from back of curb. Thence N.E. in same line 70.1. found No stk. made point N.W. from S.E. cor. 21. 88.5' and found iron stk. Thence N.E. 50' and found old stk hole with 60d spike in it: set iron stk: Measured S.E. 115' and corrected point at N.E. Cor. Lot 21 and set iron stk. all O.K.

See plat on opp. page.

S. G.
R. M.

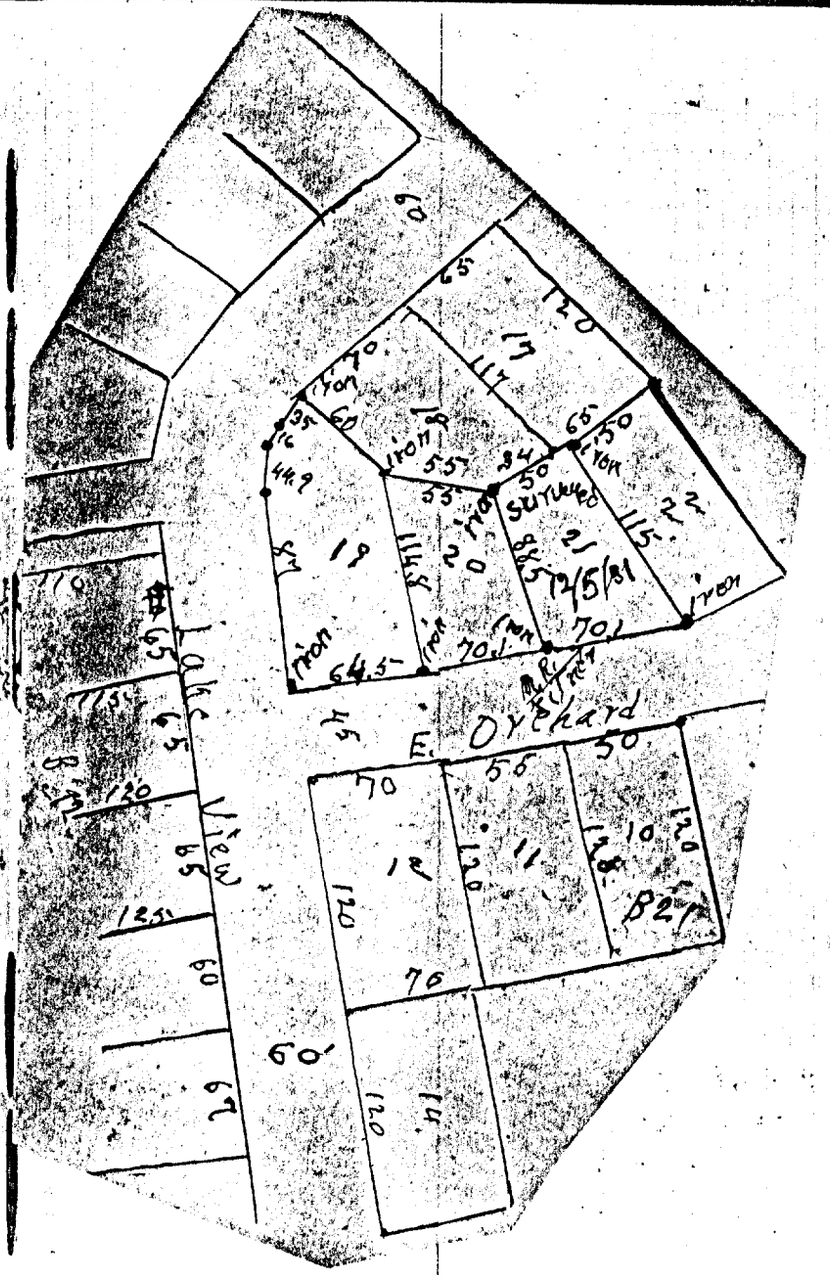

Lot 21 Blk 31 Lake View Manor

LM-79

7-330-Sk