— WORK ORDERED BY —
PAUL LAUTERBACH
LAKE GENEVA TENNIS CLUB
914 BENNETT COURT
WALWORTH, WI. 53184

PLAT OF SURVEY
LAKE GENEVA TENNIS
LOT 48 OF LAKE GENEVA BUSINESS PARK PHASE II
CITY OF LAKE GENEVA, WALWORTH COUNTY, WISCONSIN

LEGEND
○ = FOUND IRON PIPE STAKE
● = SET IRON REBAR STAKE
(XXX) = RECORDED AS

ASSIGNED N. LINE OF LOT 48
N 89°53'43" E

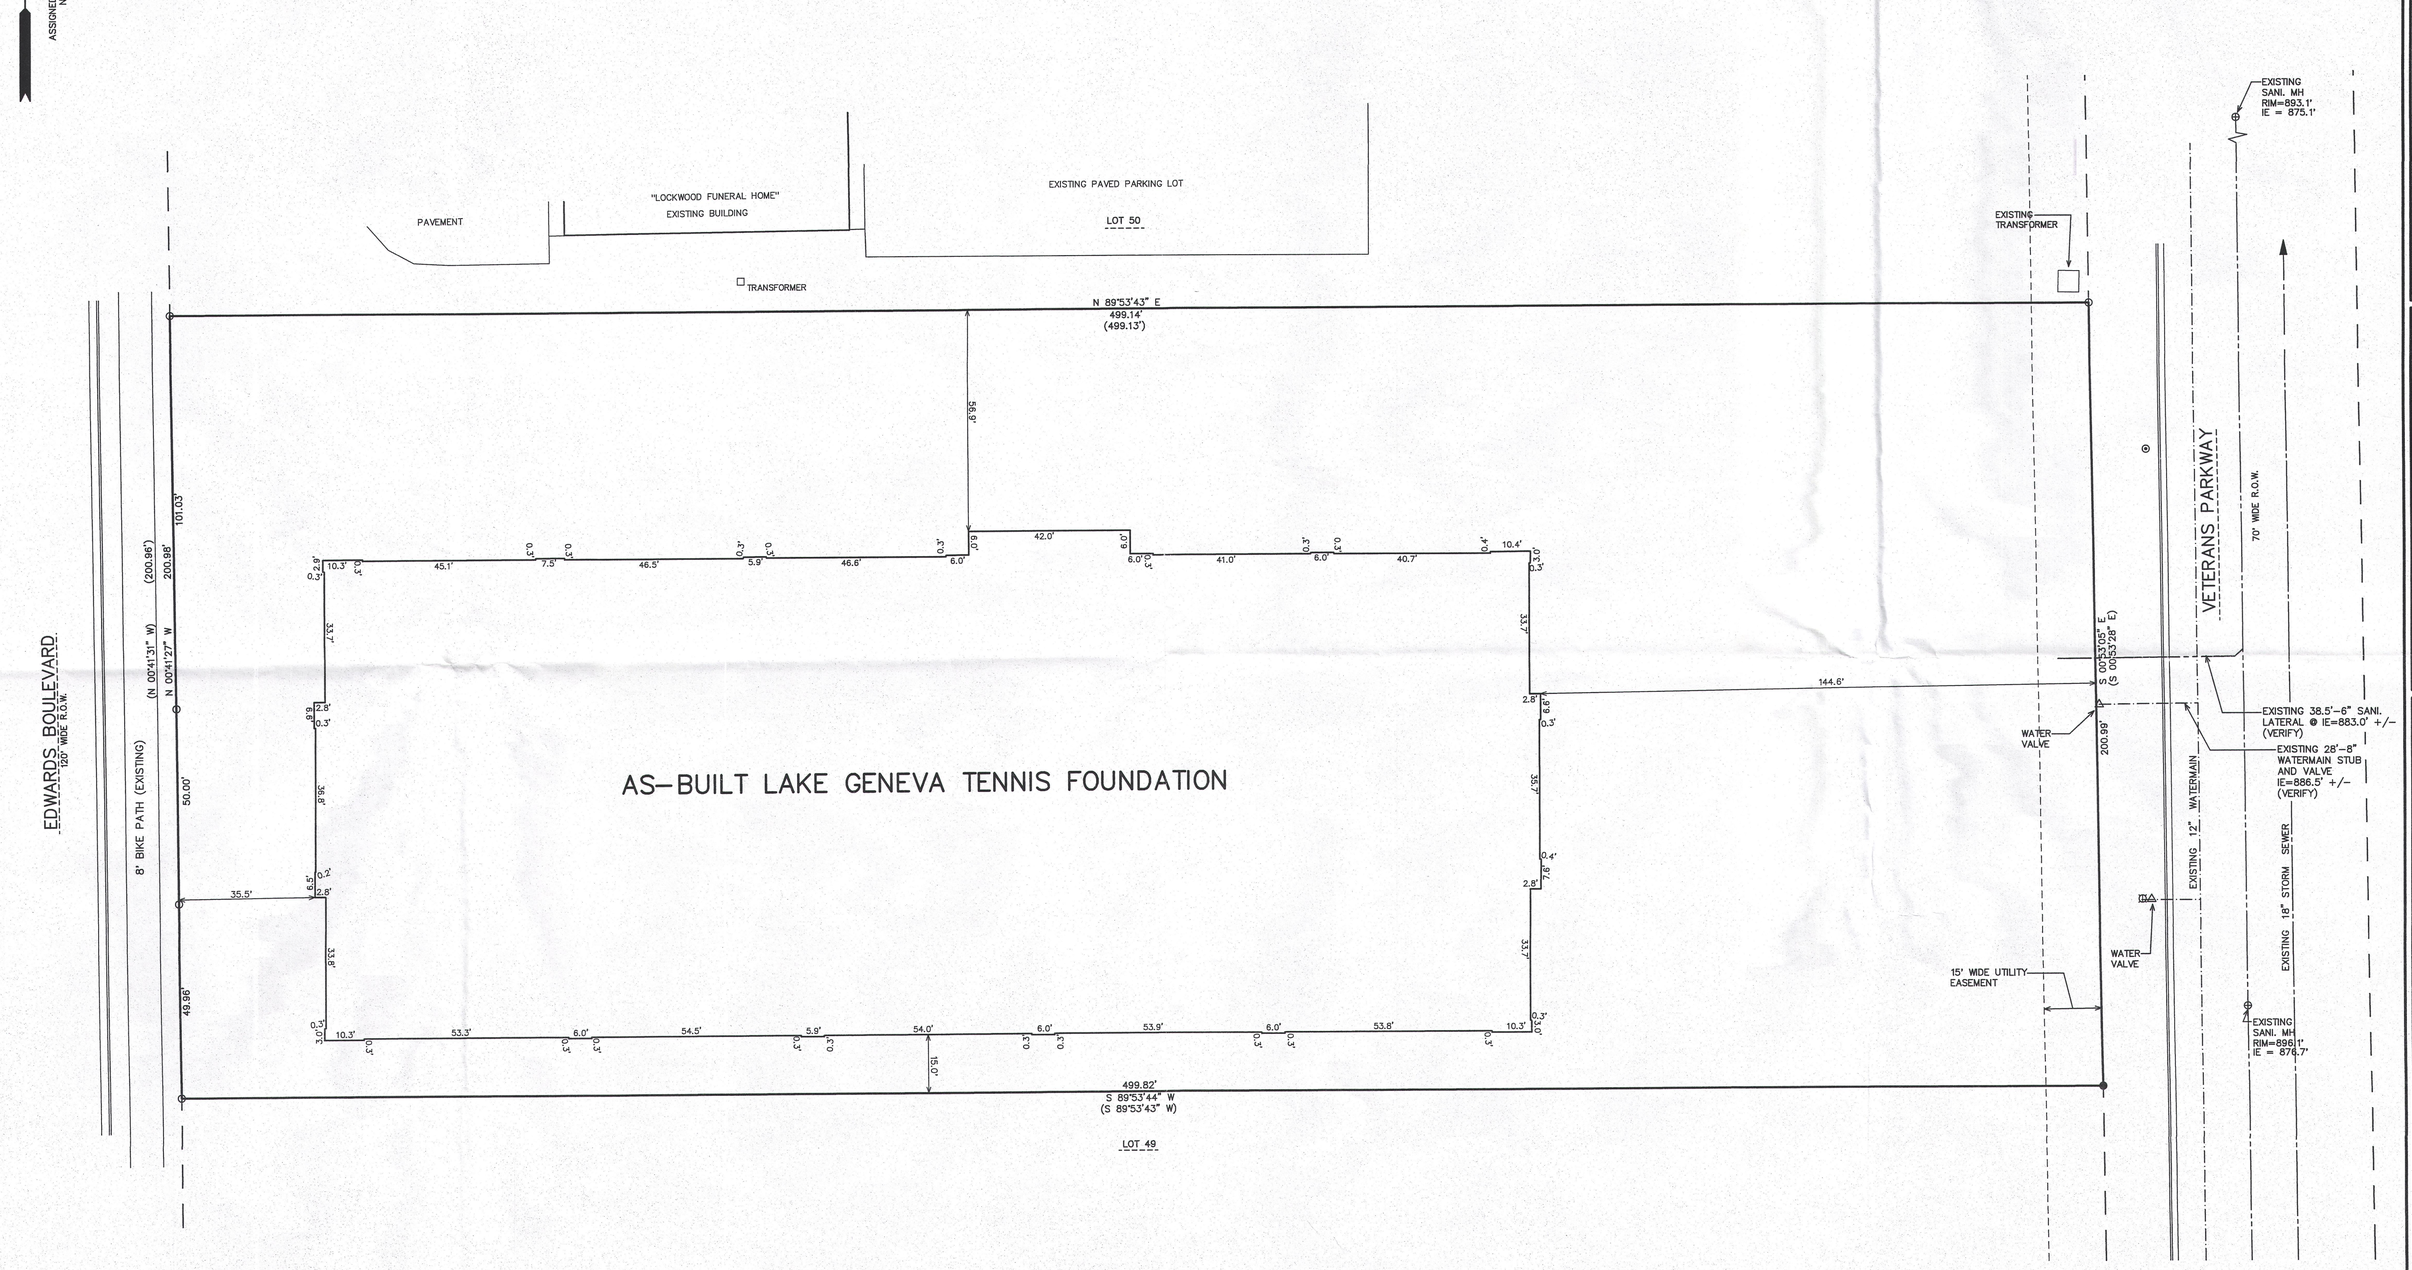

MAP SCALE IN FEET ORIGINAL 1" = 20'

NOTE: COPIES OF THIS MAP TO WHICH THE FOLLOWING CERTIFICATE WILL APPLY SHOW THE SURVEYOR'S ORIGINAL SEAL AND SIGNATURE IN RED INK. COPIES BY ANY OTHER MEANS MAY HAVE ALTERATIONS WHICH DO NOT REPRESENT THE SURVEYOR'S WORK PRODUCT.

I HEREBY CERTIFY THAT THE ABOVE DESCRIBED PROPERTY HAS BEEN SURVEYED UNDER MY DIRECTION AND THAT THE ABOVE MAP IS A TRUE REPRESENTATION THEREOF AND SHOWS THE SIZE AND LOCATION OF THE PROPERTY AND ITS EXTERIOR BOUNDARIES. THIS SURVEY IS MADE FOR THE USE OF THE PRESENT OWNERS OF THE PROPERTY, AND ALSO THOSE WHO PURCHASE, MORTGAGE, OR GUARANTEE THE TITLE THERETO WITHIN ONE YEAR FROM THE DATE HEREOF.

DATED: 9/11/2015

REVISED 8/1/2016-KB
TO SHOW SIZE & LOCATION OF AS-BUILT FOUNDATION

PETER S. GORDON P.L.S. 2101

RECEIVED
NOV 01 2016
BY:

WISCONSIN
PETER S. GORDON
S-2101
ELKHORN, WI
LAND SURVEYOR

AUG 02 2016

8/1/2016 X:\Projects\9368\DCAD\ASBUILT.dgn

ZLGBP3-30 007-3320

LAKE GENEVA TENNIS

PLAT OF SURVEY

FARRIS, HANSEN & ASSOCIATES, INC.
Engineering, Architecture, Surveying

REVISION

PROJECT 93

DATE 9/11

SHEET N 1