

# PLAT OF SURVEY

-OF-

LOT 92 AND THE NORTH 62 FEET OF LOT 93 IN STURWOOD ADDITION NO. 3, ACCORDING TO THE RECORDED PLAT THEREOF. SAID LAND BEING IN THE CITY OF LAKE GENEVA, COUNTY OF WALWORTH AND STATE OF WISCONSIN.

SURVEY FOR: JOHN LAW OF RE/MAX GENEVA REALTY  
SURVEY ADDRESS: 300 LOOKOUT DRIVE, LAKE GENEVA, WI 53147


NOTE: REFER TO A CURRENT TITLE REPORT  
FOR EASEMENTS, RESTRICTIONS OR COVENANTS  
WHICH MAY AFFECT THIS PROPERTY.

LOT 91

East face of the wood  
retaining wall is 1.2' west  
of the property line.

145.17')  
145.24'

wood retaining wall 145.24'

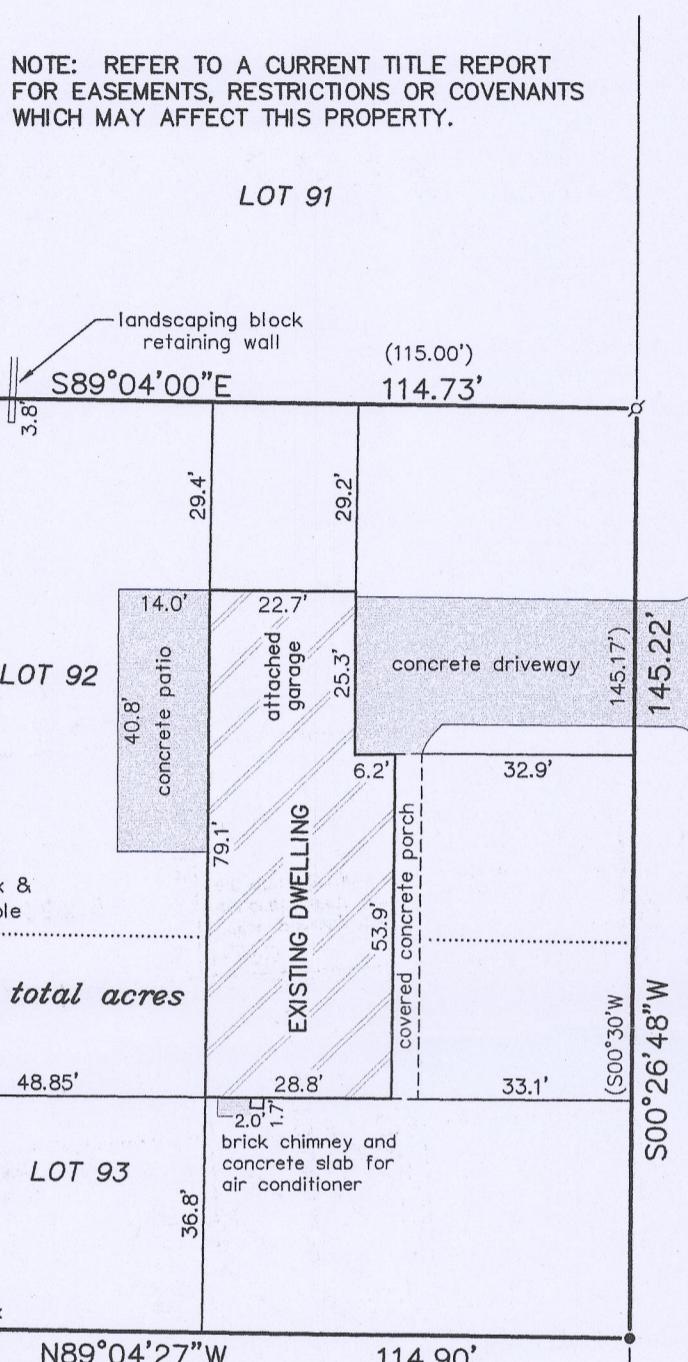

LOOKOUT DRIVE

East face of the wood  
retaining wall is 1.2' west  
of the property line.

East face of landscaping  
timbers is 1.8' west of  
the property line.

0.38 total acres

(N00°30'E  
N00°31'00"E

wood retaining wall 145.24'

East face of landscaping  
timbers is 0.6' east of  
the property line.

utility box

107.83'  
107.92'

utility box

N00°25'27"E  
(N00°30'E

wood retaining wall 145.24'







N