


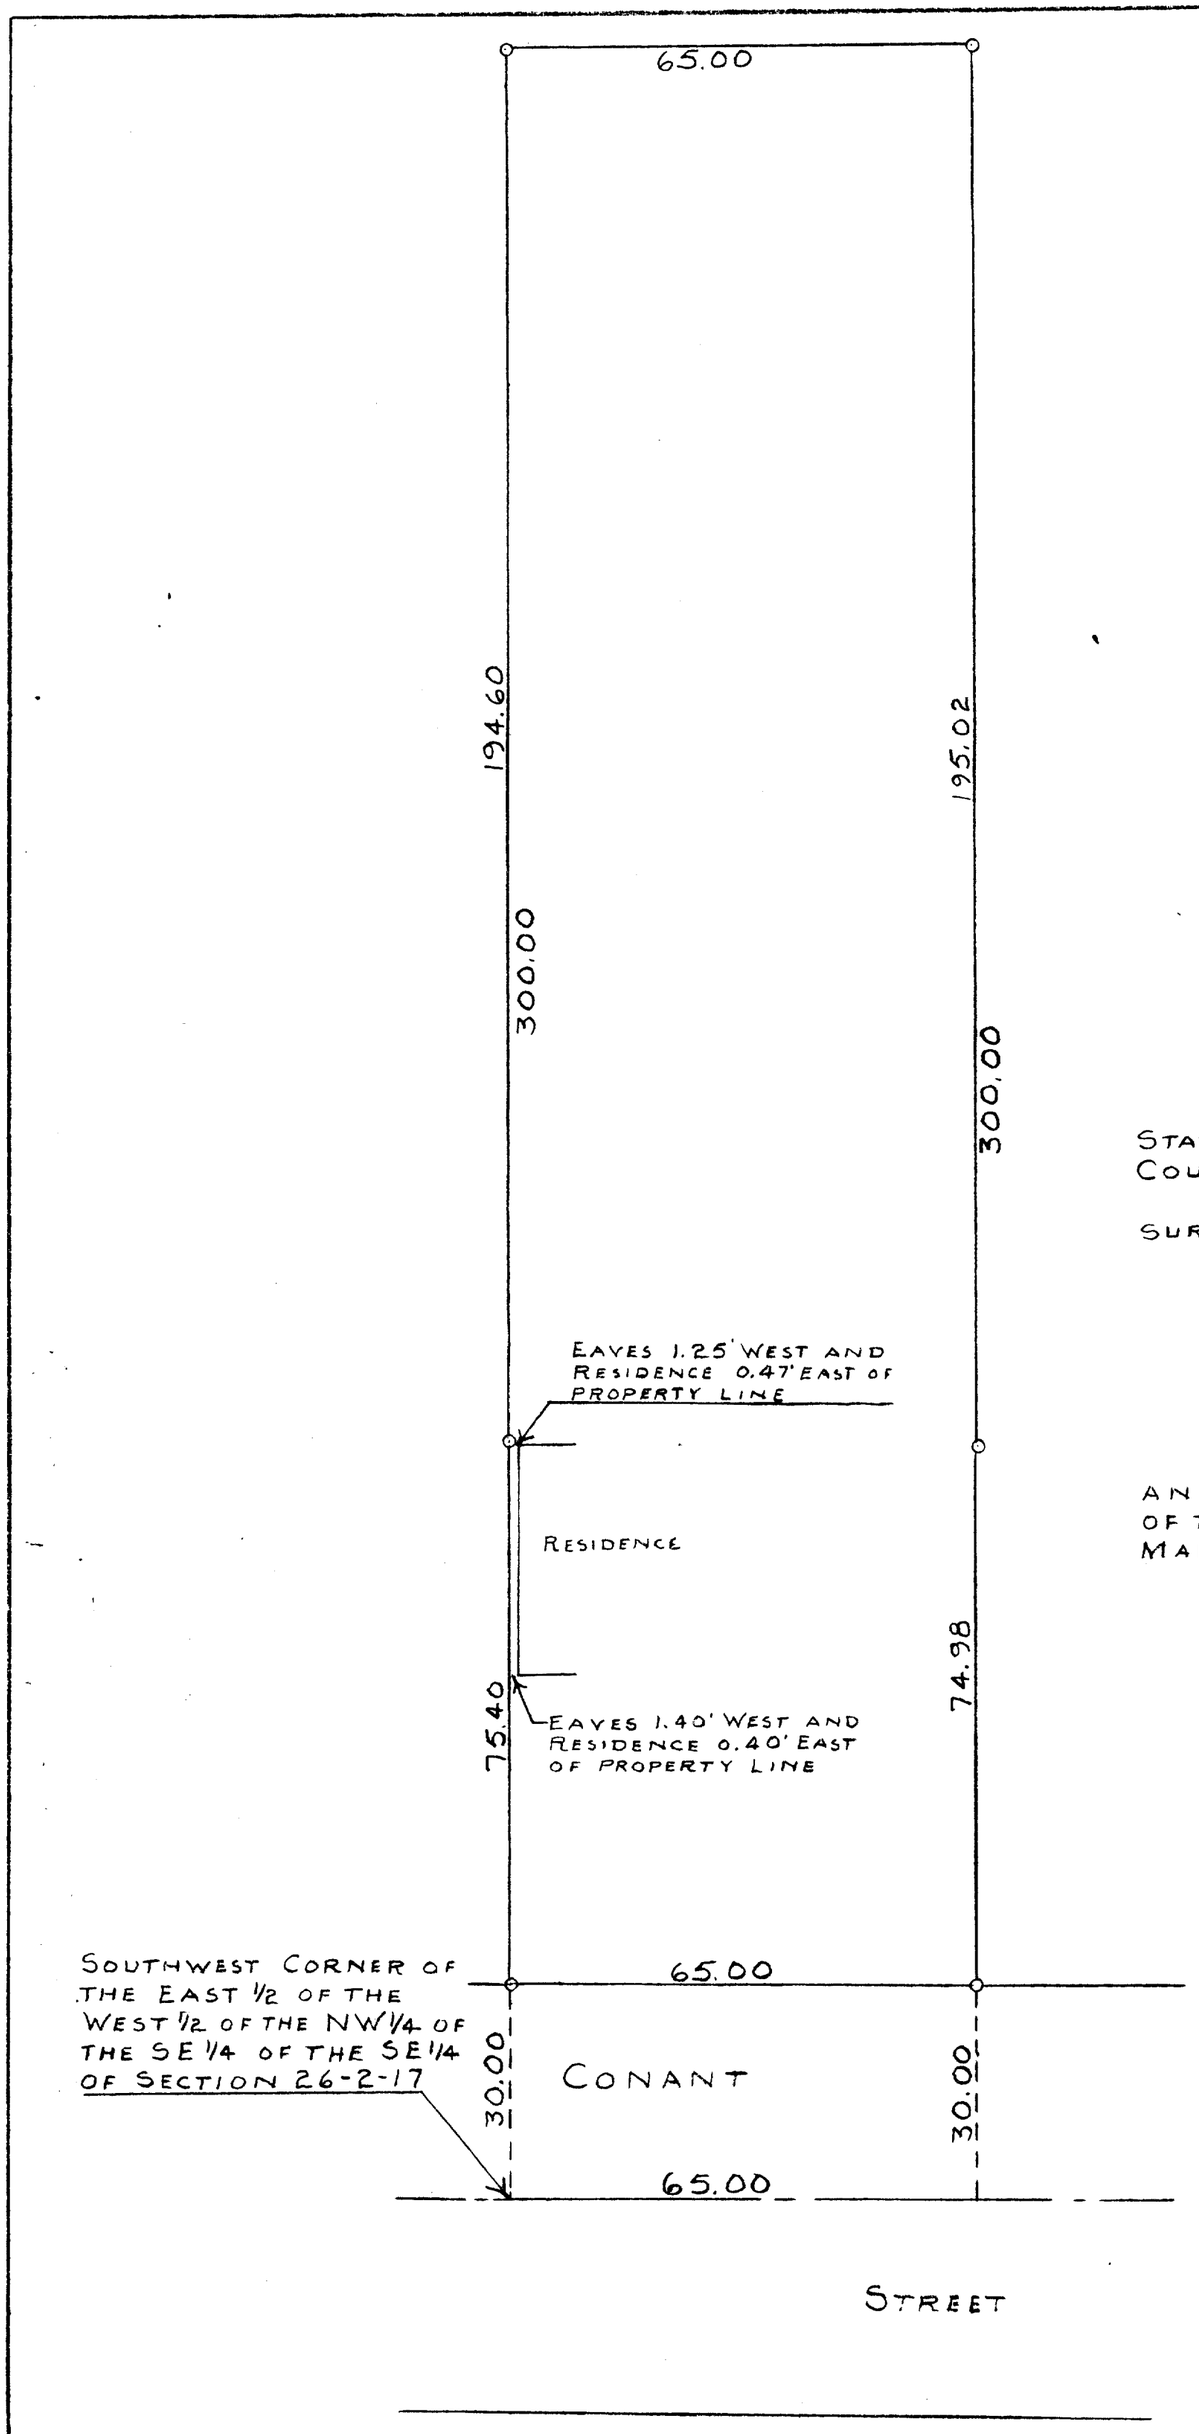

SCALE~1"=20'
O=IRON PIPE

STATE OF WISCONSIN) SS
COUNTY OF WALWORTH)

I, GEORGE T. DUNHAM, DO HEREBY CERTIFY THAT I HAVE SURVEYED THE PROPERTY DESCRIBED AS FOLLOWS:

A PARCEL OF LAND LOCATED IN THE E 1/2 OF THE W 1/2 OF THE NW 1/4 OF THE SE 1/4 OF THE SE 1/4 OF SECTION 26, T2N R17E OF 4TH P.M., WALWORTH COUNTY, WISCONSIN, DESCRIBED AS FOLLOWS, TO-WIT: BEGINNING AT THE SOUTHWEST CORNER OF SAID EAST 1/2; THENCE NORTH ALONG THE WEST LINE OF SAID EAST 1/2, 300.00 FEET; THENCE EAST PARALLEL TO THE SOUTH LINE OF SAID EAST 1/2, 65.00 FEET; THENCE SOUTH 300.00 FEET; THENCE WEST 65.00 FEET TO THE PLACE OF BEGINNING;

AND THAT THE PLAT SHOWN HEREON IS A CORRECT REPRESENTATION OF THE PROPERTY LINES.

MARCH 28, 1957

George T. Dunham

GEORGE T. DUNHAM
DELAVAN, WISCONSIN
WIS. LAND SURVEYOR NO S-306

7-33A

~~217 H~~

UP-473 (not on deed. on tax roll)