
60-45

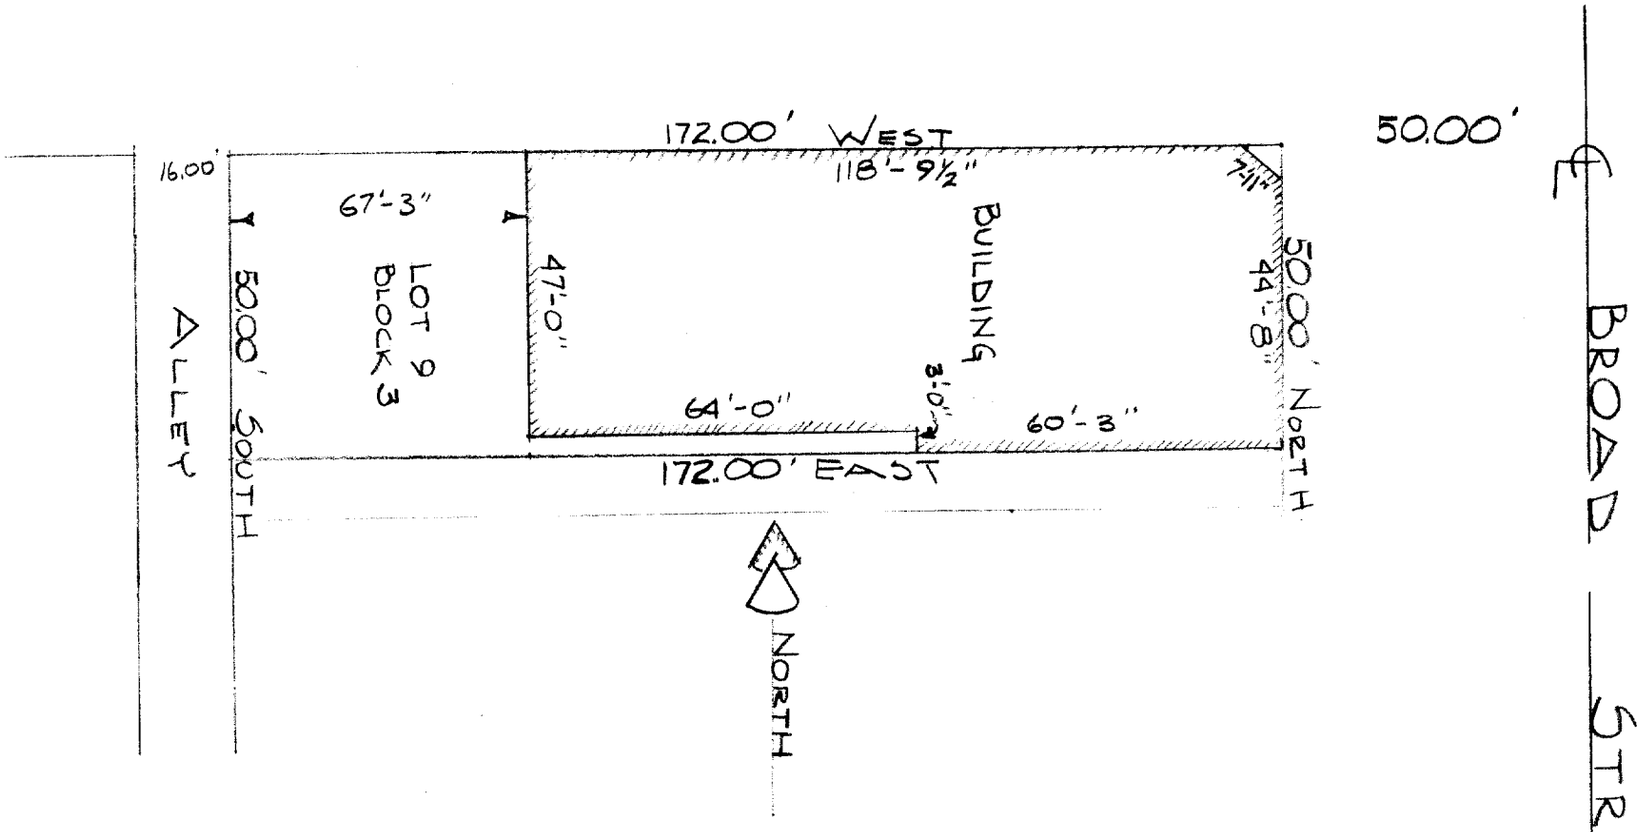

DESCRIPTION:

The north 50.00 feet of Lot 9, Block 3, Goodsell's Subdivision of Blocks 3 and 4, of the Original Plat of the Village (now city) of Lake Geneva, Walworth County, Wisconsin.

CERTIFICATE:

I, James F. Biagi, hereby certify that I, have surveyed the property hereon described, and that the location of all improvements are as shown hereon.

SIGNED AND SEALED ON THIS THE 16TH DAY OF AUGUST, 1960.

James F. Biagi. RLS 272
Elkhorn, Wisconsin.

7-34B