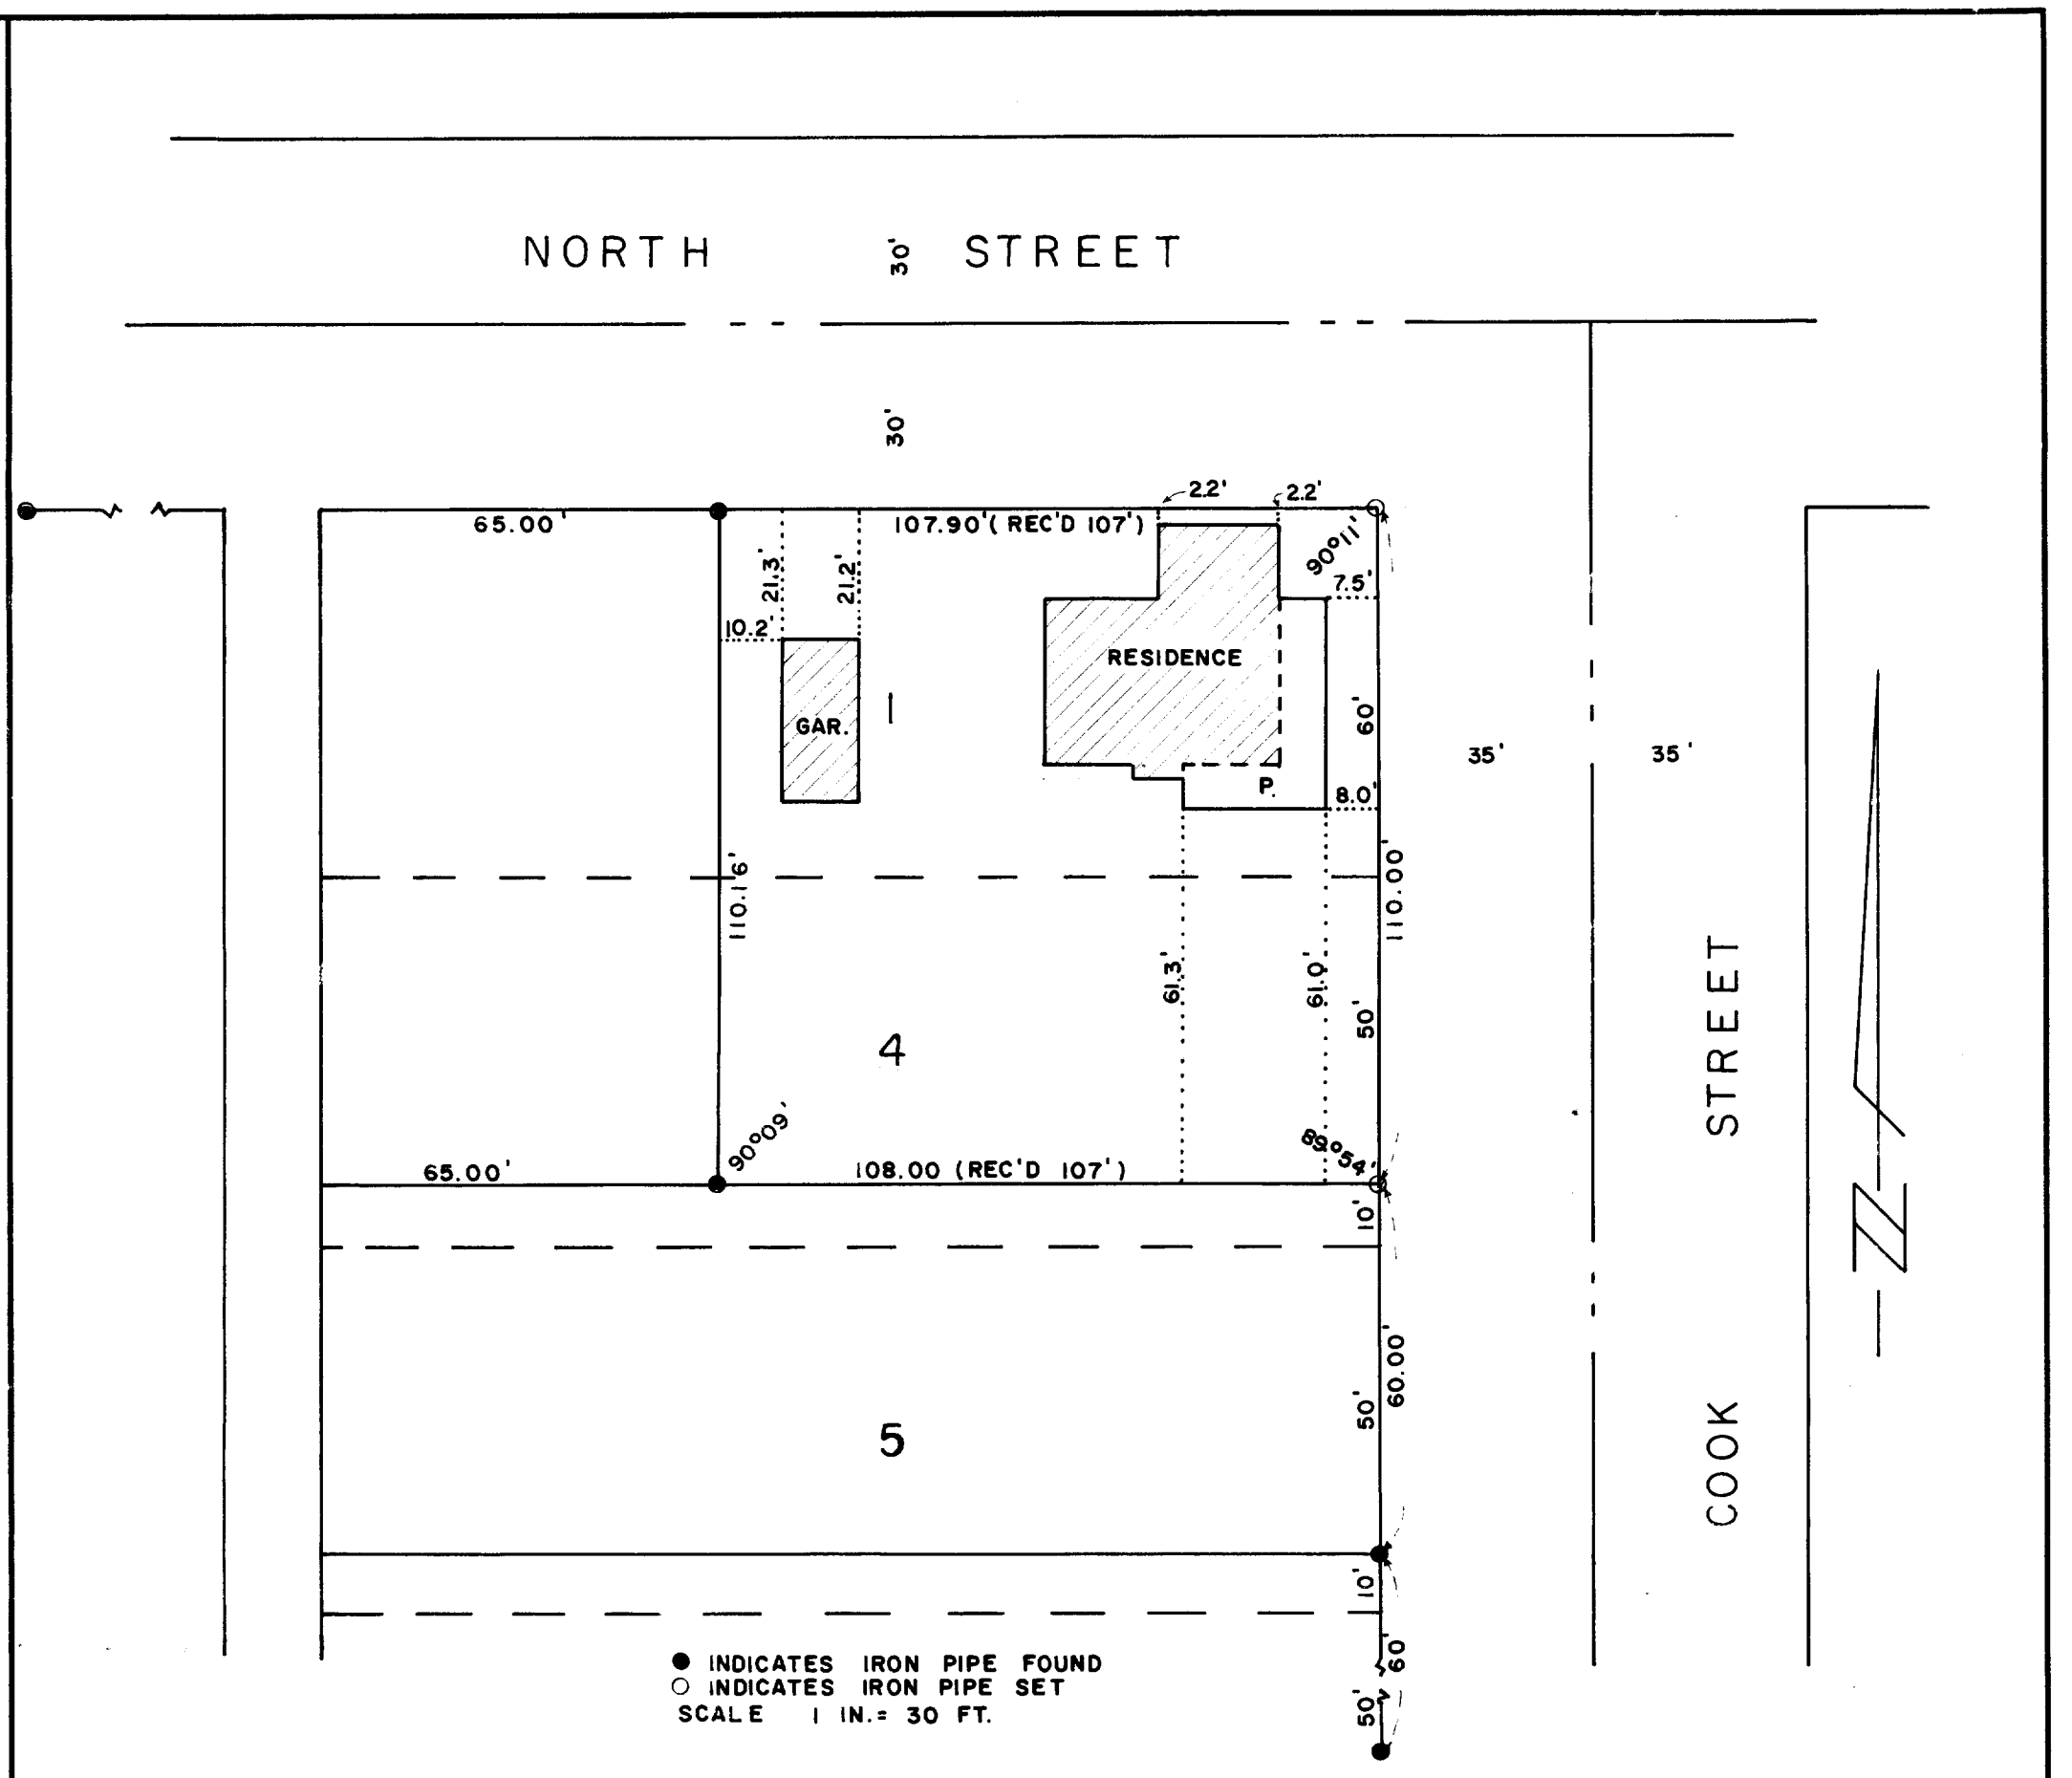


PLAT OF SURVEY OF

The East 107 feet of Lot 1, Block 4, and the East 107 feet of the North 50 feet of Lot 4, Block 4 Of Goodsell's Subdivision of Blocks 3 and 4 of the Original Plat of the City of Lake Geneva, Walworth County, Wisconsin.

CERTIFICATE

I, James F. Biagi, surveyor, do hereby certify that I have surveyed the lands hereon described, and that the improvements are as hereon shown.

December 6, 1971

James F. Biagi RLS 272

WISCONSIN JAMES F. BIAGI MILWAUKEE, WIS. LAND SURVEYOR

Part of Lots 1 and 4 of Block 4 of Goodsell's Subdivision of Blocks 3 and 4, Lake Geneva		
	SCALE 1"=30'	DRAWN BY ALB REVISED
DATE 12/6/71	APPROVED BY JFB	DRAWING NUMBER 218-71

GD-14+144

7-35B

MADE IN U.S.A. 28408