


DESCRIPTION OF A PIECE OF LAND SOLD BY DWIGHT ALLEN TO
ARTHUR LAWRIE.

39

The North 87 feet of Lot Twelve and the North 87 feet of the East 50 feet of Lot Eleven, Block 16, of the original Plat of Geneva, Village, now City of Lake Geneva, Wis. Iron stakes are set at the S.E.S.W. and N.W. Corners of said tract and a notch in the concrete driveway at the N.E. Corner.

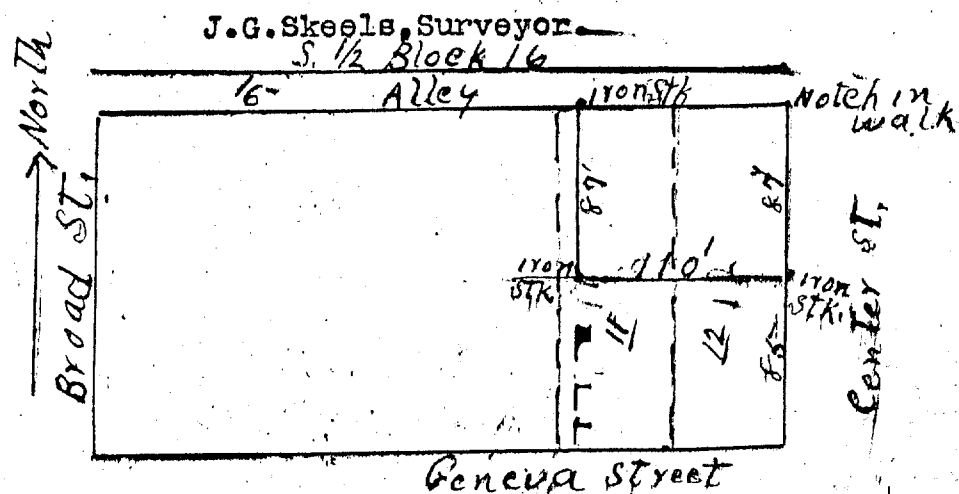

Parts of Lots 11 + 12 of Blk 16