50-20.

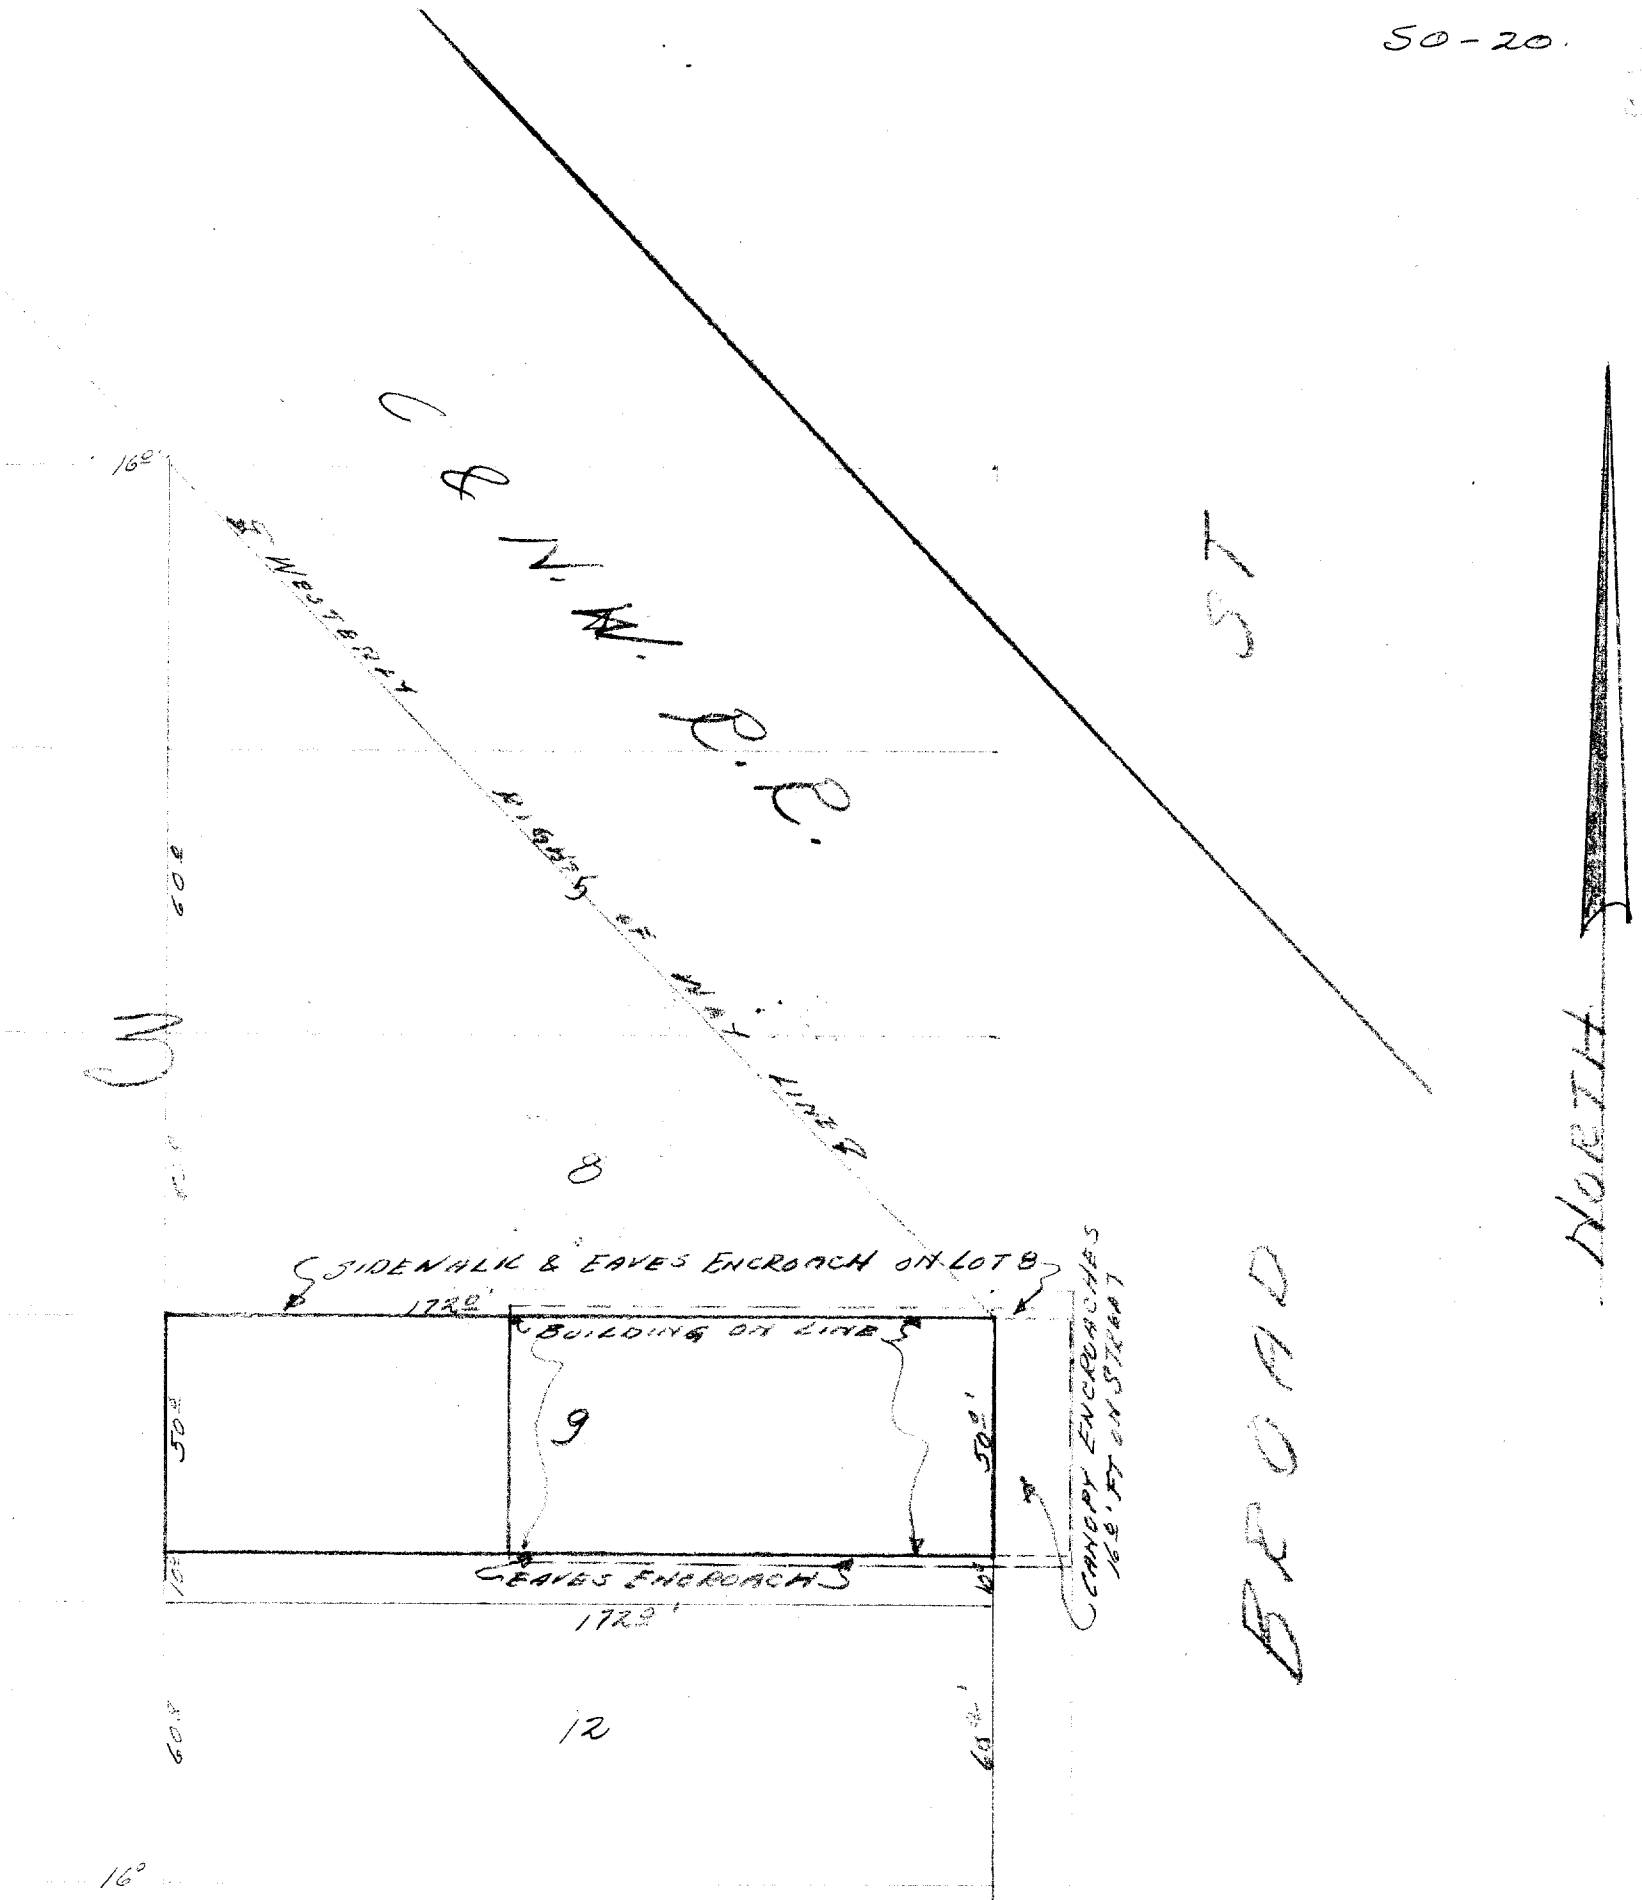

DESCRIPTION: THE north 50 feet of Lot 9, Block 3, Goodsell's Subdivision of Blocks 3 and 4 of the Original Plat of the Villa ge (now city) of Lake Geneva, Walworth County, Wisconsin.

CERTIFICATE: I, hereby certify that I have on this the 22nd day of April, 1950, surveyed the above described property according to the official records on file in the office of the Recorder of Deeds in and for Walworth County Wisconsin, and find that the measurements and bearings of the boundary lines of said property as taken at the site, on this day, substantially agree with those in said official plat, and that the eaves on both sides of the building encroach upon the adjacent property in an amount of 16 inches, and the canopy on Brod Street encroac hes upon the street by 16 feet.

SIGNED AND SEALED ON THIS THE 24TH day of A PRIL 1950.

Joseph M. Biagi. Professional Engineer.
Elkhorn Wisconsin.

G D-2

7-36 B