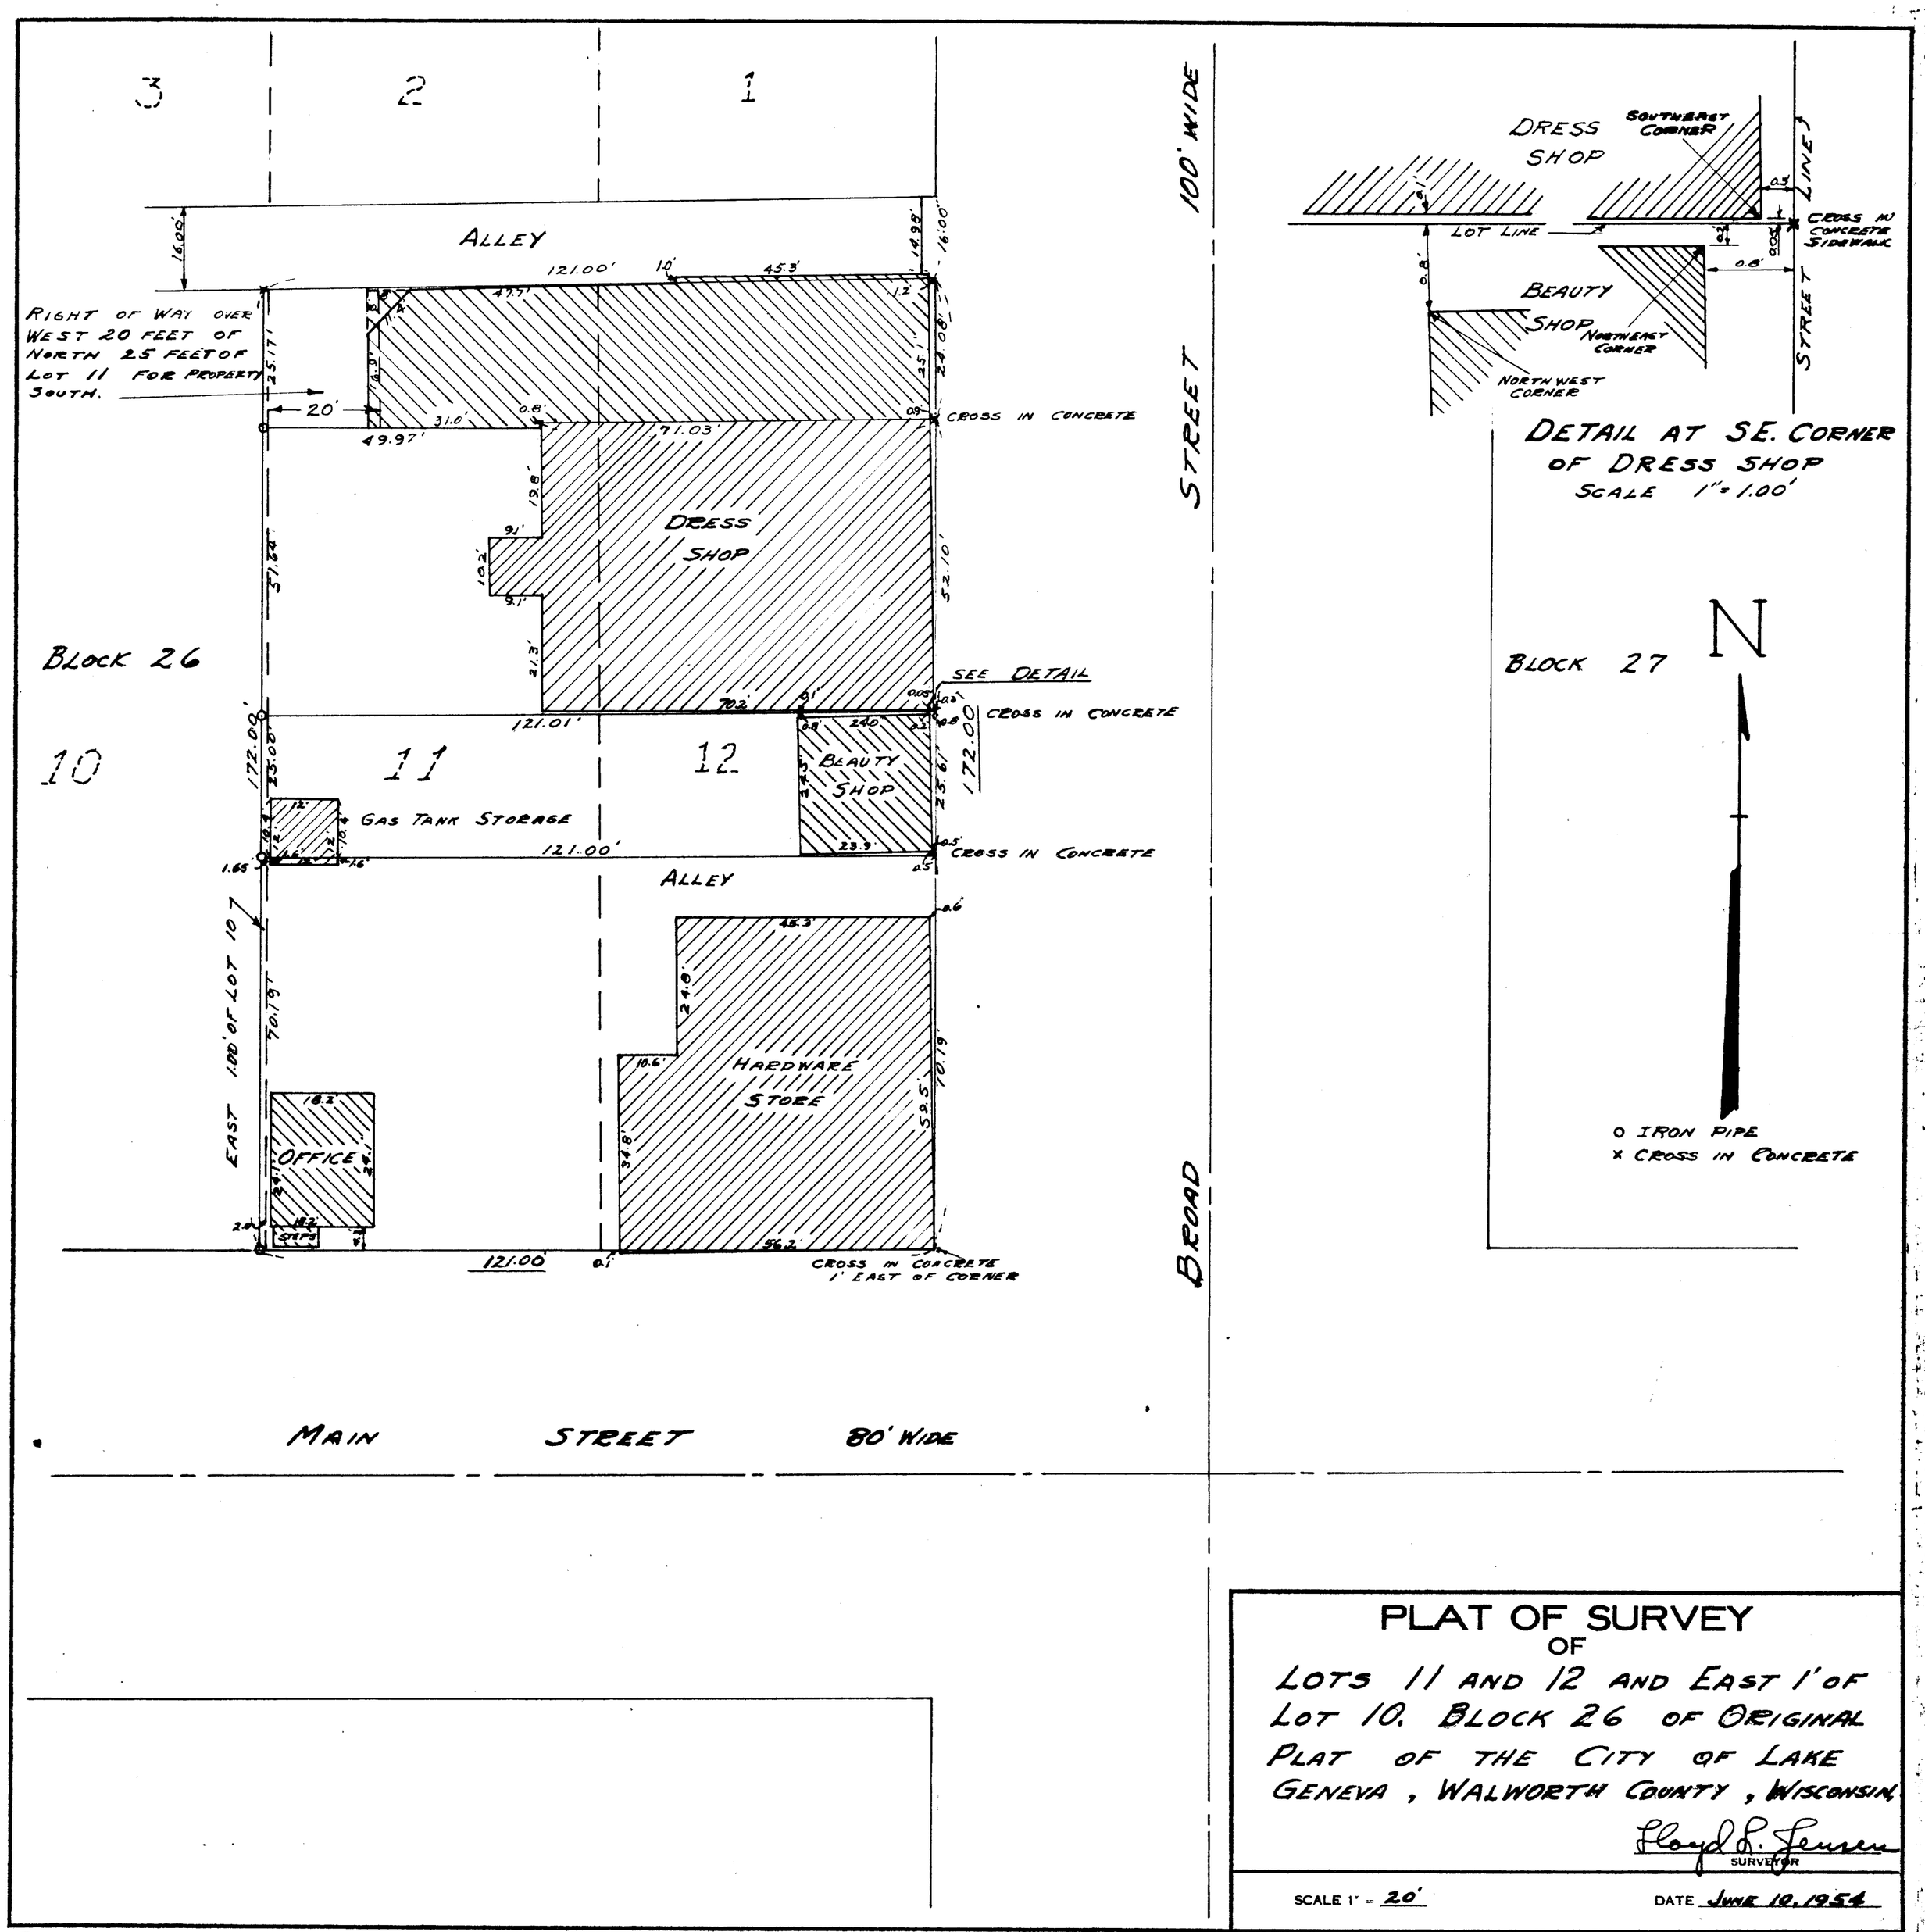

PLAT OF SURVEY
OF

LOTS 11 AND 12 AND EAST 1' OF LOT 10. BLOCK 26 OF ORIGINAL PLAT OF THE CITY OF LAKE GENEVA, WALWORTH COUNTY, WISCONSIN.

Floyd P. Jensen
SURVEYOR

SCALE 1" = 20'

DATE June 10, 1954

NO. 1771H—400—3-10-53

OP-256 +2060

7-36 J