
#884-69

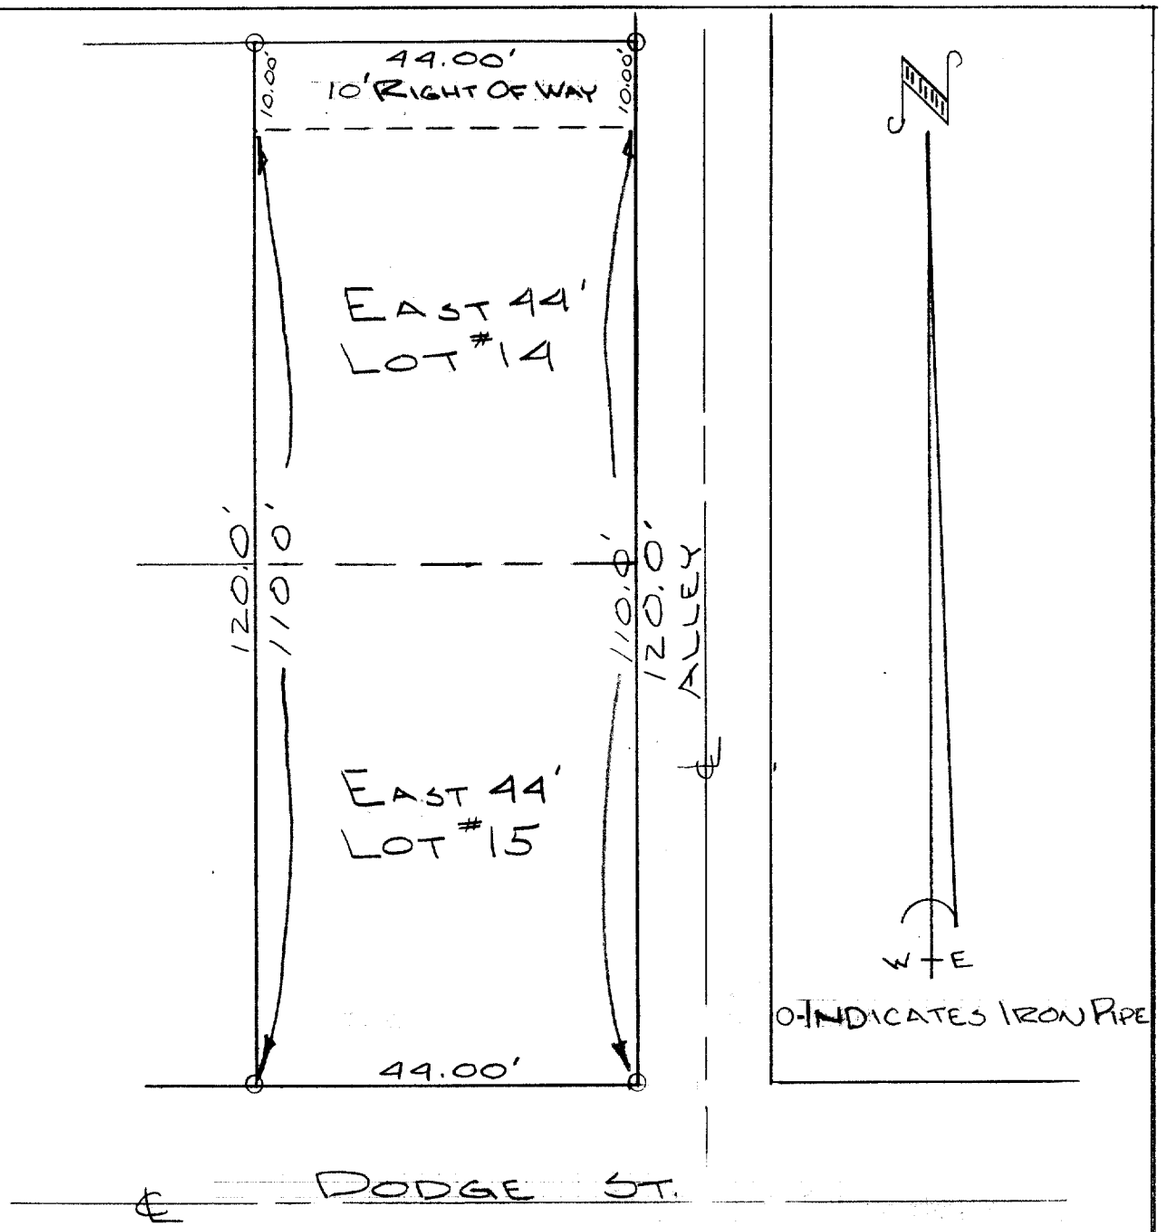

DESCRIPTION: The East 44.00 feet of Lots 14 and 15 of Block 3 of Goodsell's Subdivision of Block 3 of the Village, now City, of Lake Geneva, Walworth County, Wisconsin, excepting therefrom a right of way over the north 10.00 feet of the above described.

CERTIFICATE: I, James F. Biagi, surveyor, do hereby certify that I have surveyed the property hereon described.

June 25, 1969

WISCONSIN
JAMES F.
BIAGI
MILWAUKEE
WIS.
LAND SURVEYOR

James F. Biagi, R.L.S. 272

7-37B

GD-12