61-8

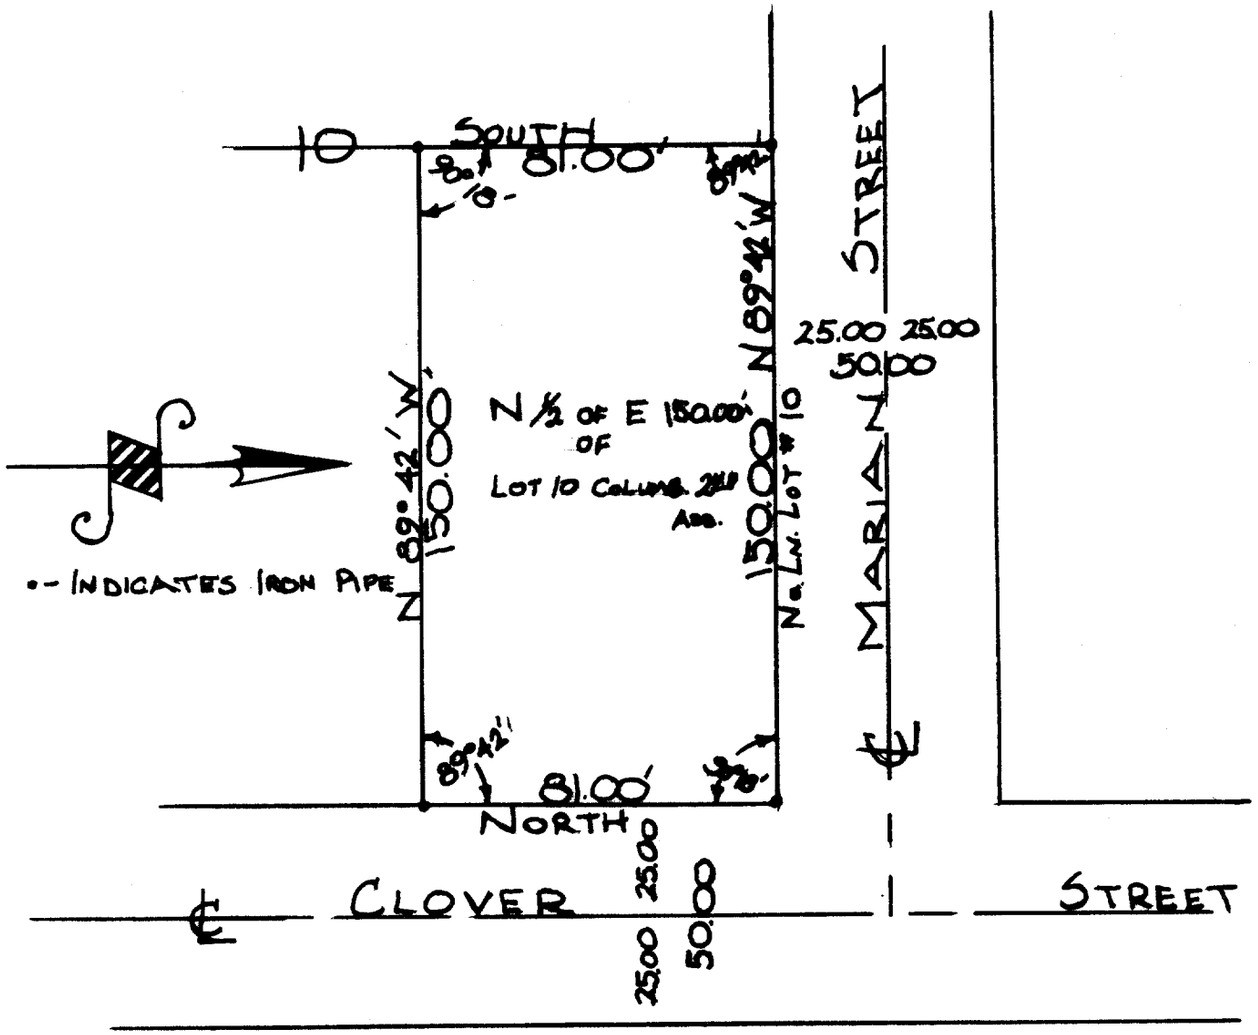

DESCRIPTION:


CERTIFICATE:

I, hereby certify, that I, James F. Biagi, have surveyed the property hereon described, on this the 25th day of November, 1961.

Signed and sealed on this the 25th day of November 1961.

WISCONSIN JAMES F. BIAGI MILWAUKEE, WIS. LAND SURVEYOR

James F. Biagi. (RLS 272)
Elkhorn. Wisconsin.

CL2 - 6B

7-37B