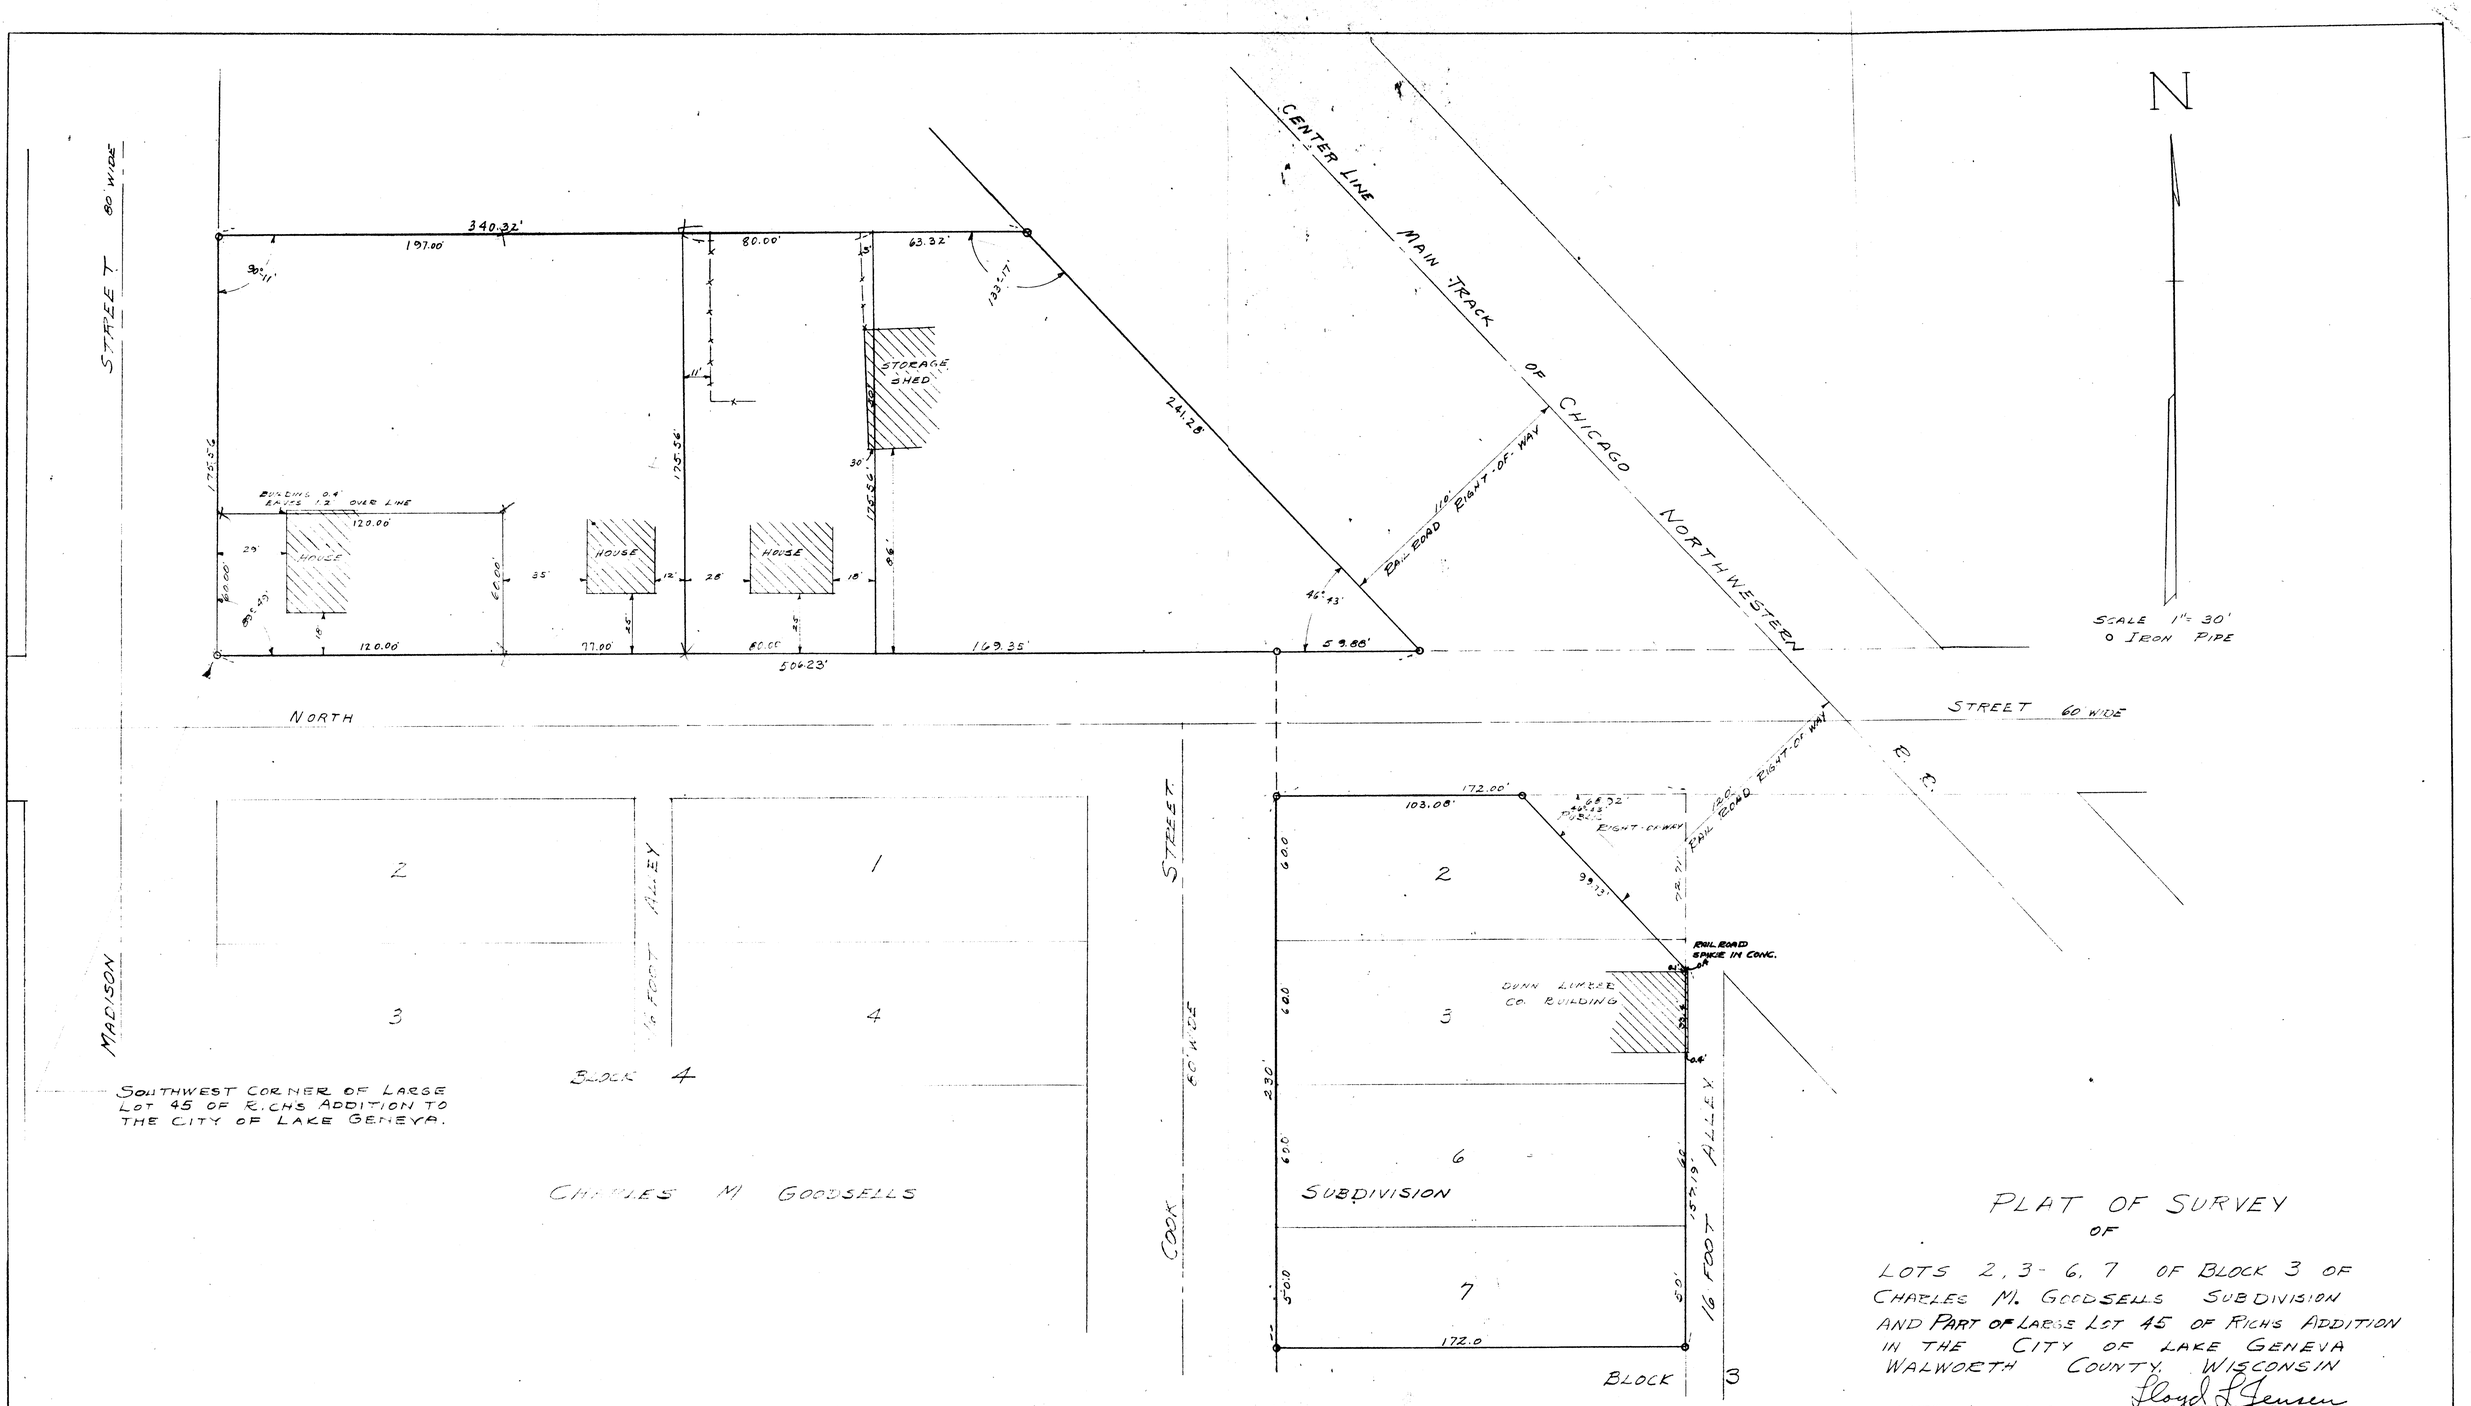

PLAT OF SURVEY

OF

LOTS 2, 3 - 6, 7 OF BLOCK 3 OF CHARLES M. GOODSELLS SUBDIVISION AND PART OF LARGE LOT 45 OF RICHS ADDITION IN THE CITY OF LAKE GENEVA WALWORTH COUNTY, WISCONSIN

DATE JUNE 10, 1954

Floyd L. Jensen
WALWORTH COUNTY SURVEYOR

00 7375